


I hereby certify to Aetna Life Insurance Company; Thomas K. Standish; Chicago Title Insurance Company and Equitable Bank Limited that the survey prepared by me entitled "Map Showing Property of THOMAS K. STANDISH HARTFORD SQUARE EAST Hartford, Conn." was actually made upon the ground and that it and the information, distances and bearings shown thereon are correct; that the title lines and lines of actual possession are the same; that the size and location of buildings are as shown and all are within the boundary lines of the property; that there are no violations of zoning or ordinances, restrictions or other rules and regulations with reference to the location of said buildings; that there are no encroachments, encroachments or uses affecting this property appearing from a careful physical inspection of the same, other than those shown and depicted thereon; and that the parcels described hereon do not lie within flood hazard areas in accordance with the document entitled "Department of Housing and Urban Development, Federal Insurance Administration - Special Flood Hazard Area Maps."

[Signature]

RECEIVED
DEC 11 1982
TOWN & CITY
VOL PAGE

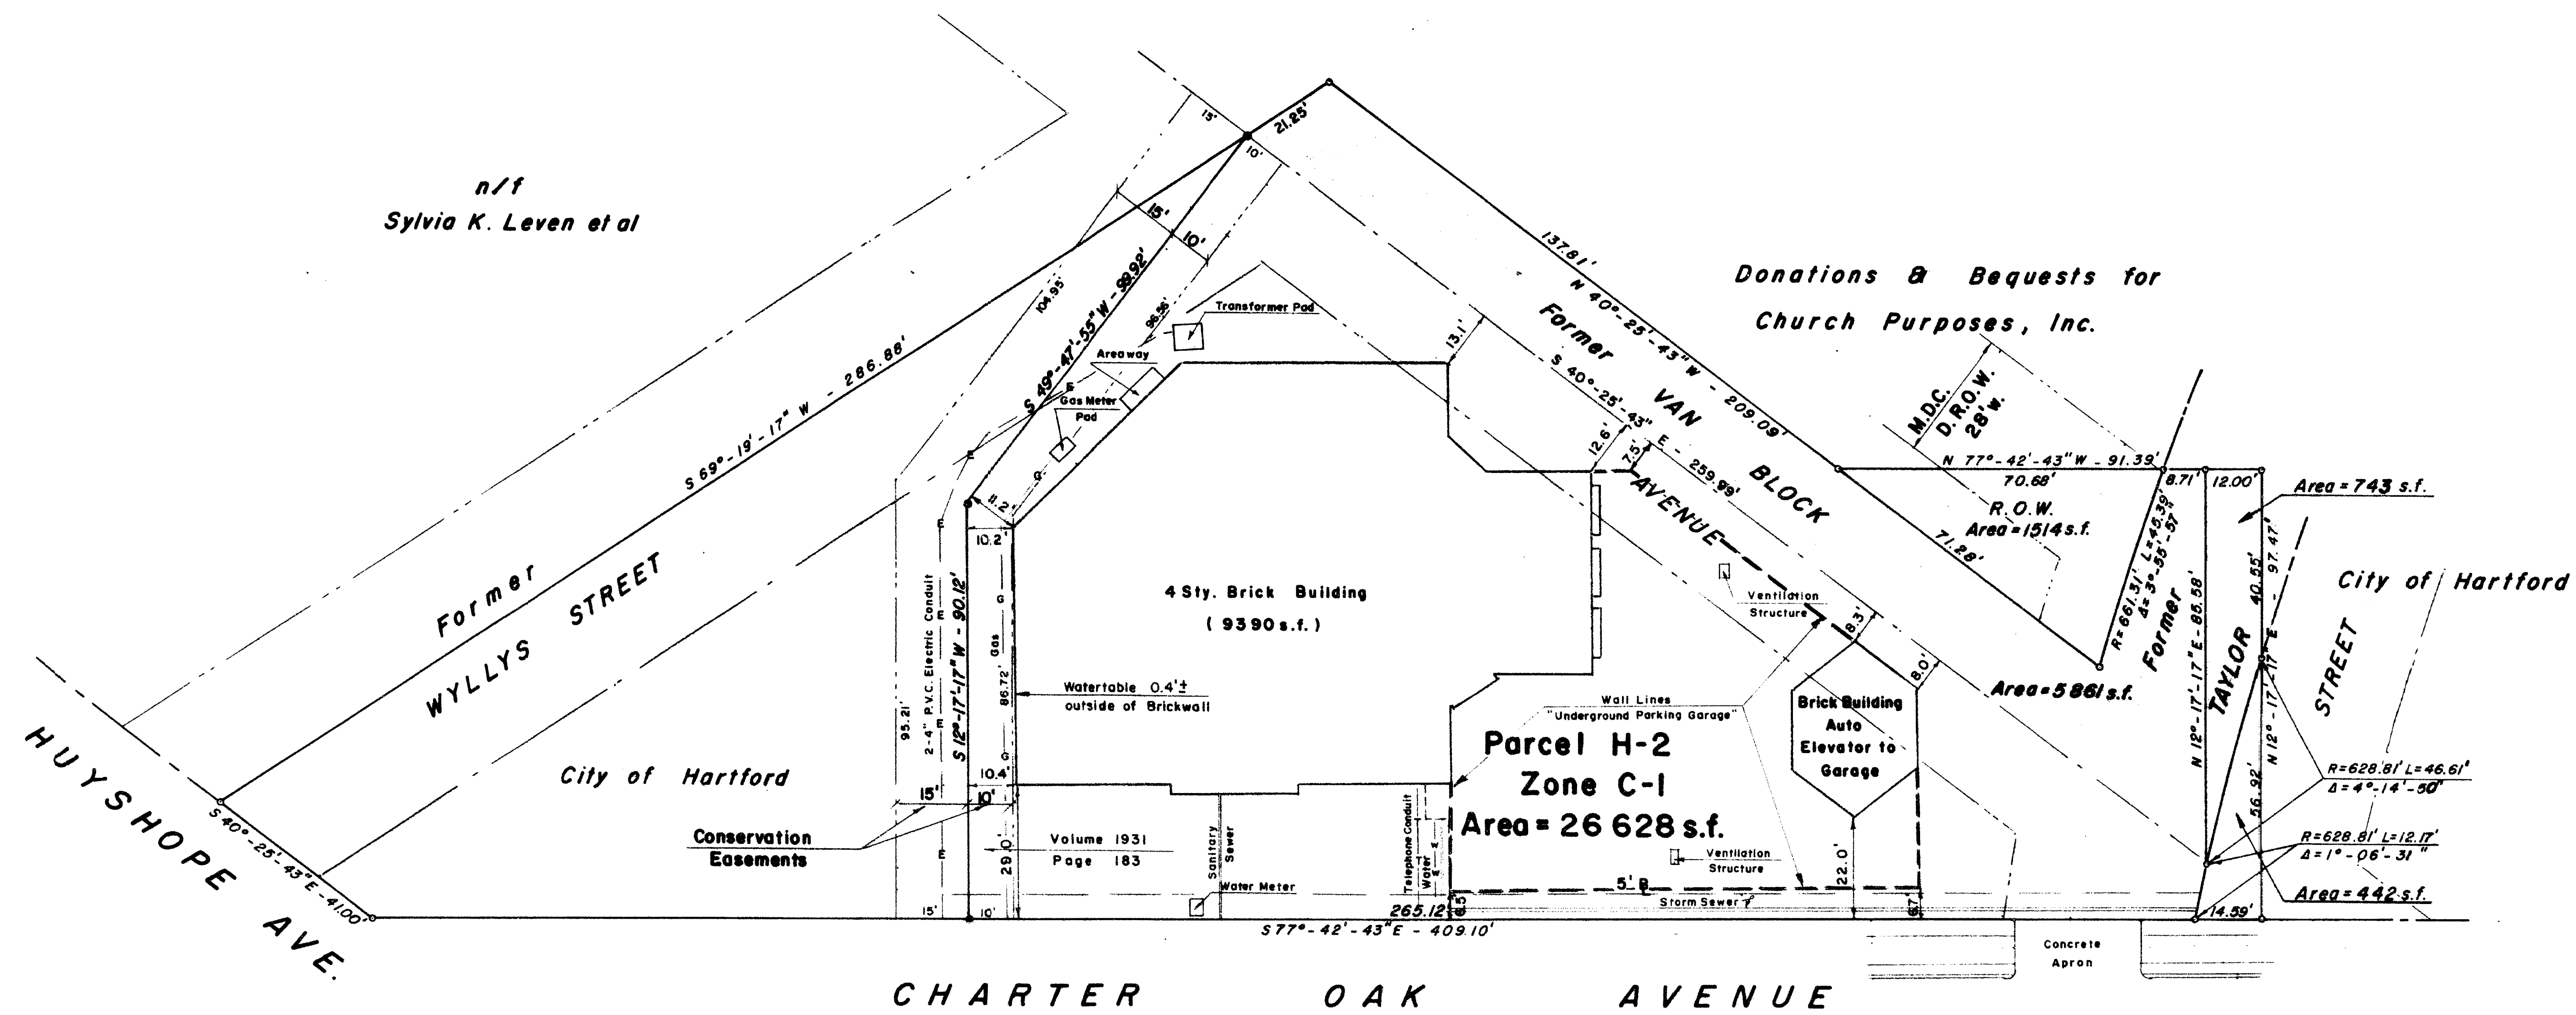

1239

GENERAL NOTES:


1. Former Van Block Avenue and former Taylor Street are subject to possible Utility Easements.
2. The offsets for building location refer to corners of brick walls.
3. Location of all underground utility lines, except electric, is shown being based on map entitled "Hartford Square East, Property of Thomas K. Standish Charter Oak Avenue Hartford, Connecticut Scale 1"=20' Date 21 Dec. 81 by Helliway & Hesbert".
4. The location of primary service is shown being based on map entitled "Charter Oak Ave. No. 4A The C.L. and P. Co. and R.L.L. Co. Scale 1"=40' Date January 29, 1982 Revised 3-30-82".

The portions of Huyshope Ave. and Charter Oak Ave. shown on this plan are established public streets of the City of Hartford.

12/17/82
Date

[Signature]
City Engineer

I HEREBY CERTIFY THAT THIS MAP AND SURVEY WERE PREPARED IN ACCORDANCE WITH THE STANDARDS OF A CLASS A SURVEYOR AS DEFINED IN THE CODE OF PRACTICE FOR STANDARDS OF ACCURACY OF SURVEYS AND MAPS, ADOPTED DECEMBER 10, 1975 AS AMENDED BY THE ASSOCIATION OF LAND SURVEYORS, INC.

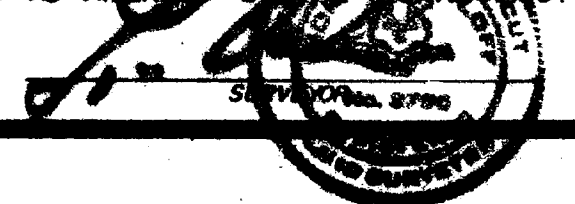

Map Showing Property of
THOMAS K. STANDISH
HARTFORD SQUARE EAST
Hartford, Conn.

Property to be conveyed
by Donations & Bequests
for Church Purposes, Inc.,
to Thomas K. STANDISH
Hartford, Conn.

11-12-82 Loc. of U.G. Garage
11-5-82 Addit. Info.
10-27-82 Revised

IGOR VECHESSLOFF
PROFESSIONAL ENGINEER & LAND SURVEYOR
51 LORRAINE STREET
HARTFORD, CONNECTICUT
SCALE 1" = 20' DATE 8-16-82
DRAWING NO. 1933

1239

