


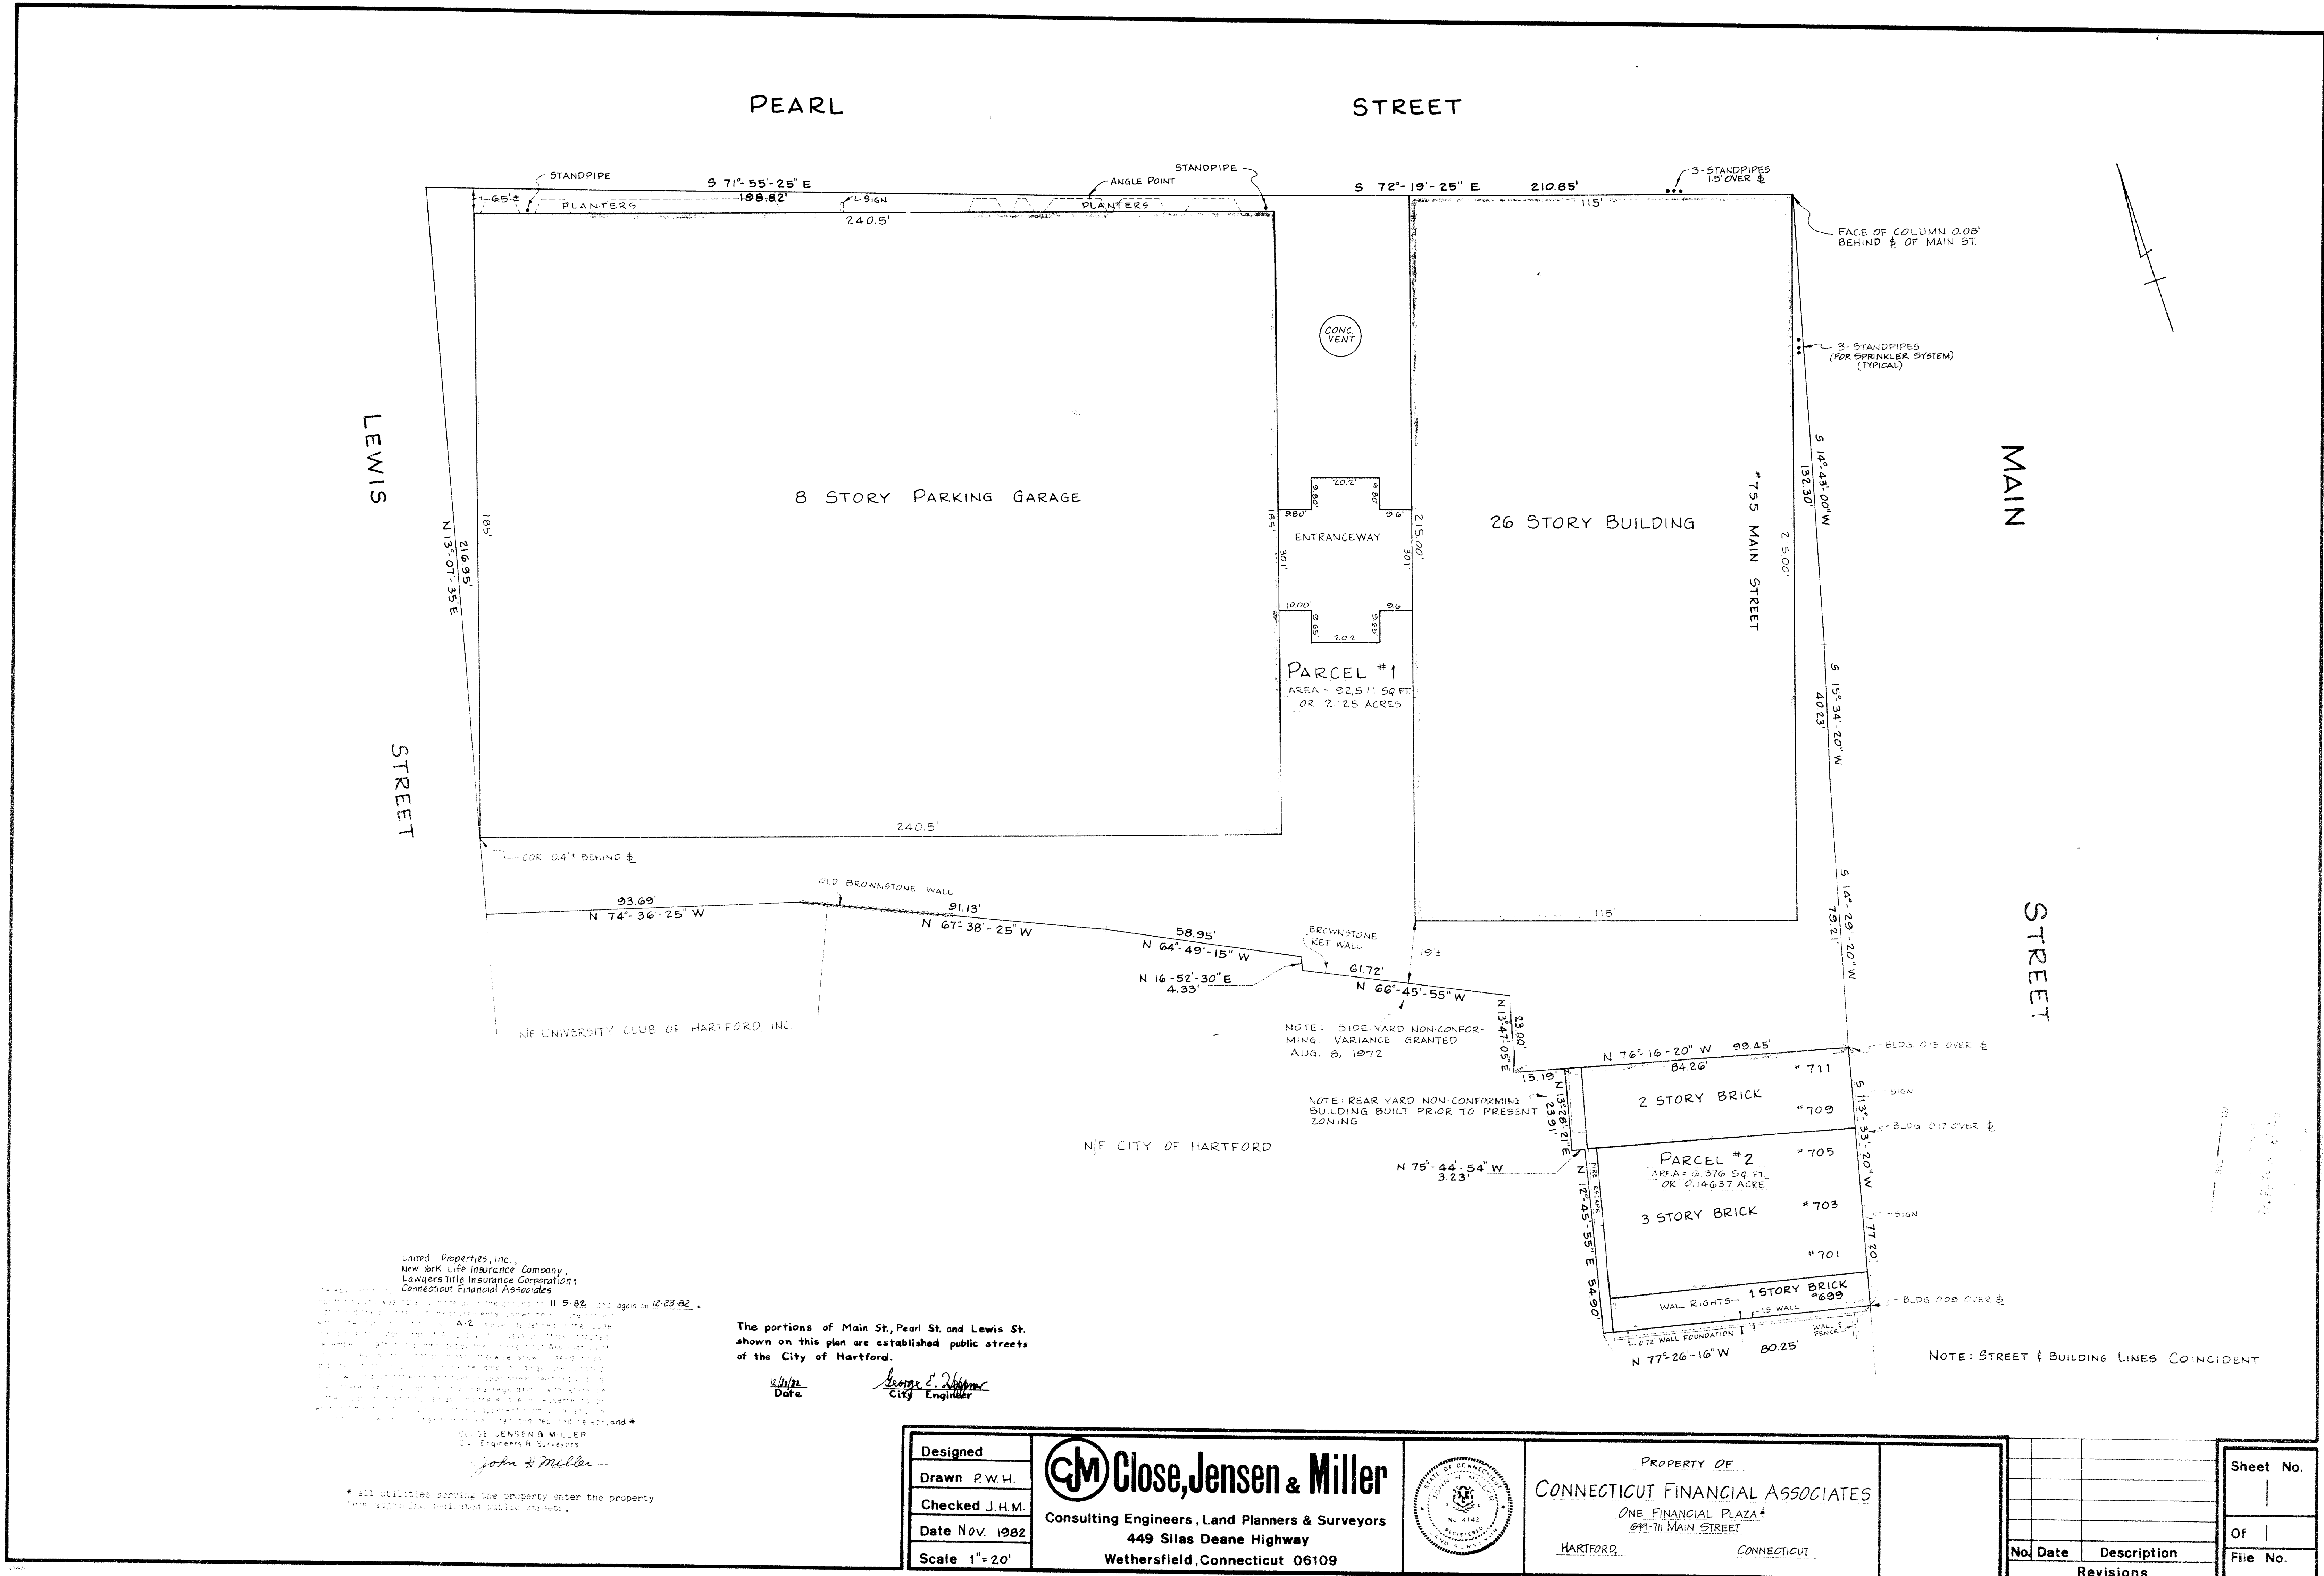

1242

0 INCHES 1 2 3 4