


EAST FILE CORP IRVINE CA EPH 34
1245

1245-1

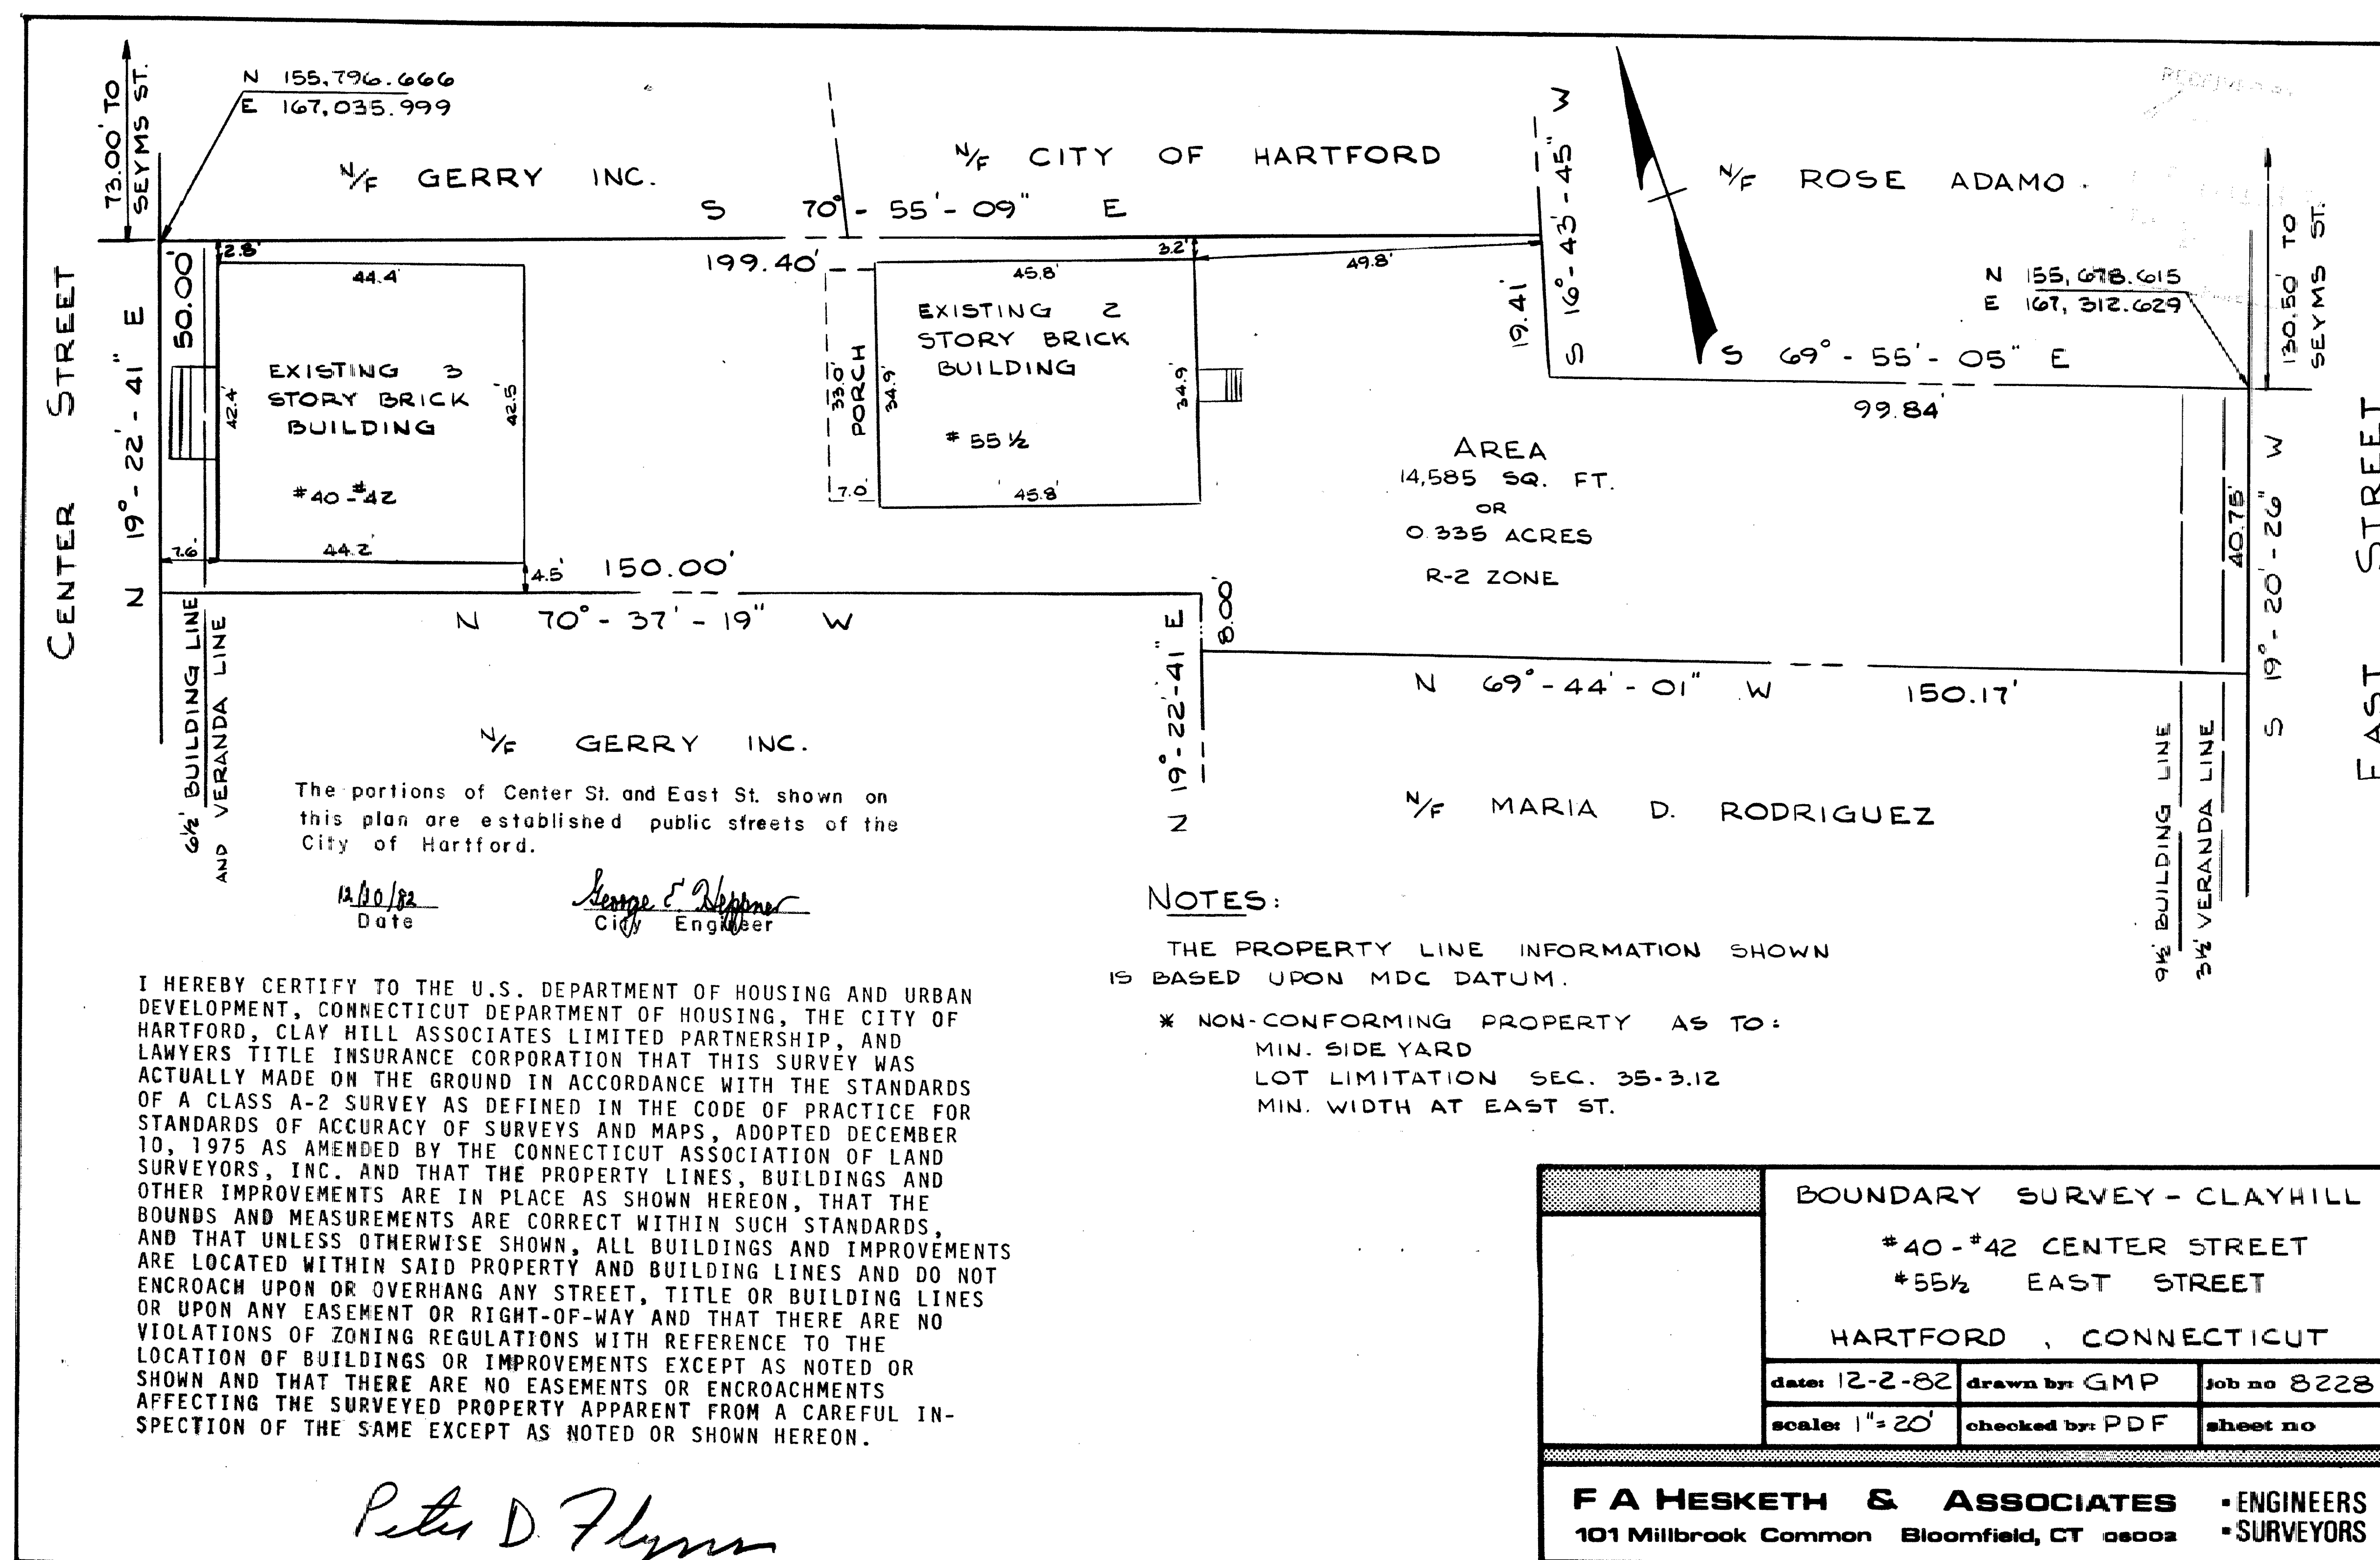

1245

0 INCHES 1 2 3 4