


Peter D. Flynn

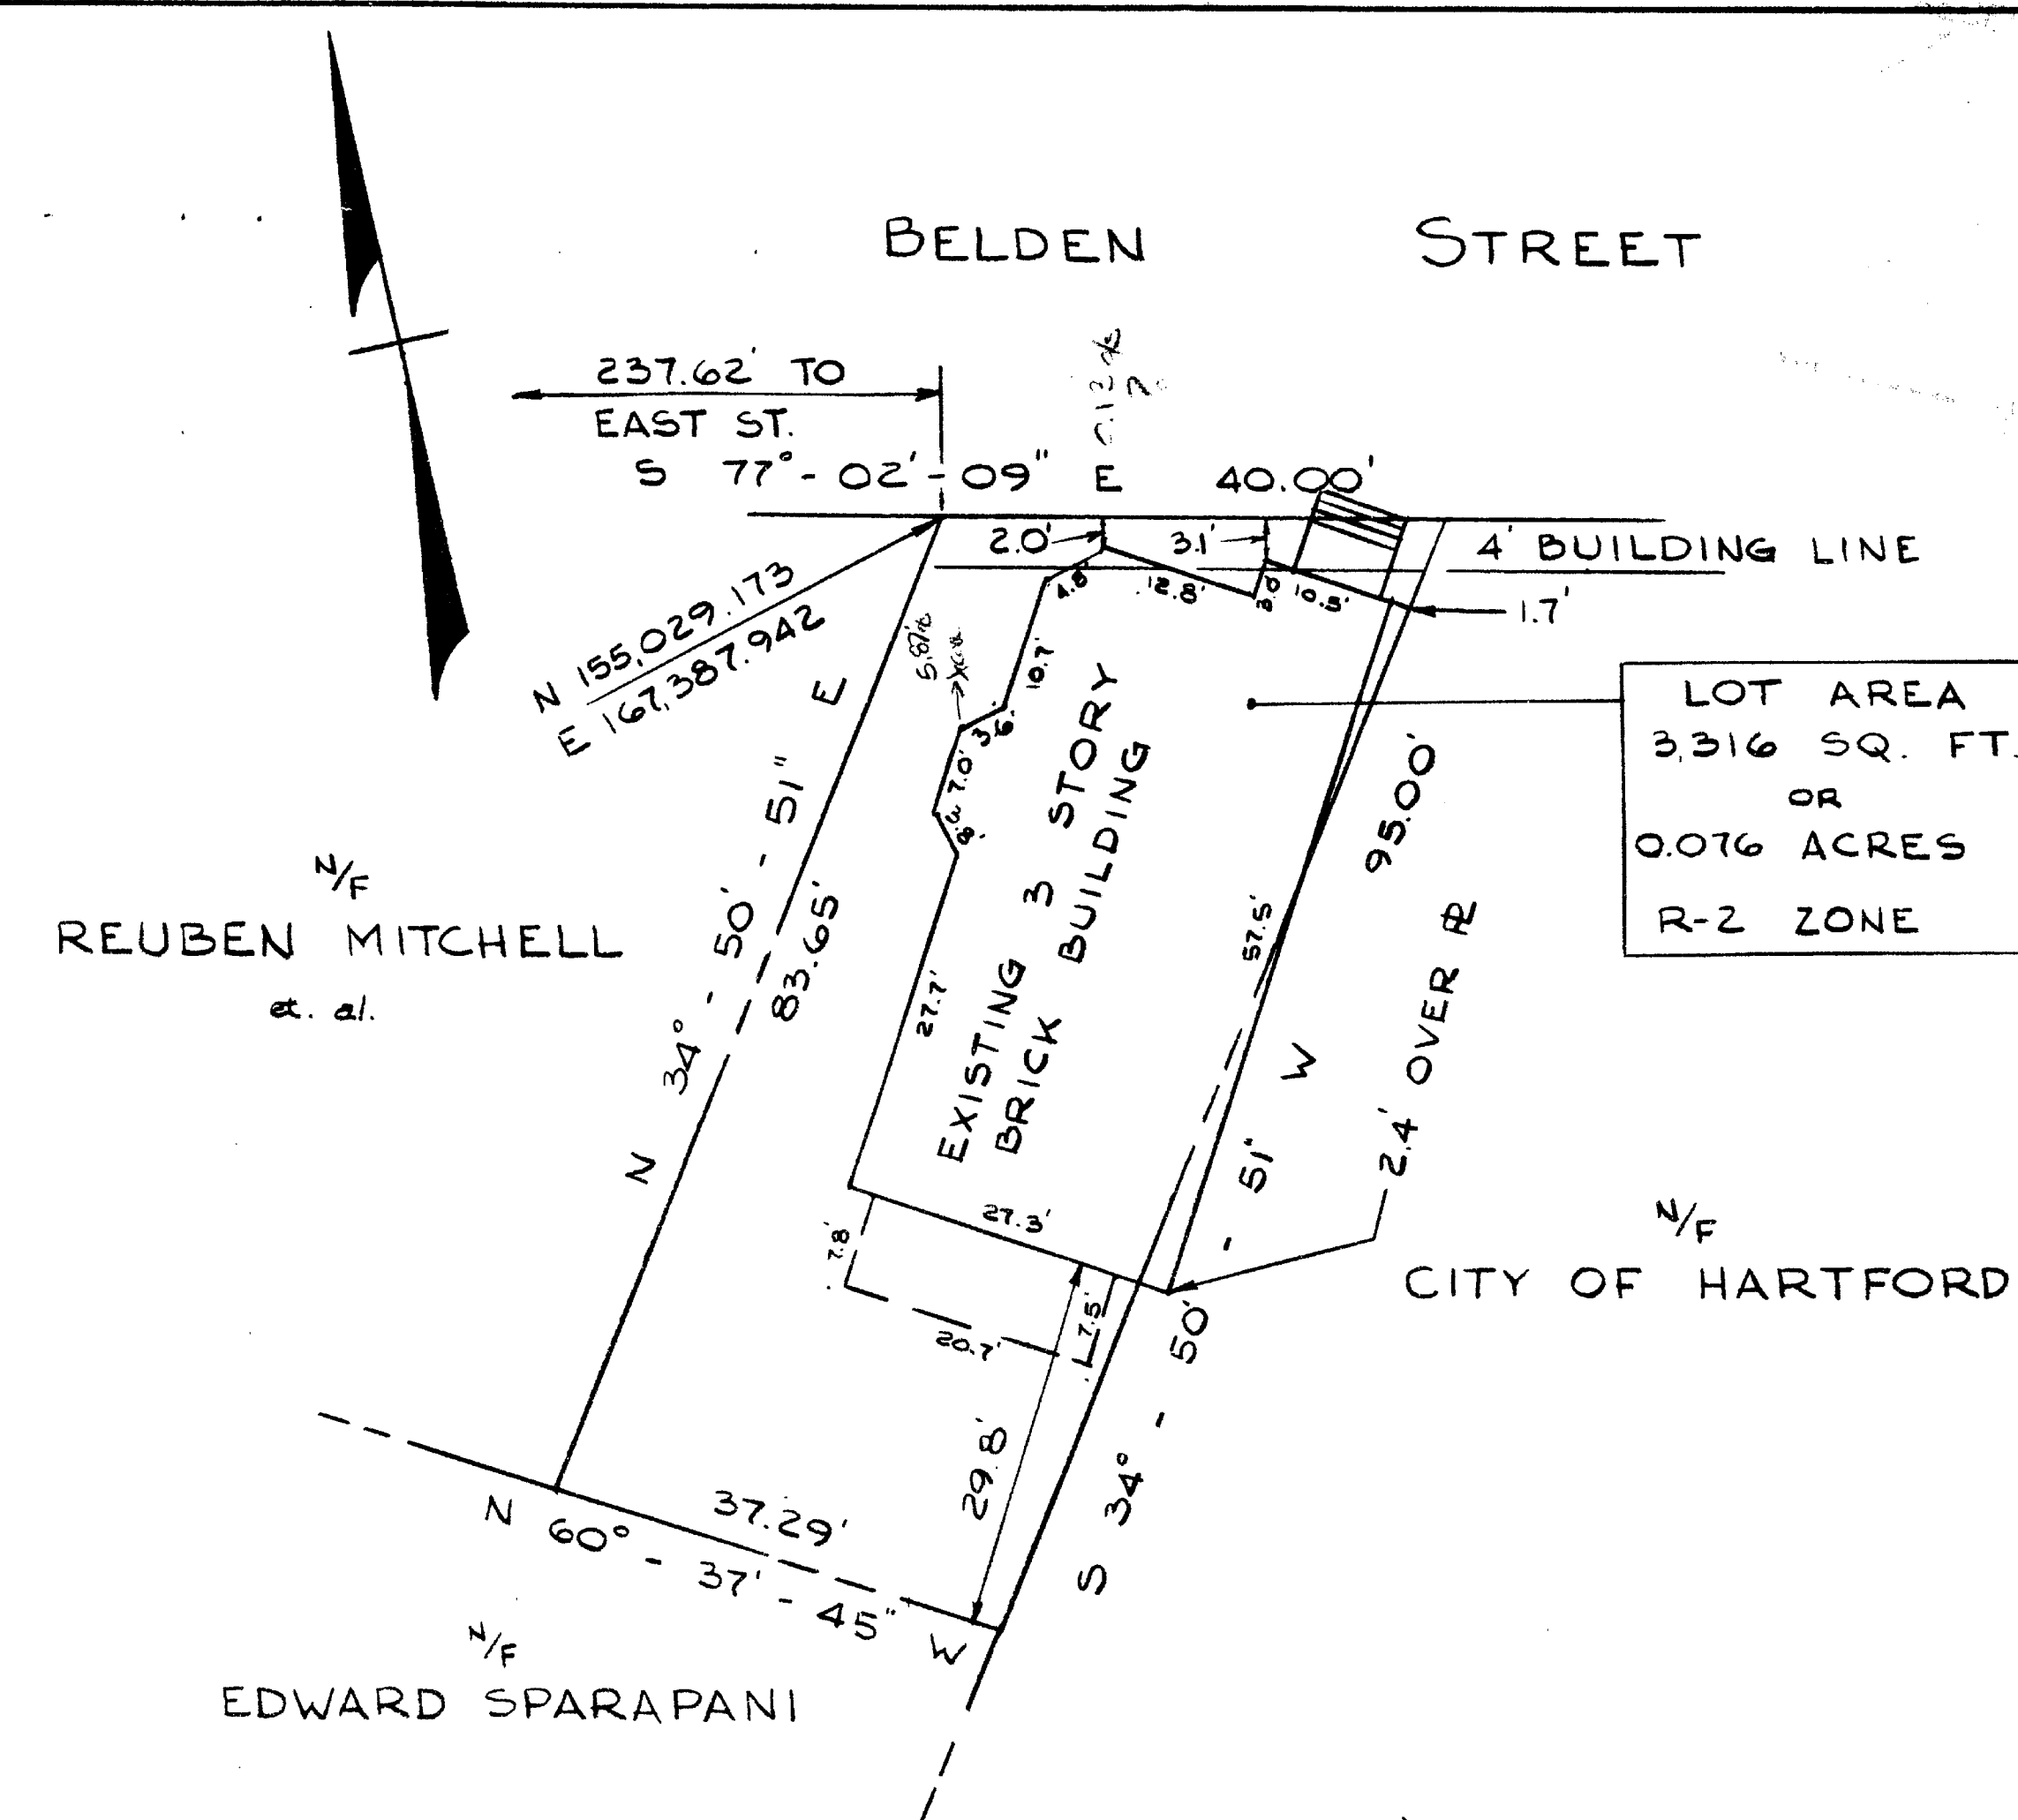

F A HESKETH & ASSOCIATES
101 Millbrook Common Bloomfield, CT 06002

- ENGINEERS
- SURVEYORS