
EASI FILE CORP IRVINE CA EFH 34

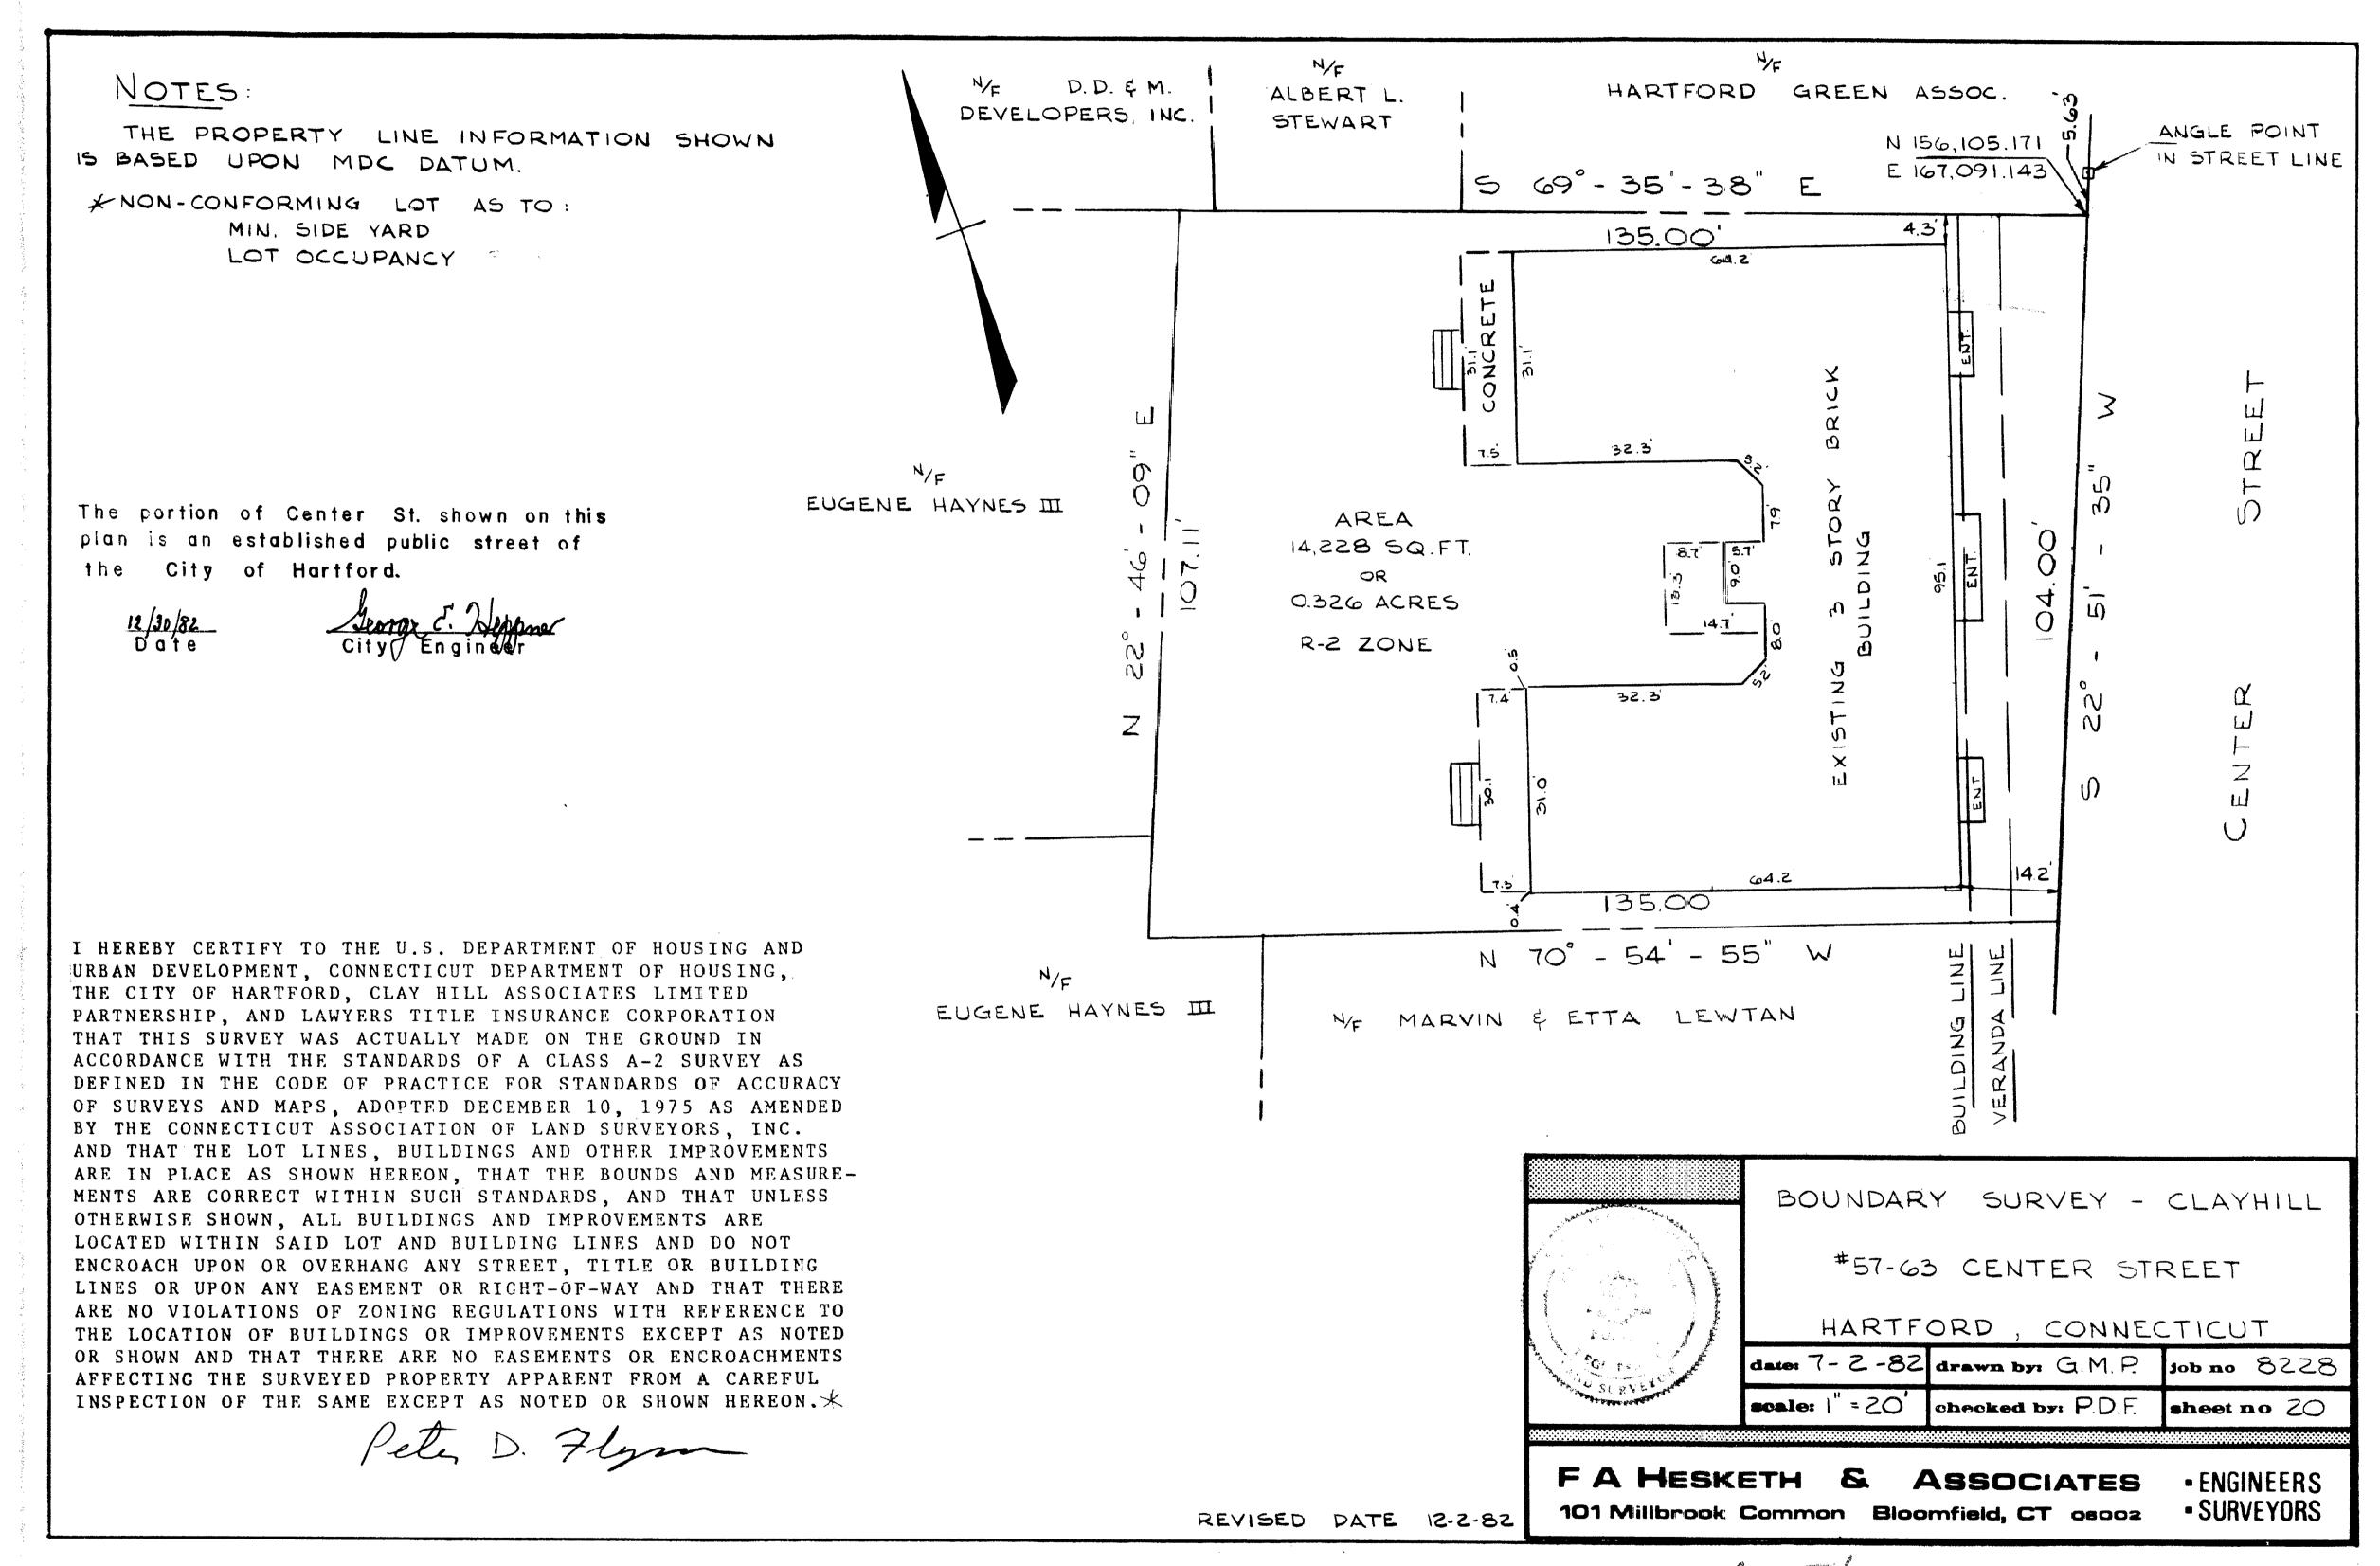

135/