
EASI FILE CORP. IRVINE CA EFH 34

1252-3

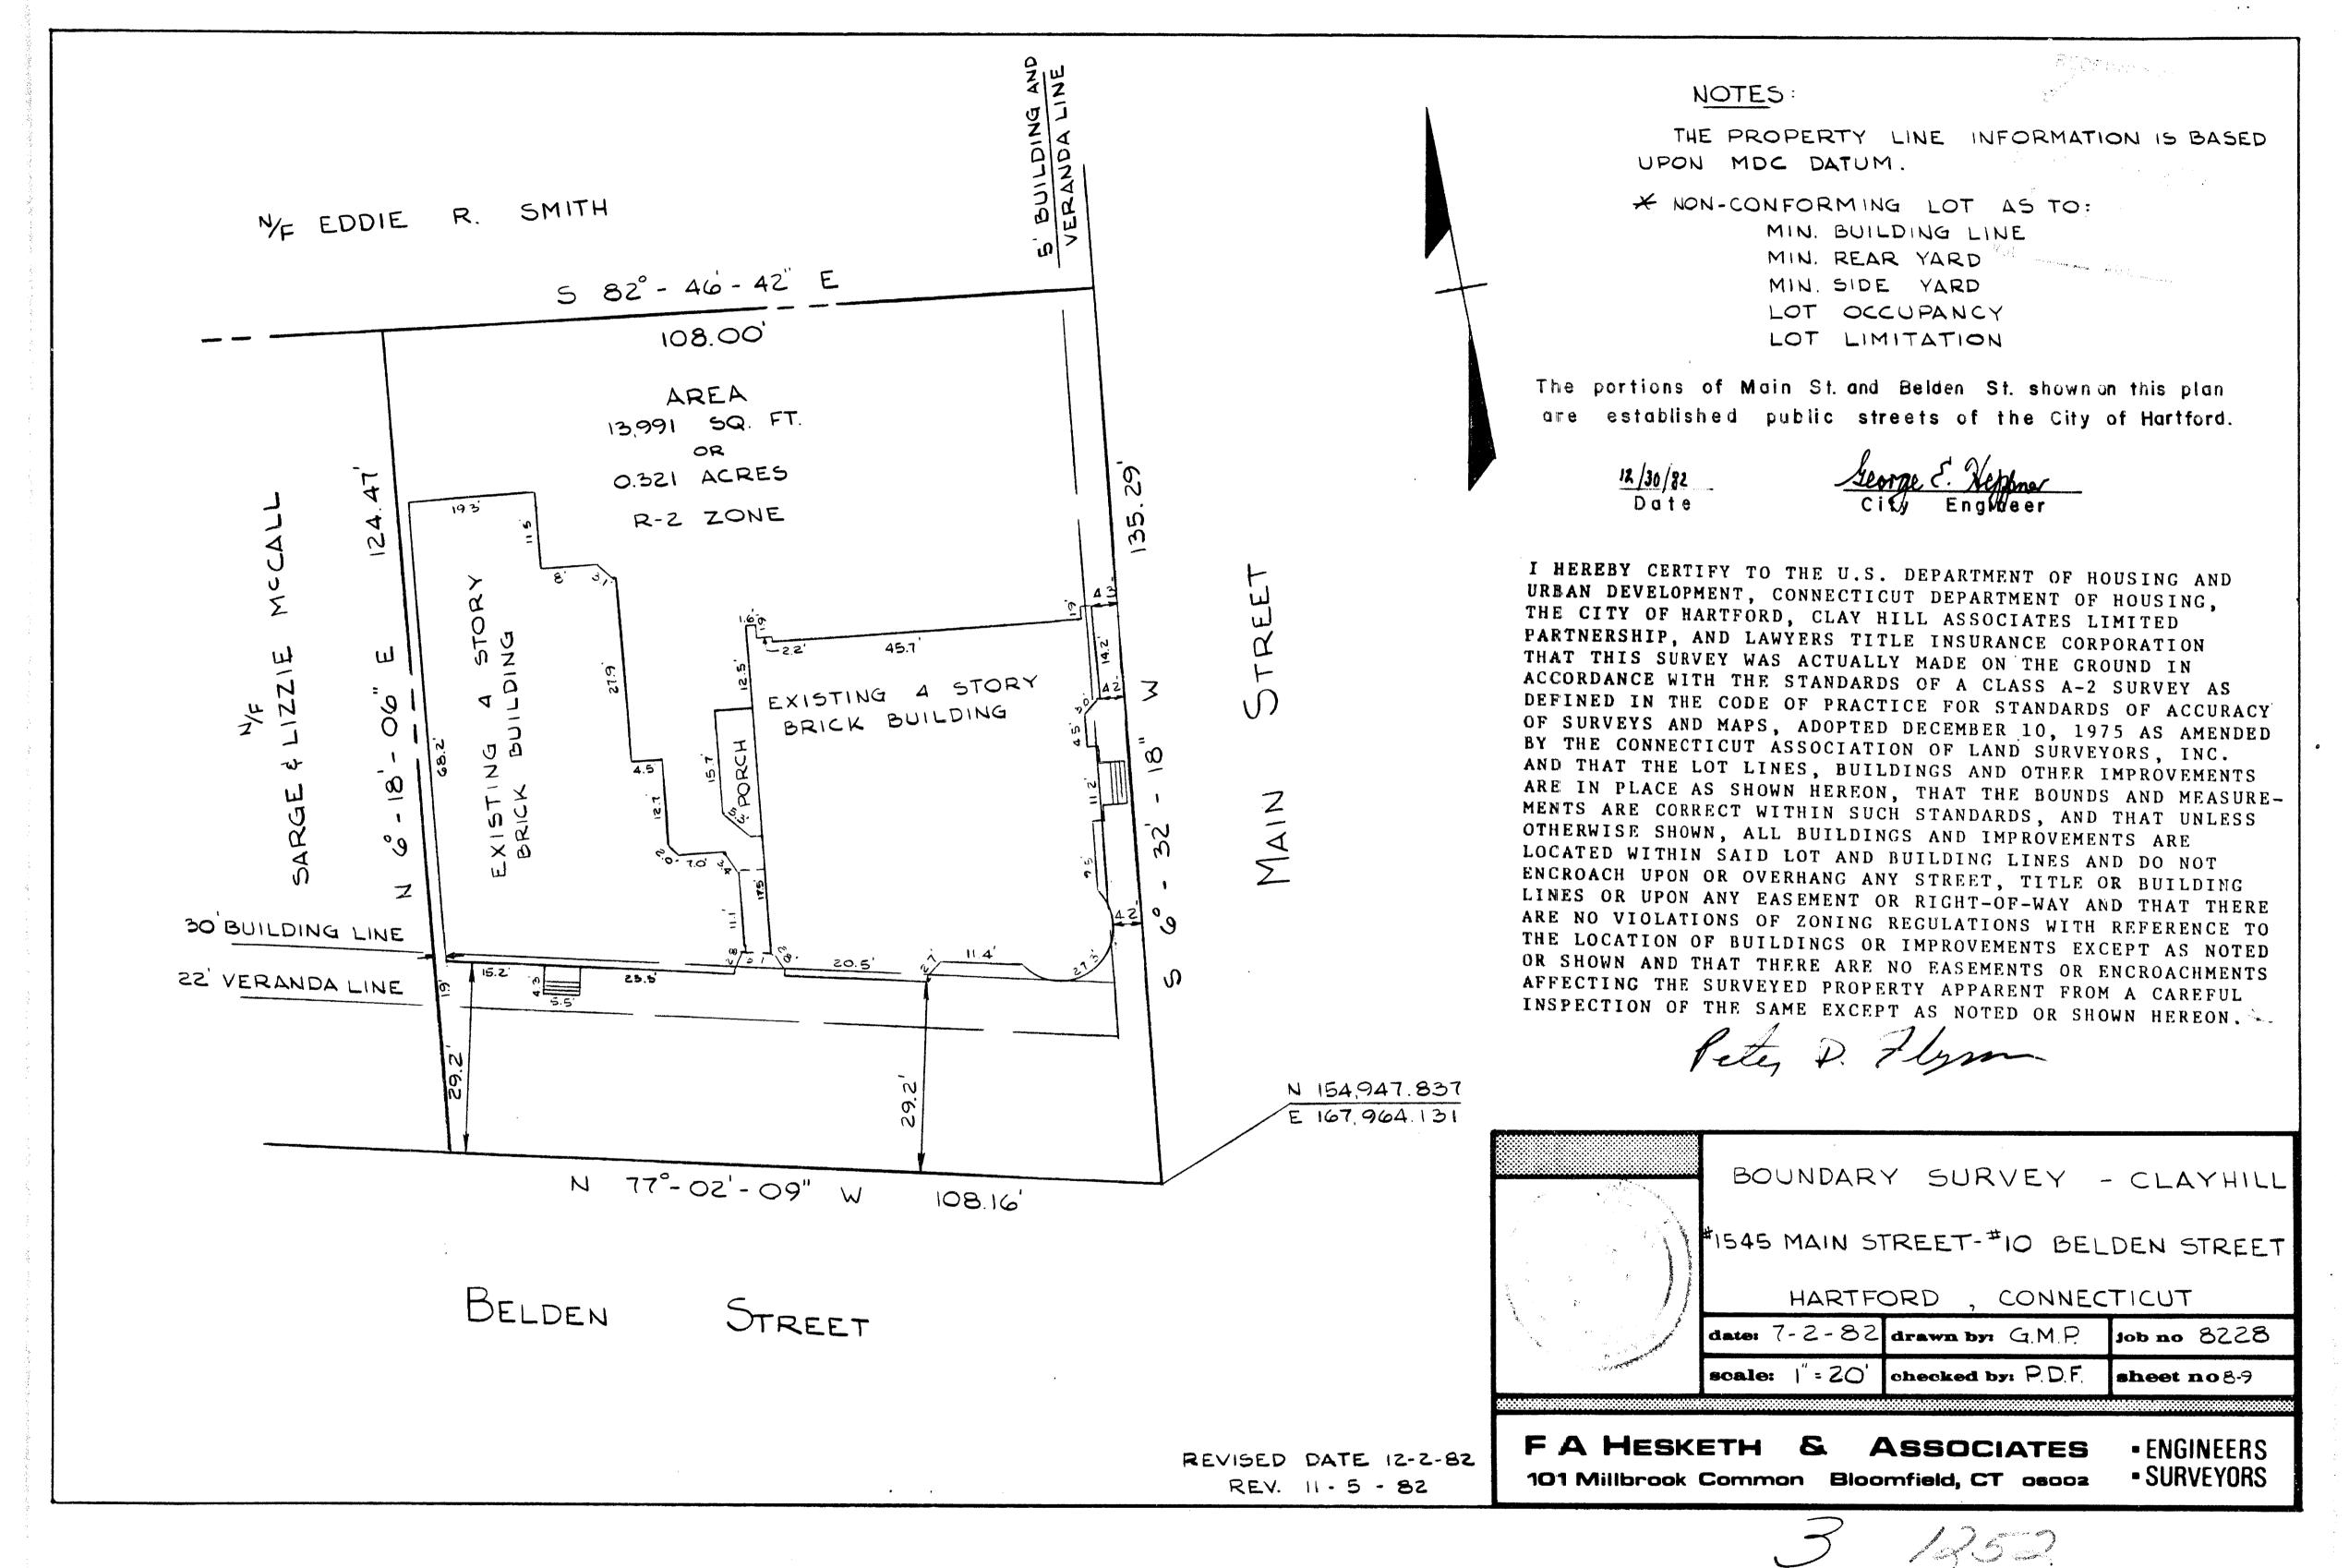

3 /3 3 2 1 1 2 3 4