

EAST FILE CORP. IRVING, CA 074 34
1254

1254-2

NOTES:
THE PROPERTY LINE INFORMATION
SHOWN IS BASED UPON MDC DATUM.


- * NON-CONFORMING LOT AS TO:
- MIN. REAR YARD
 - MIN. SIDE YARD
 - MIN. BUILDING LINE
 - MIN. AREA
 - MIN. WIDTH
 - LOT OCCUPANCY

The portion of East St. shown on this
plan is an established public street
of the City of Hartford.

12/21/82
Date

George E. Hoffman
City Engineer

EAST STREET

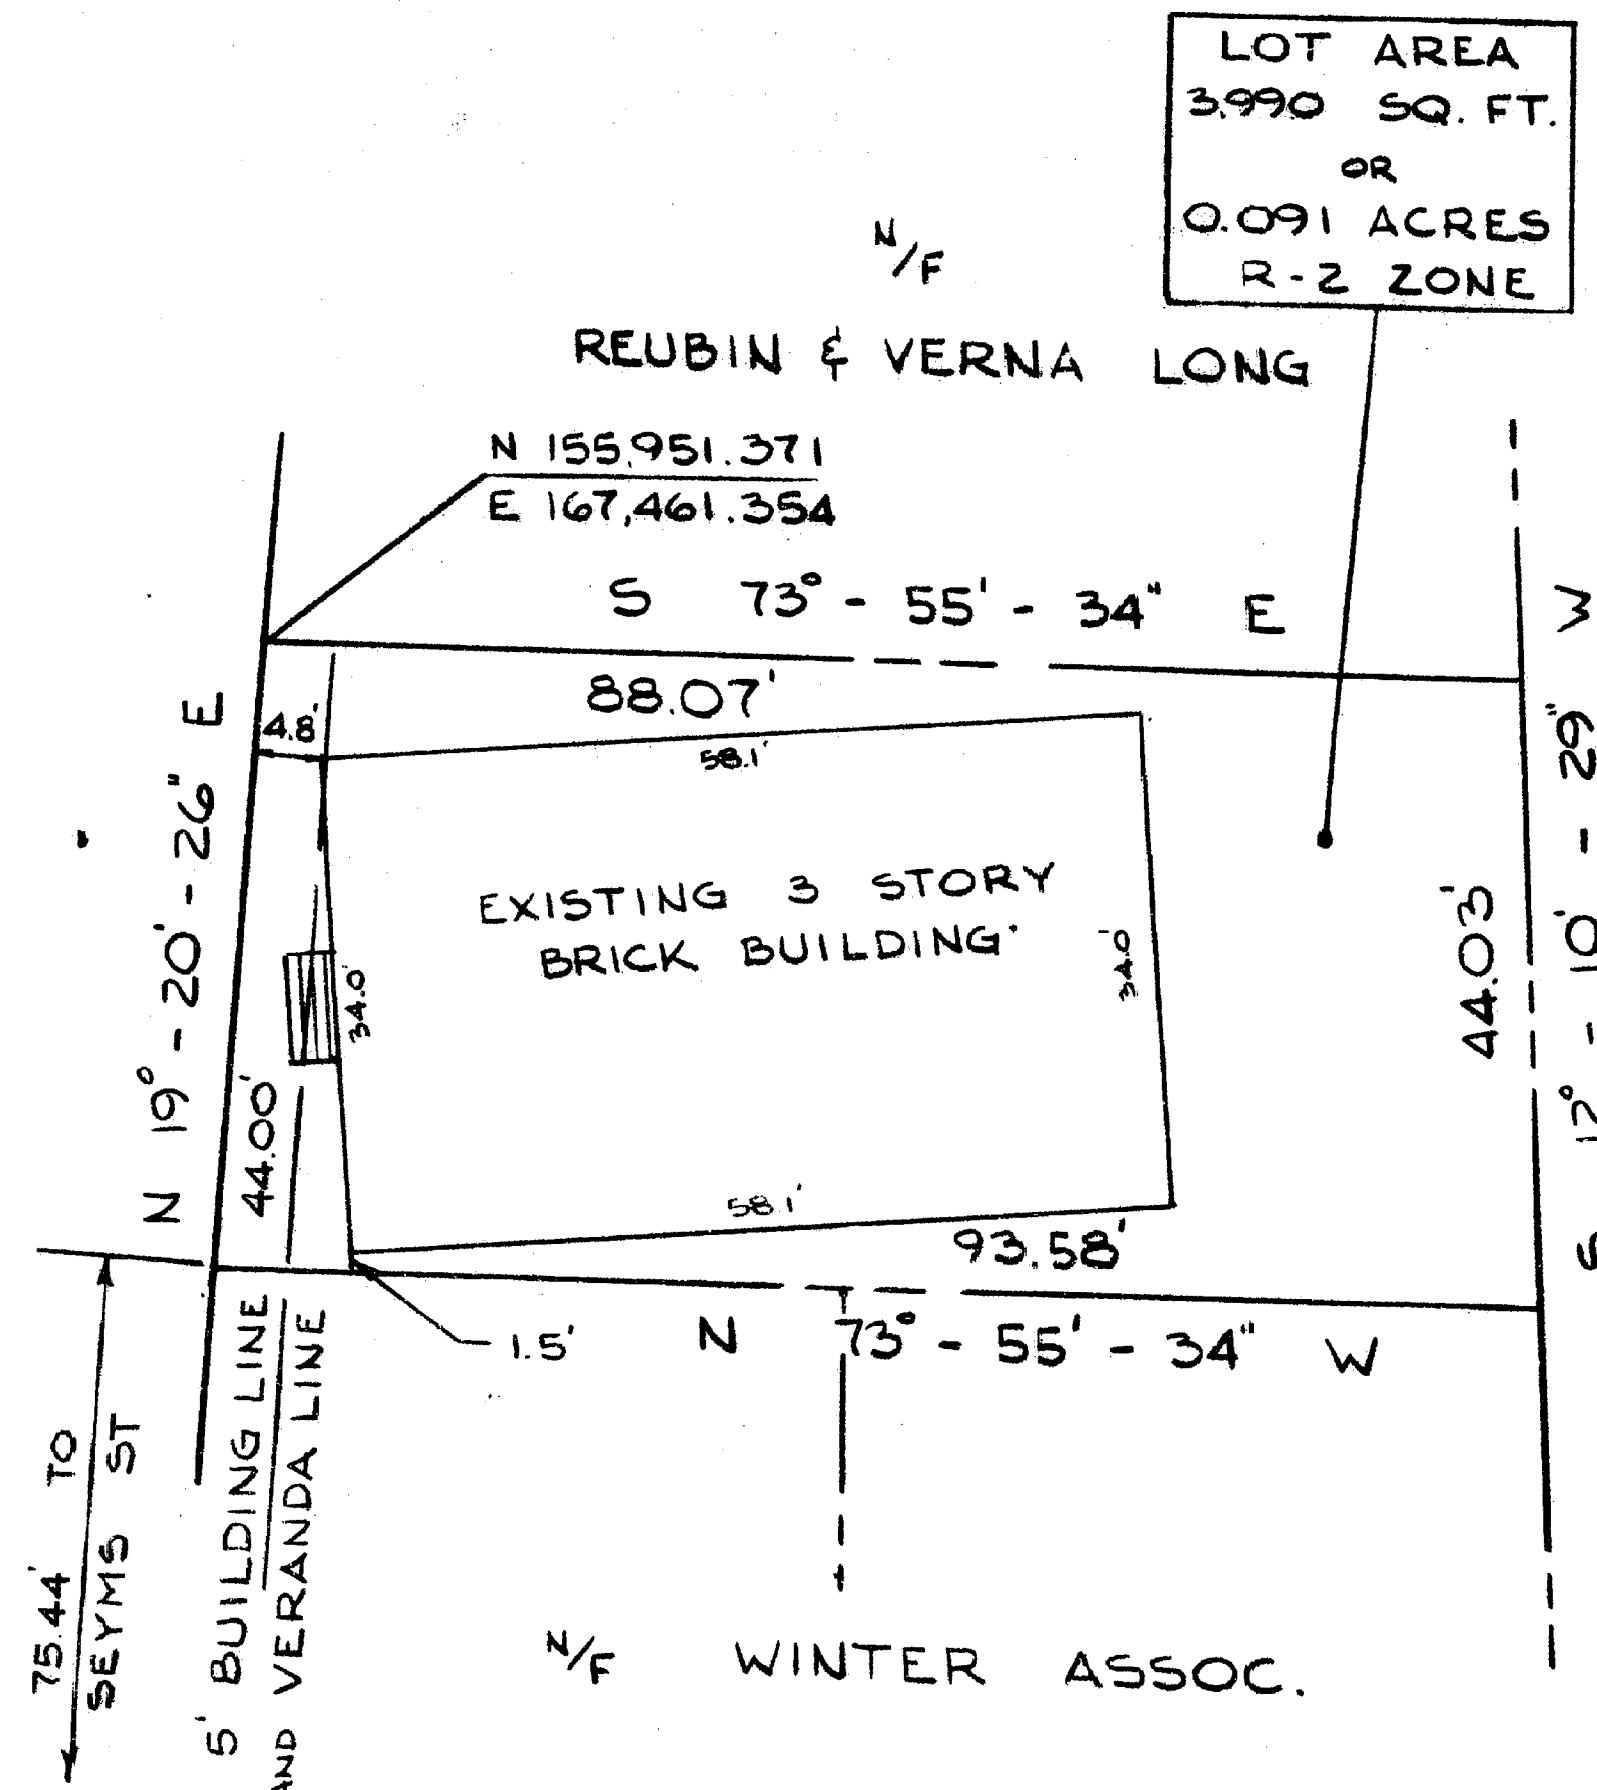

I HEREBY CERTIFY TO THE U.S. DEPARTMENT OF HOUSING AND
URBAN DEVELOPMENT, CONNECTICUT DEPARTMENT OF HOUSING,
THE CITY OF HARTFORD, CLAY HILL ASSOCIATES LIMITED
PARTNERSHIP, AND LAWYERS TITLE INSURANCE CORPORATION
THAT THIS SURVEY WAS ACTUALLY MADE ON THE GROUND IN
ACCORDANCE WITH THE STANDARDS OF A CLASS A-2 SURVEY AS
DEFINED IN THE CODE OF PRACTICE FOR STANDARDS OF ACCURACY
OF SURVEYS AND MAPS, ADOPTED DECEMBER 10, 1975 AS AMENDED
BY THE CONNECTICUT ASSOCIATION OF LAND SURVEYORS, INC.
AND THAT THE LOT LINES, BUILDINGS AND OTHER IMPROVEMENTS
ARE IN PLACE AS SHOWN HEREON, THAT THE BOUNDS AND MEASURE-
MENTS ARE CORRECT WITHIN SUCH STANDARDS, AND THAT UNLESS
OTHERWISE SHOWN, ALL BUILDINGS AND IMPROVEMENTS ARE
LOCATED WITHIN SAID LOT AND BUILDING LINES AND DO NOT
ENCROACH UPON OR OVERHANG ANY STREET, TITLE OR BUILDING
LINES OR UPON ANY EASEMENT OR RIGHT-OF-WAY AND THAT THERE
ARE NO VIOLATIONS OF ZONING REGULATIONS WITH REFERENCE TO
THE LOCATION OF BUILDINGS OR IMPROVEMENTS EXCEPT AS NOTED
OR SHOWN AND THAT THERE ARE NO EASEMENTS OR ENCROACHMENTS
AFFECTING THE SURVEYED PROPERTY APPARENT FROM A CAREFUL
INSPECTION OF THE SAME EXCEPT AS NOTED OR SHOWN HEREON.*

Peter D. Flynn

REVISED DATE 12-2-82

BOUNDARY SURVEY - CLAYHILL			
#84-86 EAST STREET			
HARTFORD, CONNECTICUT			
date: 7-2-82	drawn by: G.M.P.	job no 8228	
scale: 1"=20'	checked by: R.D.F.	sheet no 9	
F A HESKETH & ASSOCIATES -ENGINEERS			
101 Millbrook Common Bloomfield, CT 06002 -SURVEYORS			

1234
0 INCHES 1 2 3 4