


1256

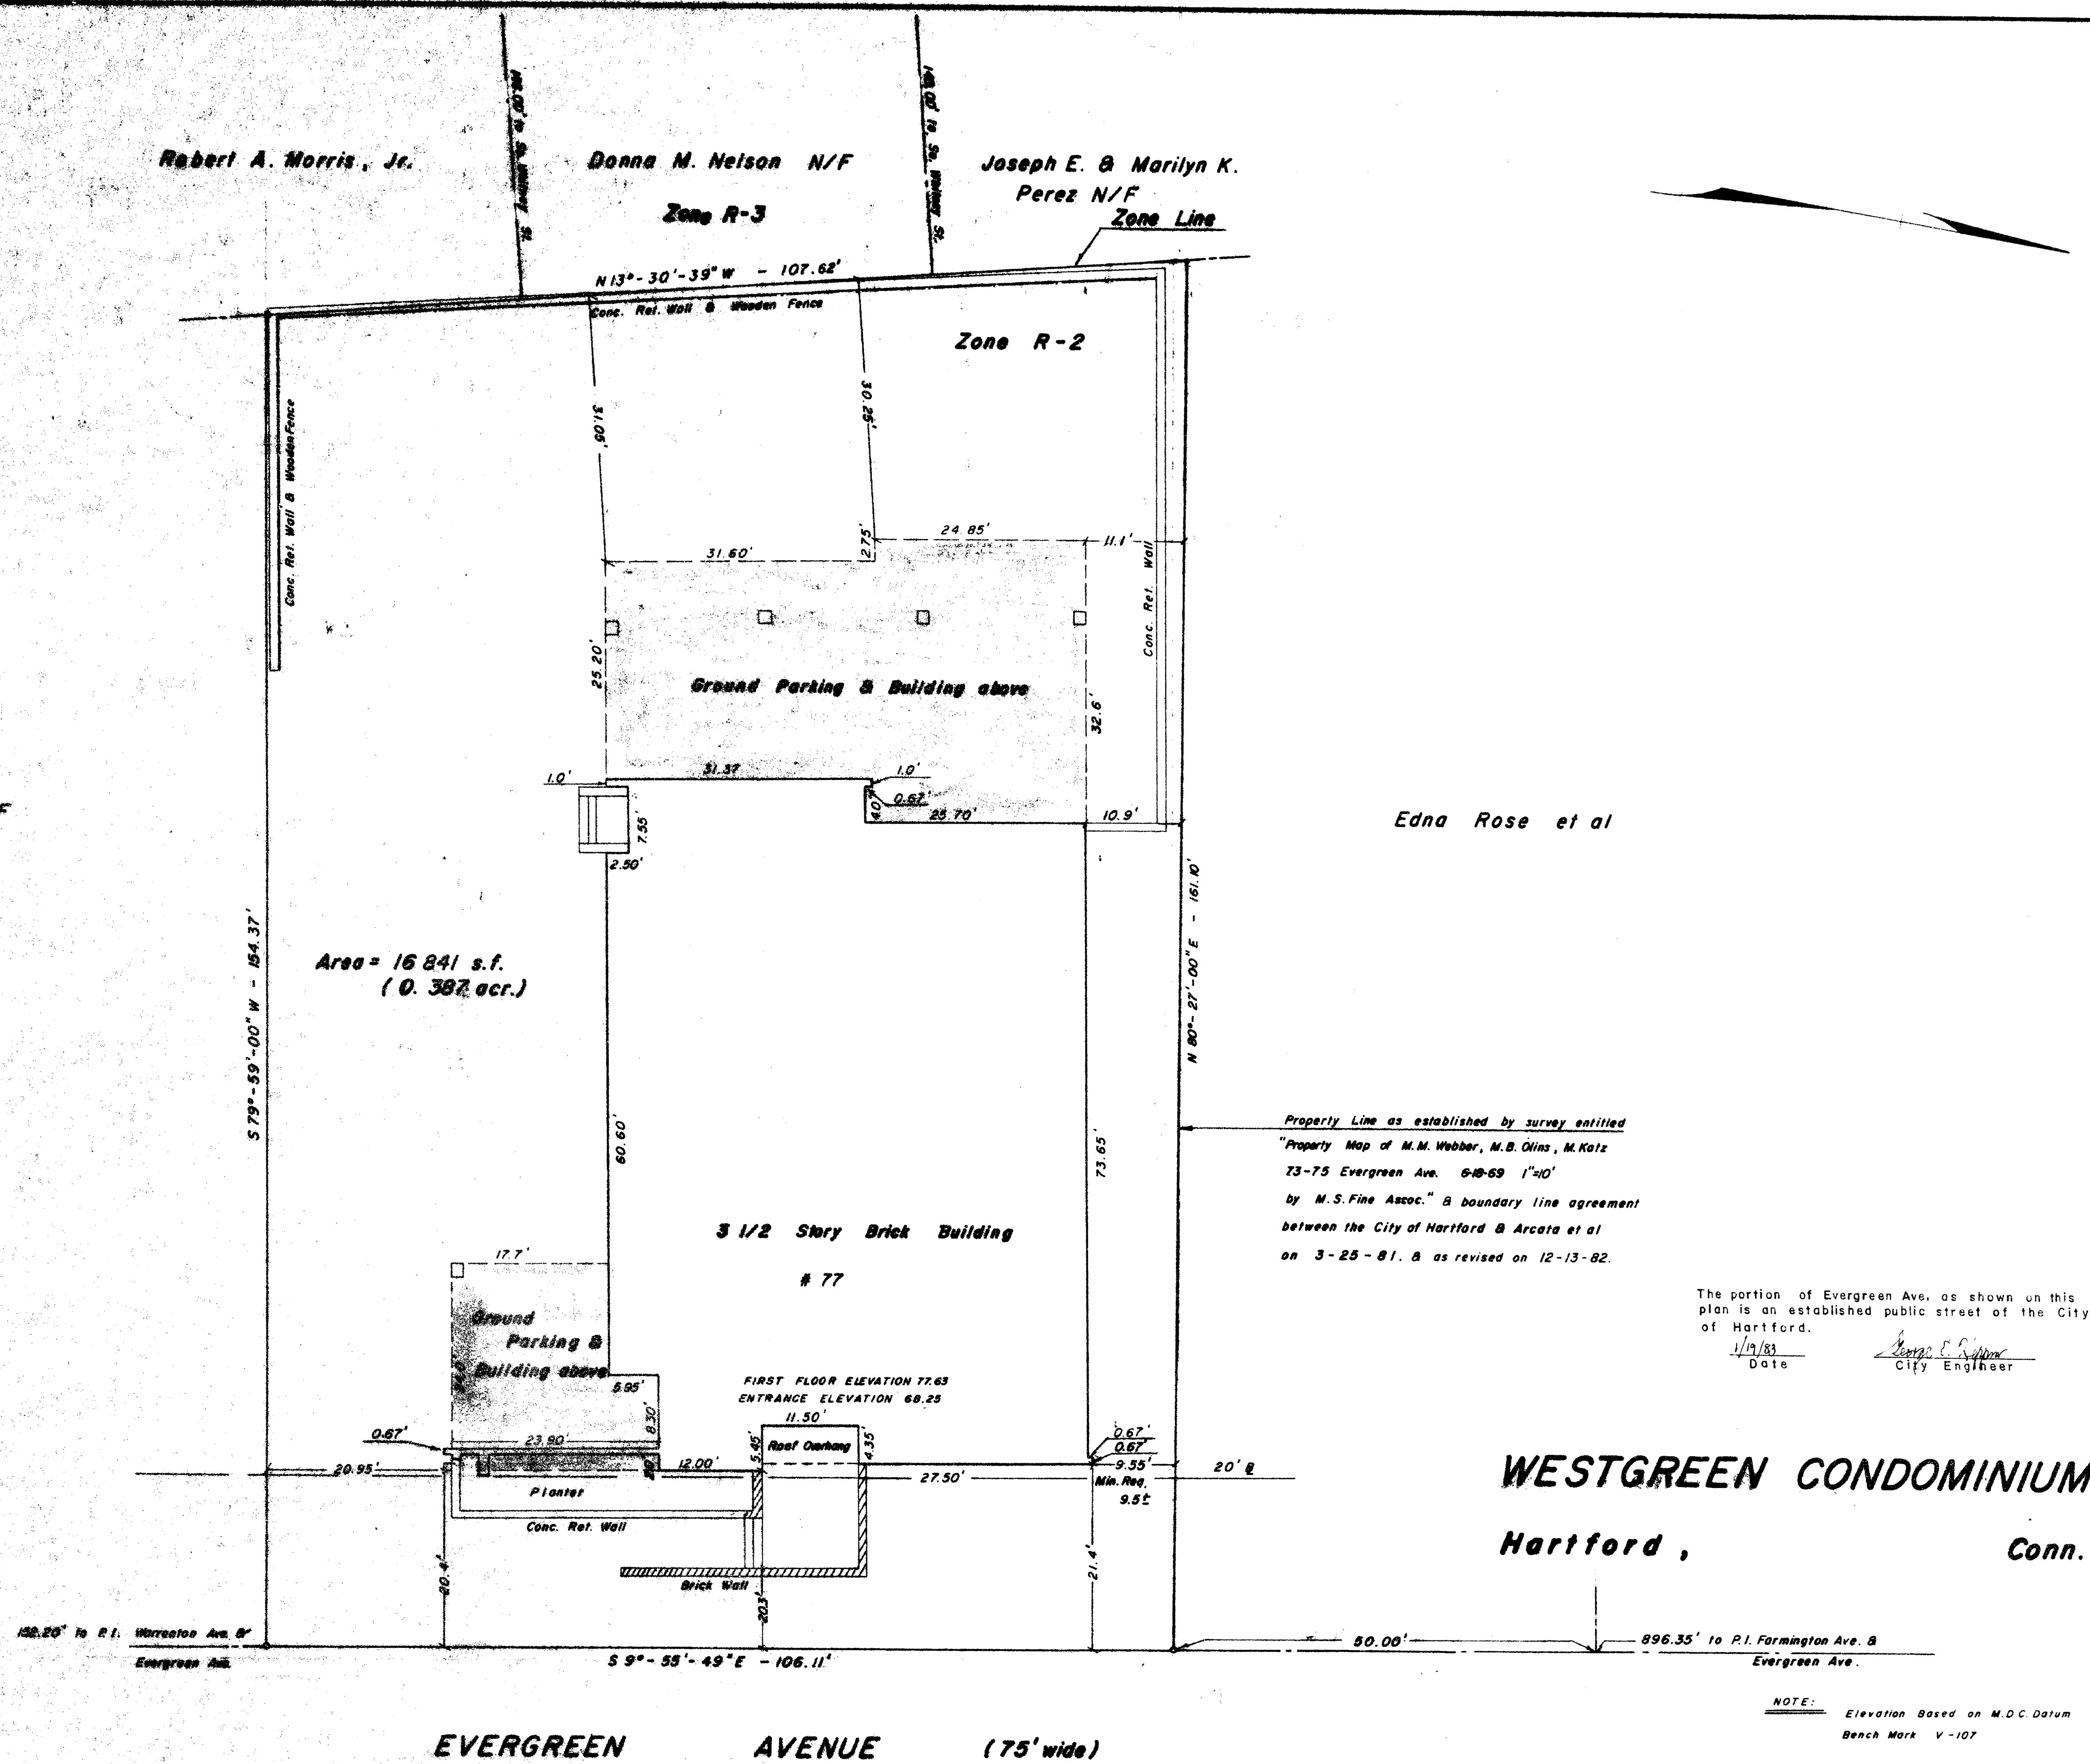

WESTGREEN CONDOMINIUM
Hartford, Conn.

NOTE: Elevation Based on M.D.C. Datum
Bench Mark V-107

I HEREBY CERTIFY THAT THIS MAP AND SURVEY WERE PREPARED IN ACCORDANCE WITH THE STANDARDS OF A CLASS B-2 SURVEY, AS DEFINED IN THE CODE OF PRACTICE FOR STANDARDS OF ACCURACY OF SURVEY AND MAPS, ADOPTED DECEMBER 10, 1975 AS AMENDED BY THE CONNECTICUT ASSOCIATION OF LAND SURVEYORS, INC.

IGOR VECHESLOFF
PROFESSIONAL ENGINEER & LAND SURVEYOR
51 LORRAINE STREET
HARTFORD, CONNECTICUT

Up-date 12-14-82
SCALE 1"=10'
DATE 4-20-81
DRAWING NO. 1051

1256
16
0 1 2 3 4
INCHES