


0585

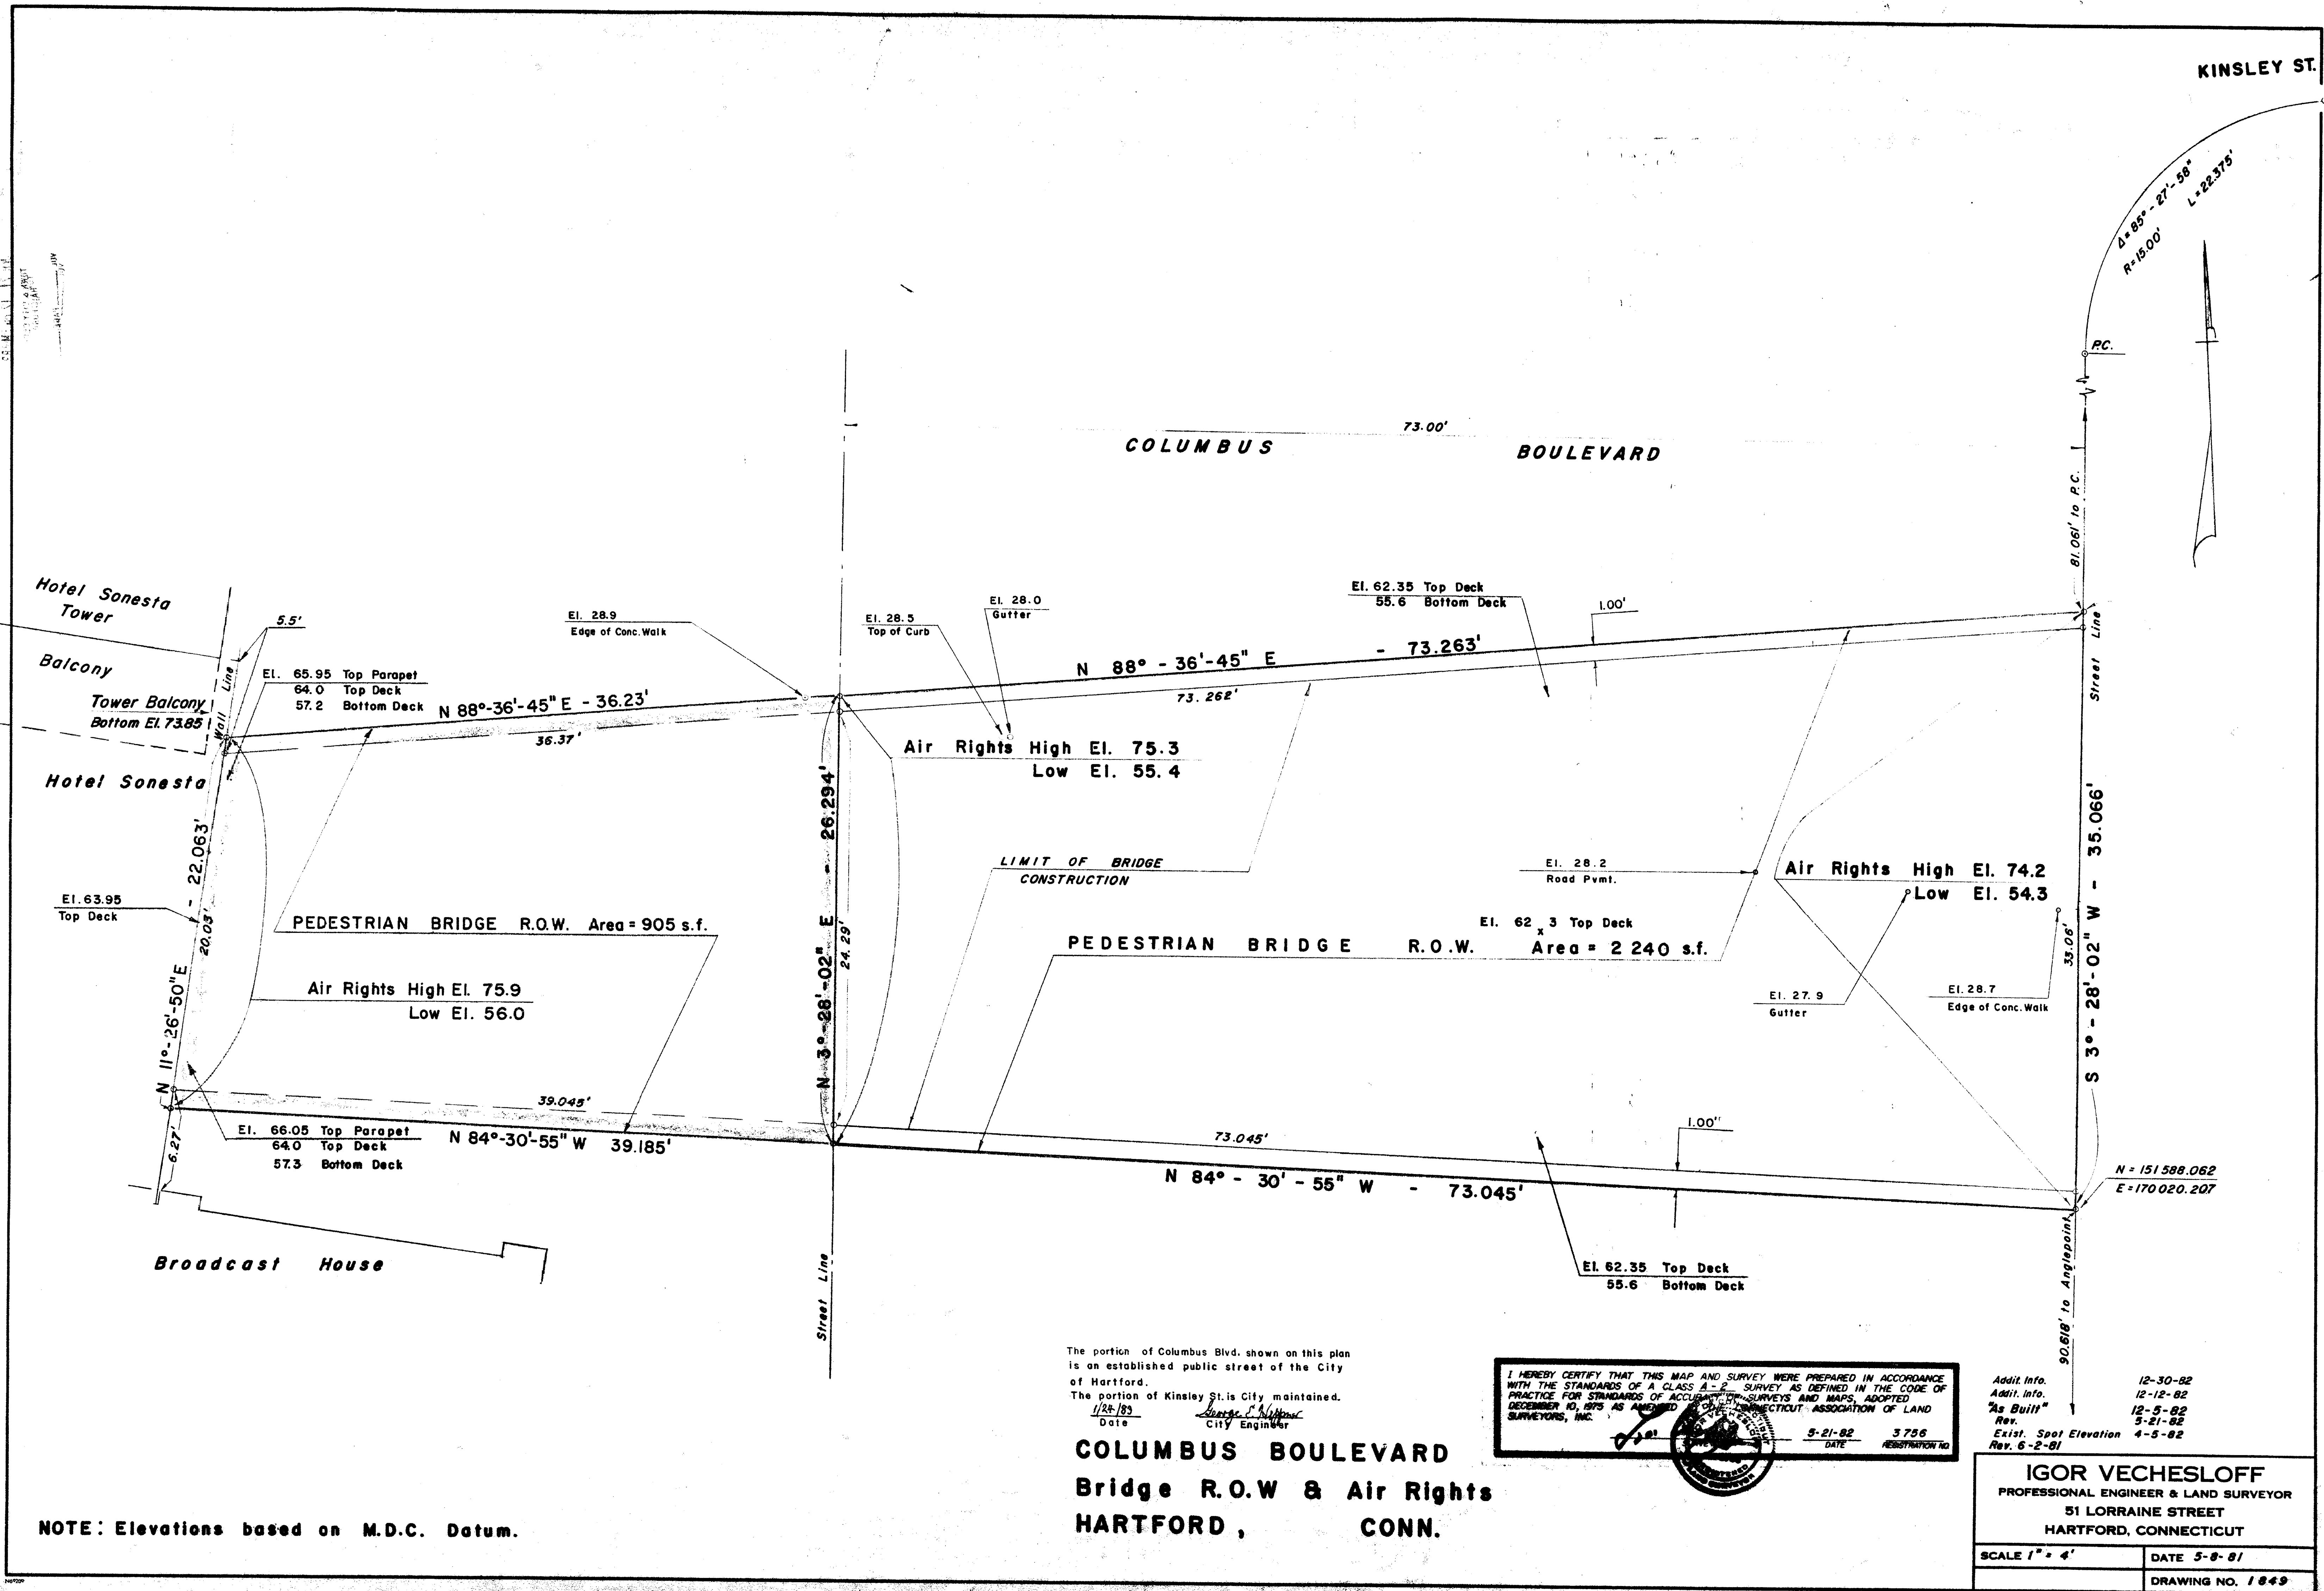

1258

