



RECEIVED BY
William A. [Signature]
 MAR 17 4 56 AM '83
 TOWN & CITY CLERK
 HARTFORD
 VOL PAGE
 4740 90

SURVEYOR'S CERTIFICATION

I HEREBY CERTIFY to Rene Veilleux, and Connecticut Housing Finance Authority and Commonwealth Land Title Insurance Company, that this survey was actually made upon the ground on February 10, 1983 and that it and the bounds and measurements shown hereon are correct within the standards of CLASS A-2 of the "Code of Recommended Practice for Standards of Accuracy of Surveys and Maps" prepared by the Connecticut Association of Land Surveyors, Inc., and approved by the State Board of Registration for Professional Engineers and Land Surveyors in October, 1976, and that, unless otherwise shown, title lines and lines of actual possession are the same, buildings are located as shown and do not encroach over or upon street, title, or building lines; there are no violations of zoning regulations with reference to the location of said buildings, and there are no easements or encroachments affecting this property from a careful inspection of the same.

Carl H. Jaeger
 CARL H. JAEGER Land Surveyor
 Conn. Registry & L.S. No. 7763

2-14-83
 Date

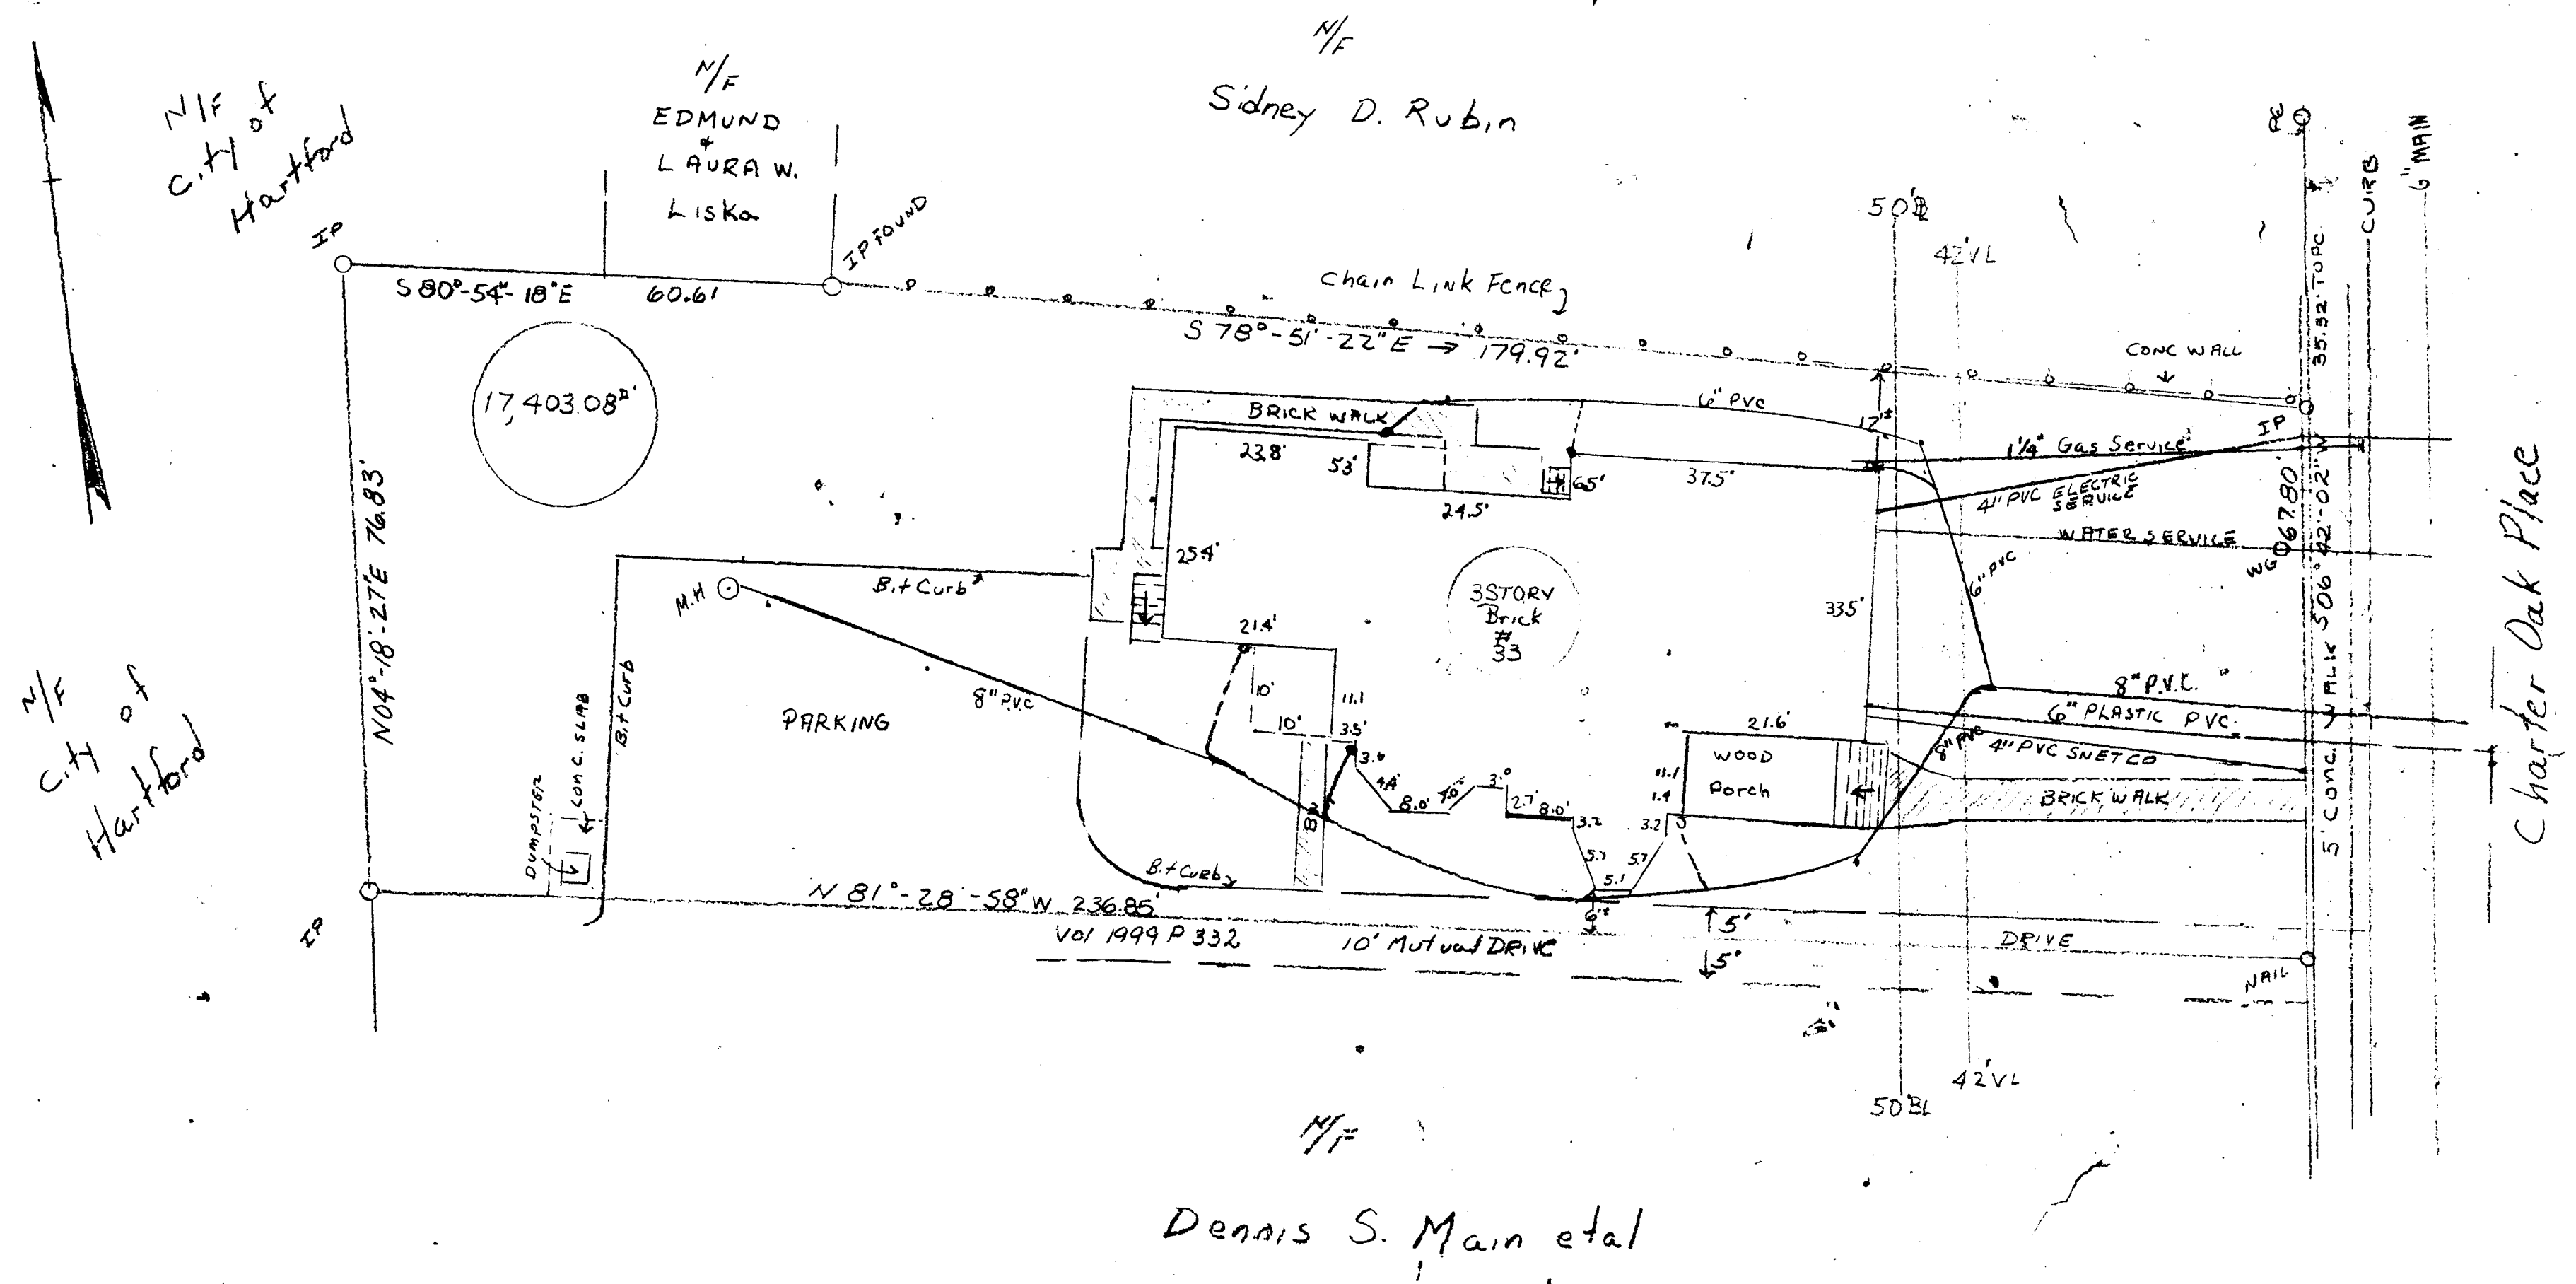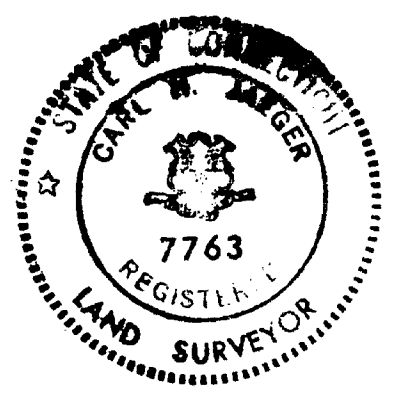

The portion of Charter Oak Place shown on this plan is an established public street of the City of Hartford.
 3/21/83 Date
George E. [Signature] City Engineer

Re Lot #32 Block 10 Charter Oak - South Green Project
 Section 1 Conn R-112 Daybook No. 010529

PROPERTY OF Rene Veilleux 33 Charter Oak Place TOWN OF Hartford Connecticut	I HEREBY CERTIFY THAT THIS MAP & SURVEY WERE PREPARED IN ACCORDANCE WITH THE STANDARDS OF CLASS A-2 SURVEY AS DEFINED IN THE CODE OF PRACTICE FOR STANDARDS AND ACCURACY OF SURVEY & MAPS ADOPTED DECEMBER 10, 1975 AS AMENDED BY THE CONN. ASSOCIATION OF LAND SURVEYORS, INC.	ALCA SURVEY ASSOCIATES CARL H. JAEGER L.S. 7763 WETHERSFIELD, CONN. <i>Carl H. Jaeger</i> SCALE: 1"=20' SHEET DATE: 2-14-83 1 OF 1	
--	--	---	--