


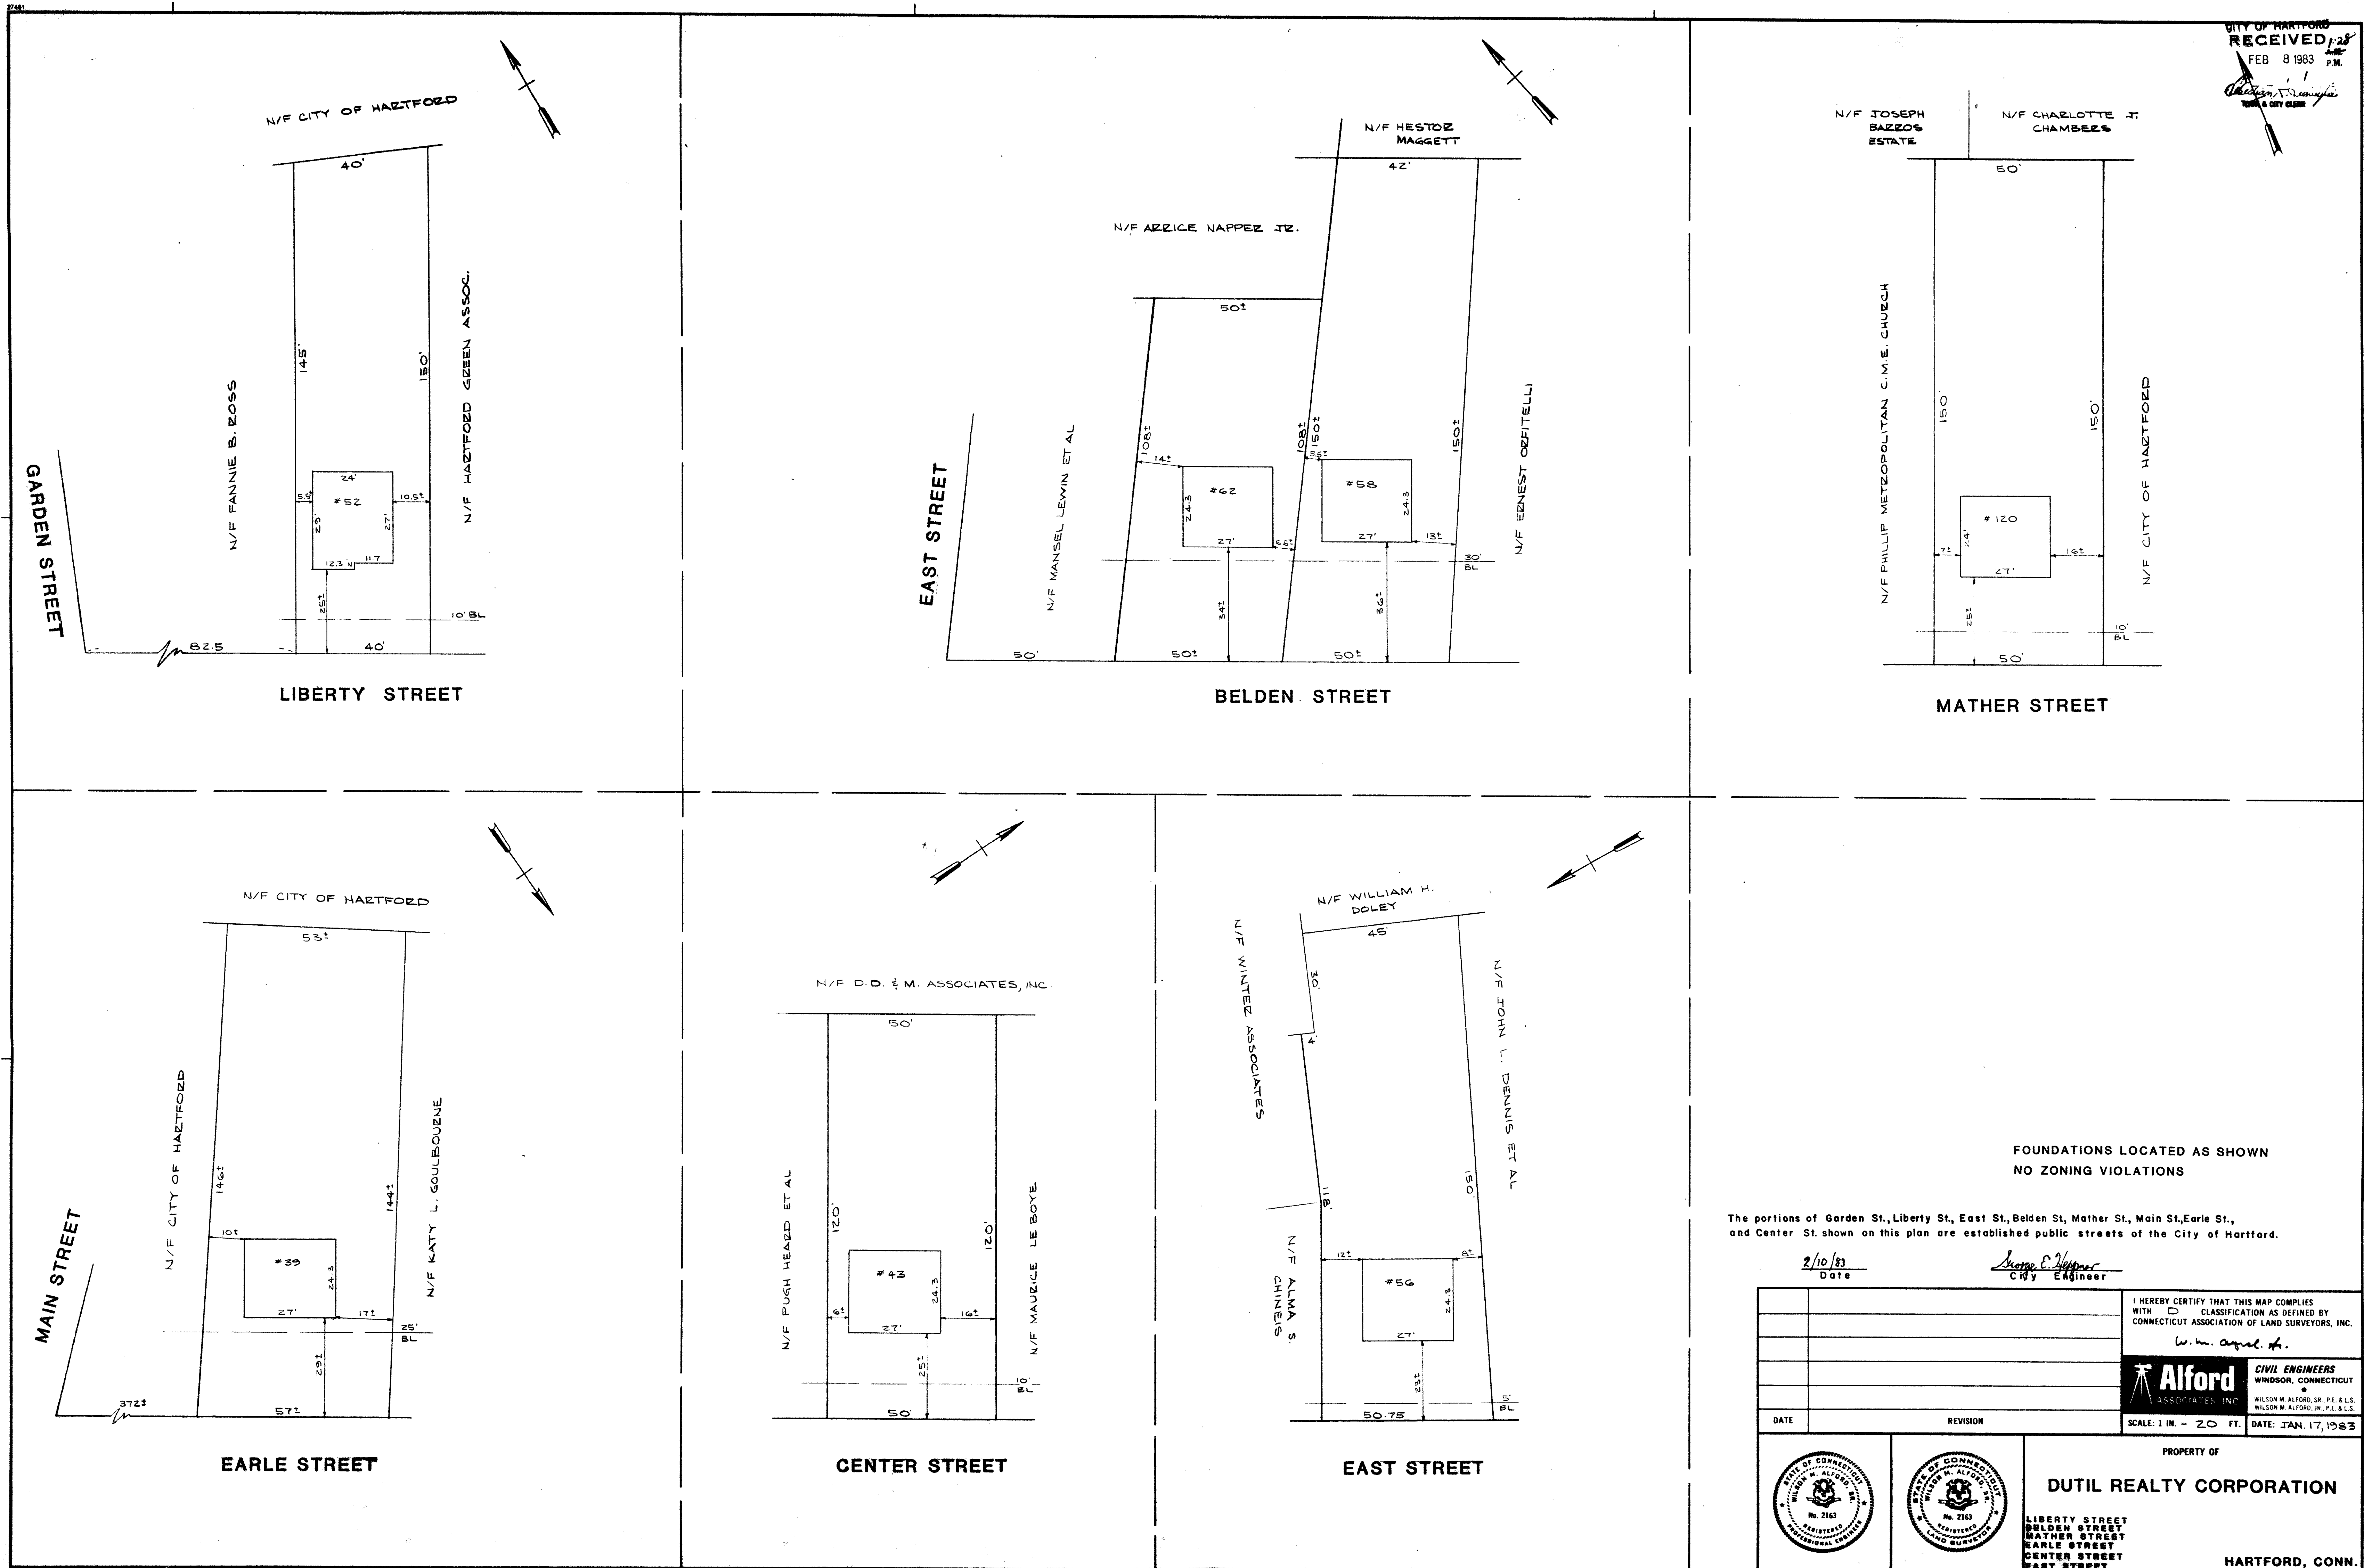

1265

FOUNDATIONS LOCATED AS SHOWN
NO ZONING VIOLATIONS

The portions of Garden St., Liberty St., East St., Belden St., Mather St., Main St., Earle St., and Center St. shown on this plan are established public streets of the City of Hartford.

2/10/83 Date		George C. Dutil City Engineer	
I HEREBY CERTIFY THAT THIS MAP COMPLIES WITH CLASSIFICATION AS DEFINED BY CONNECTICUT ASSOCIATION OF LAND SURVEYORS, INC.		W. M. Apple, Jr.	
Alford ASSOCIATES, INC.		CIVIL ENGINEERS WINDSOR, CONNECTICUT WILSON M. ALFORD, SR., P.E. & L.S. WILSON M. ALFORD, JR., P.E. & L.S.	
DATE	REVISION	SCALE: 1 IN. = 20 FT. DATE: JAN. 17, 1983	
PROPERTY OF DUTIL REALTY CORPORATION		LIBERTY STREET Belden Street Mather Street Earle Street Center Street East Street HARTFORD, CONN.	

22 1265
0 1 2 3 4
INCHES