
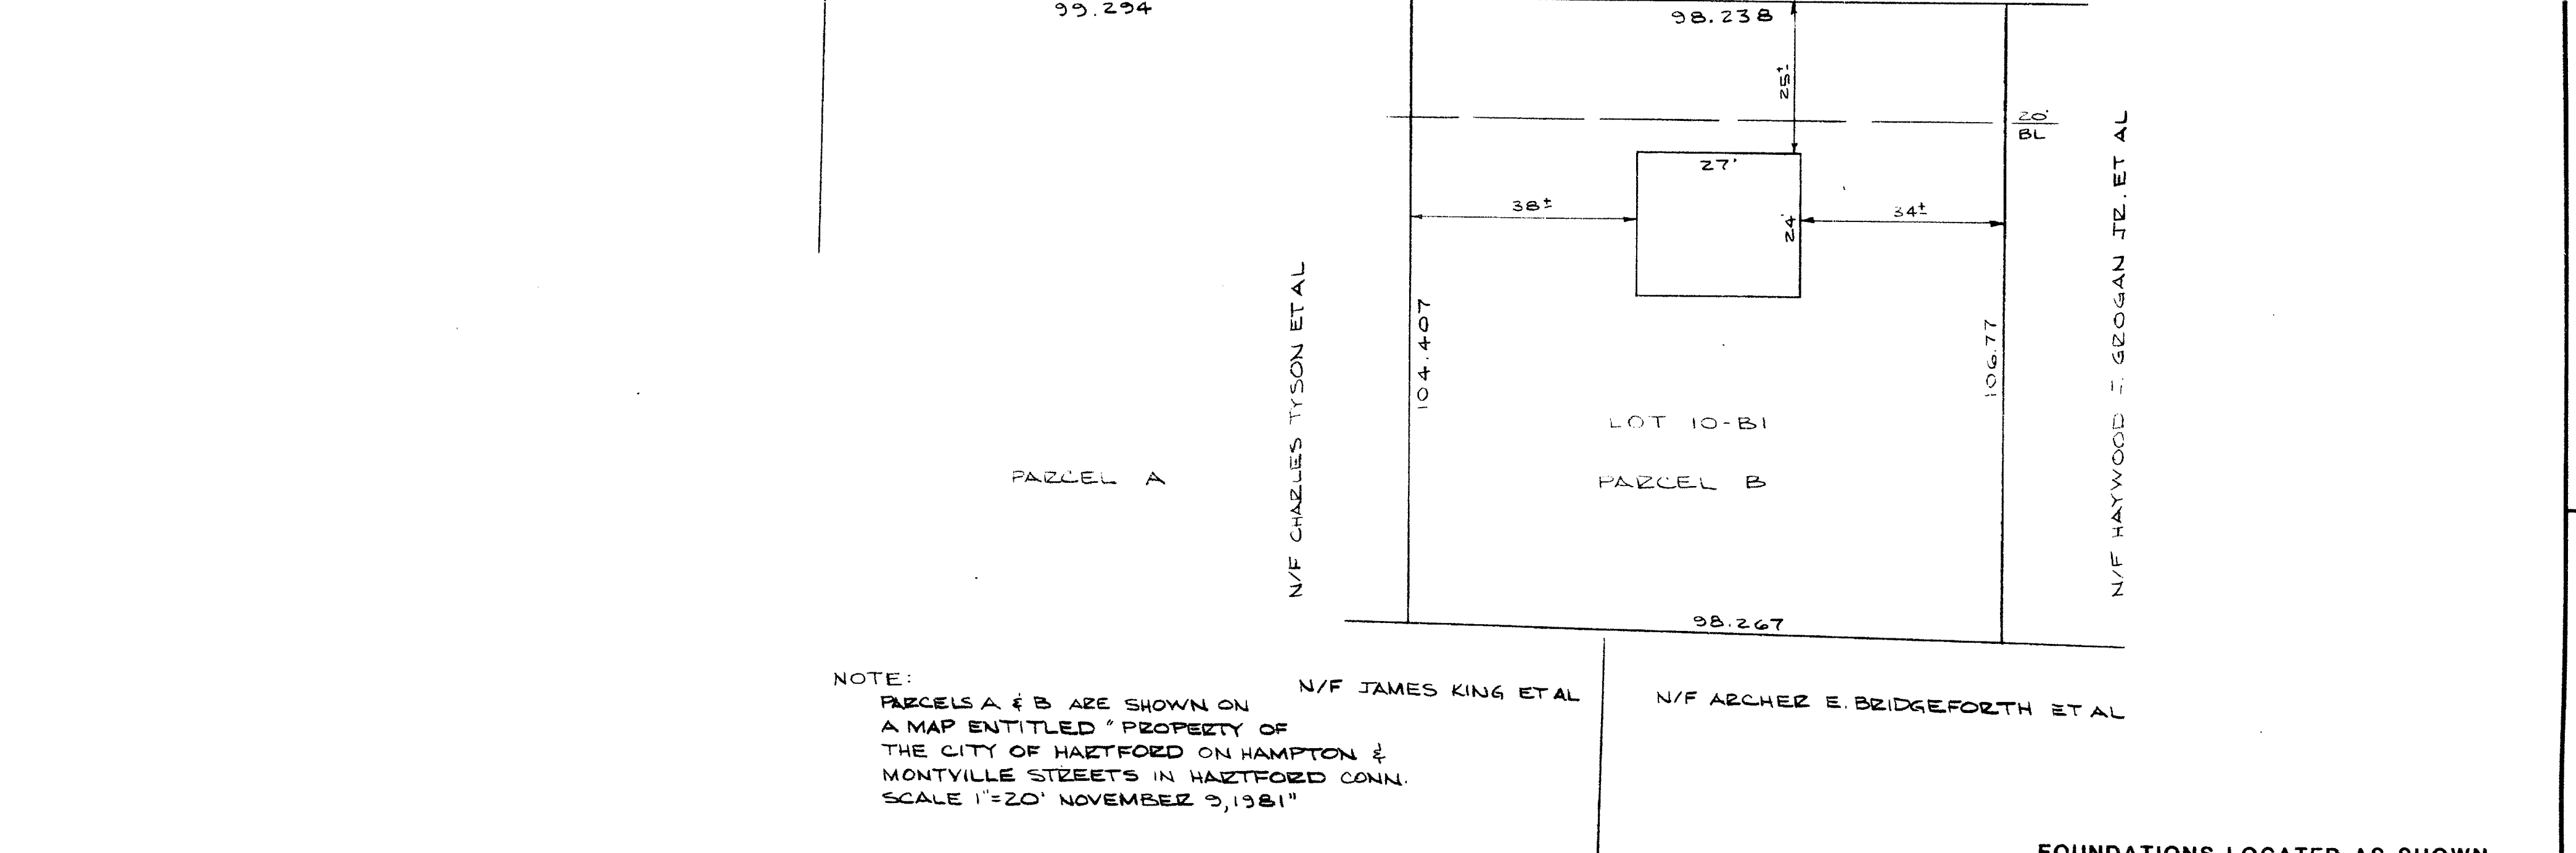
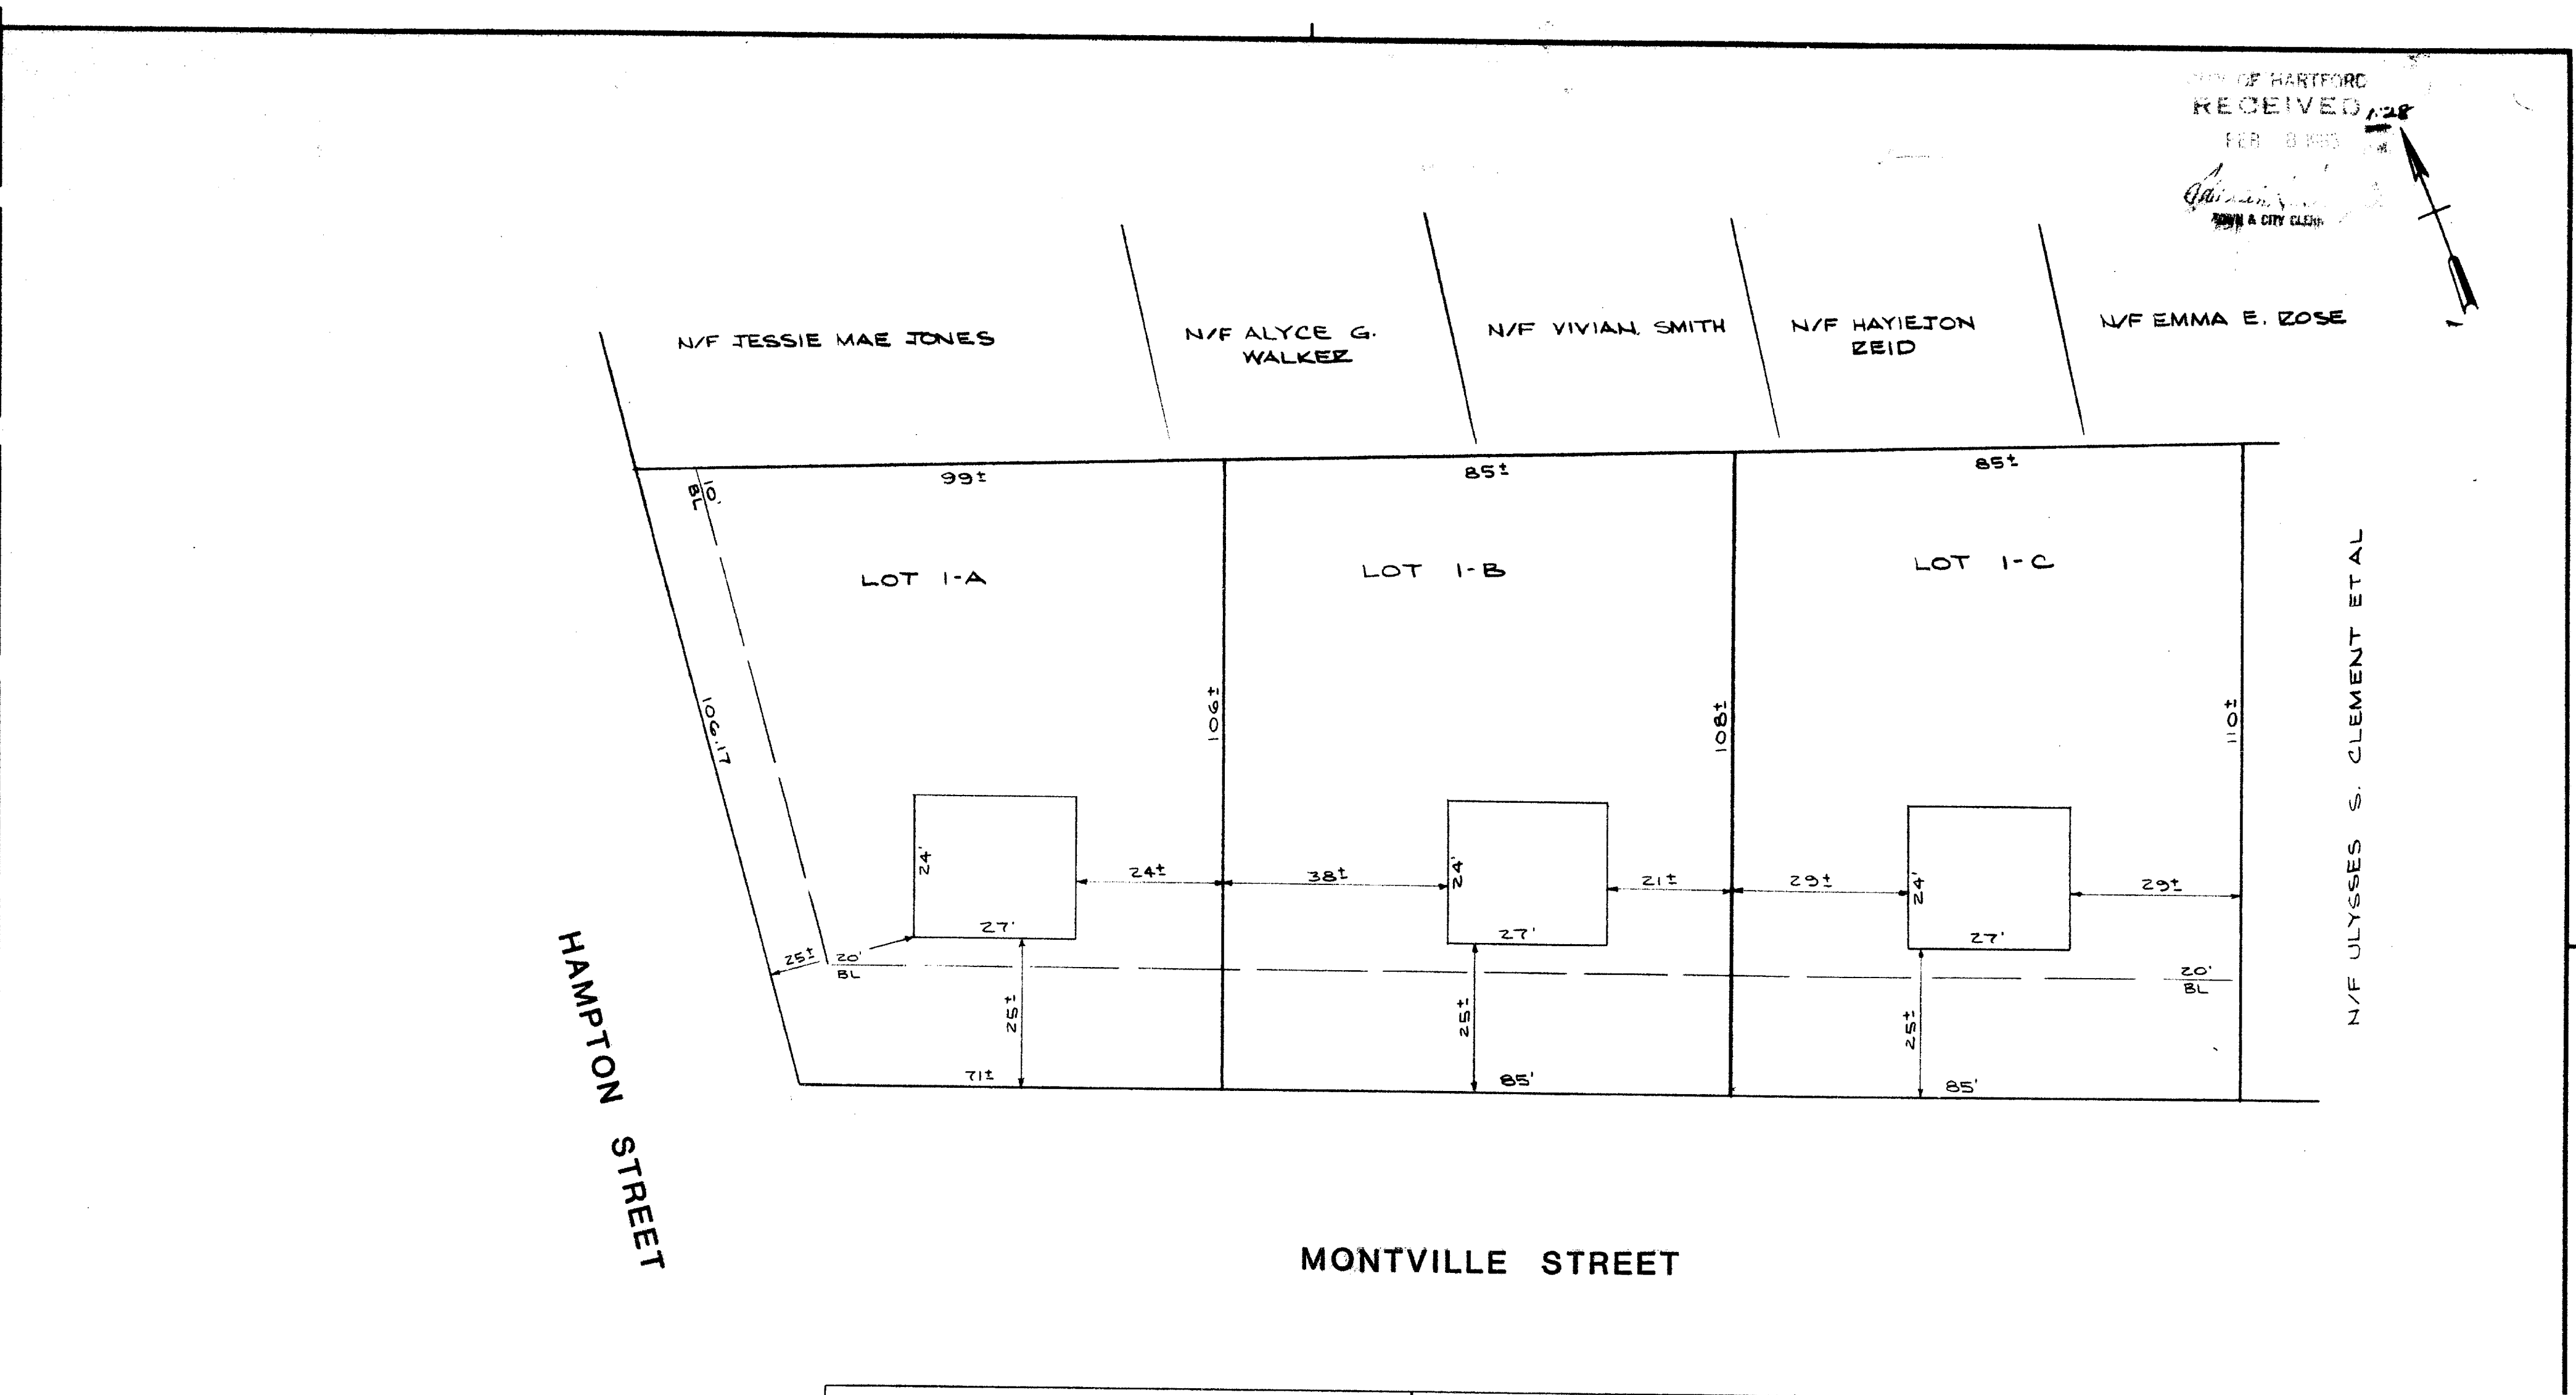
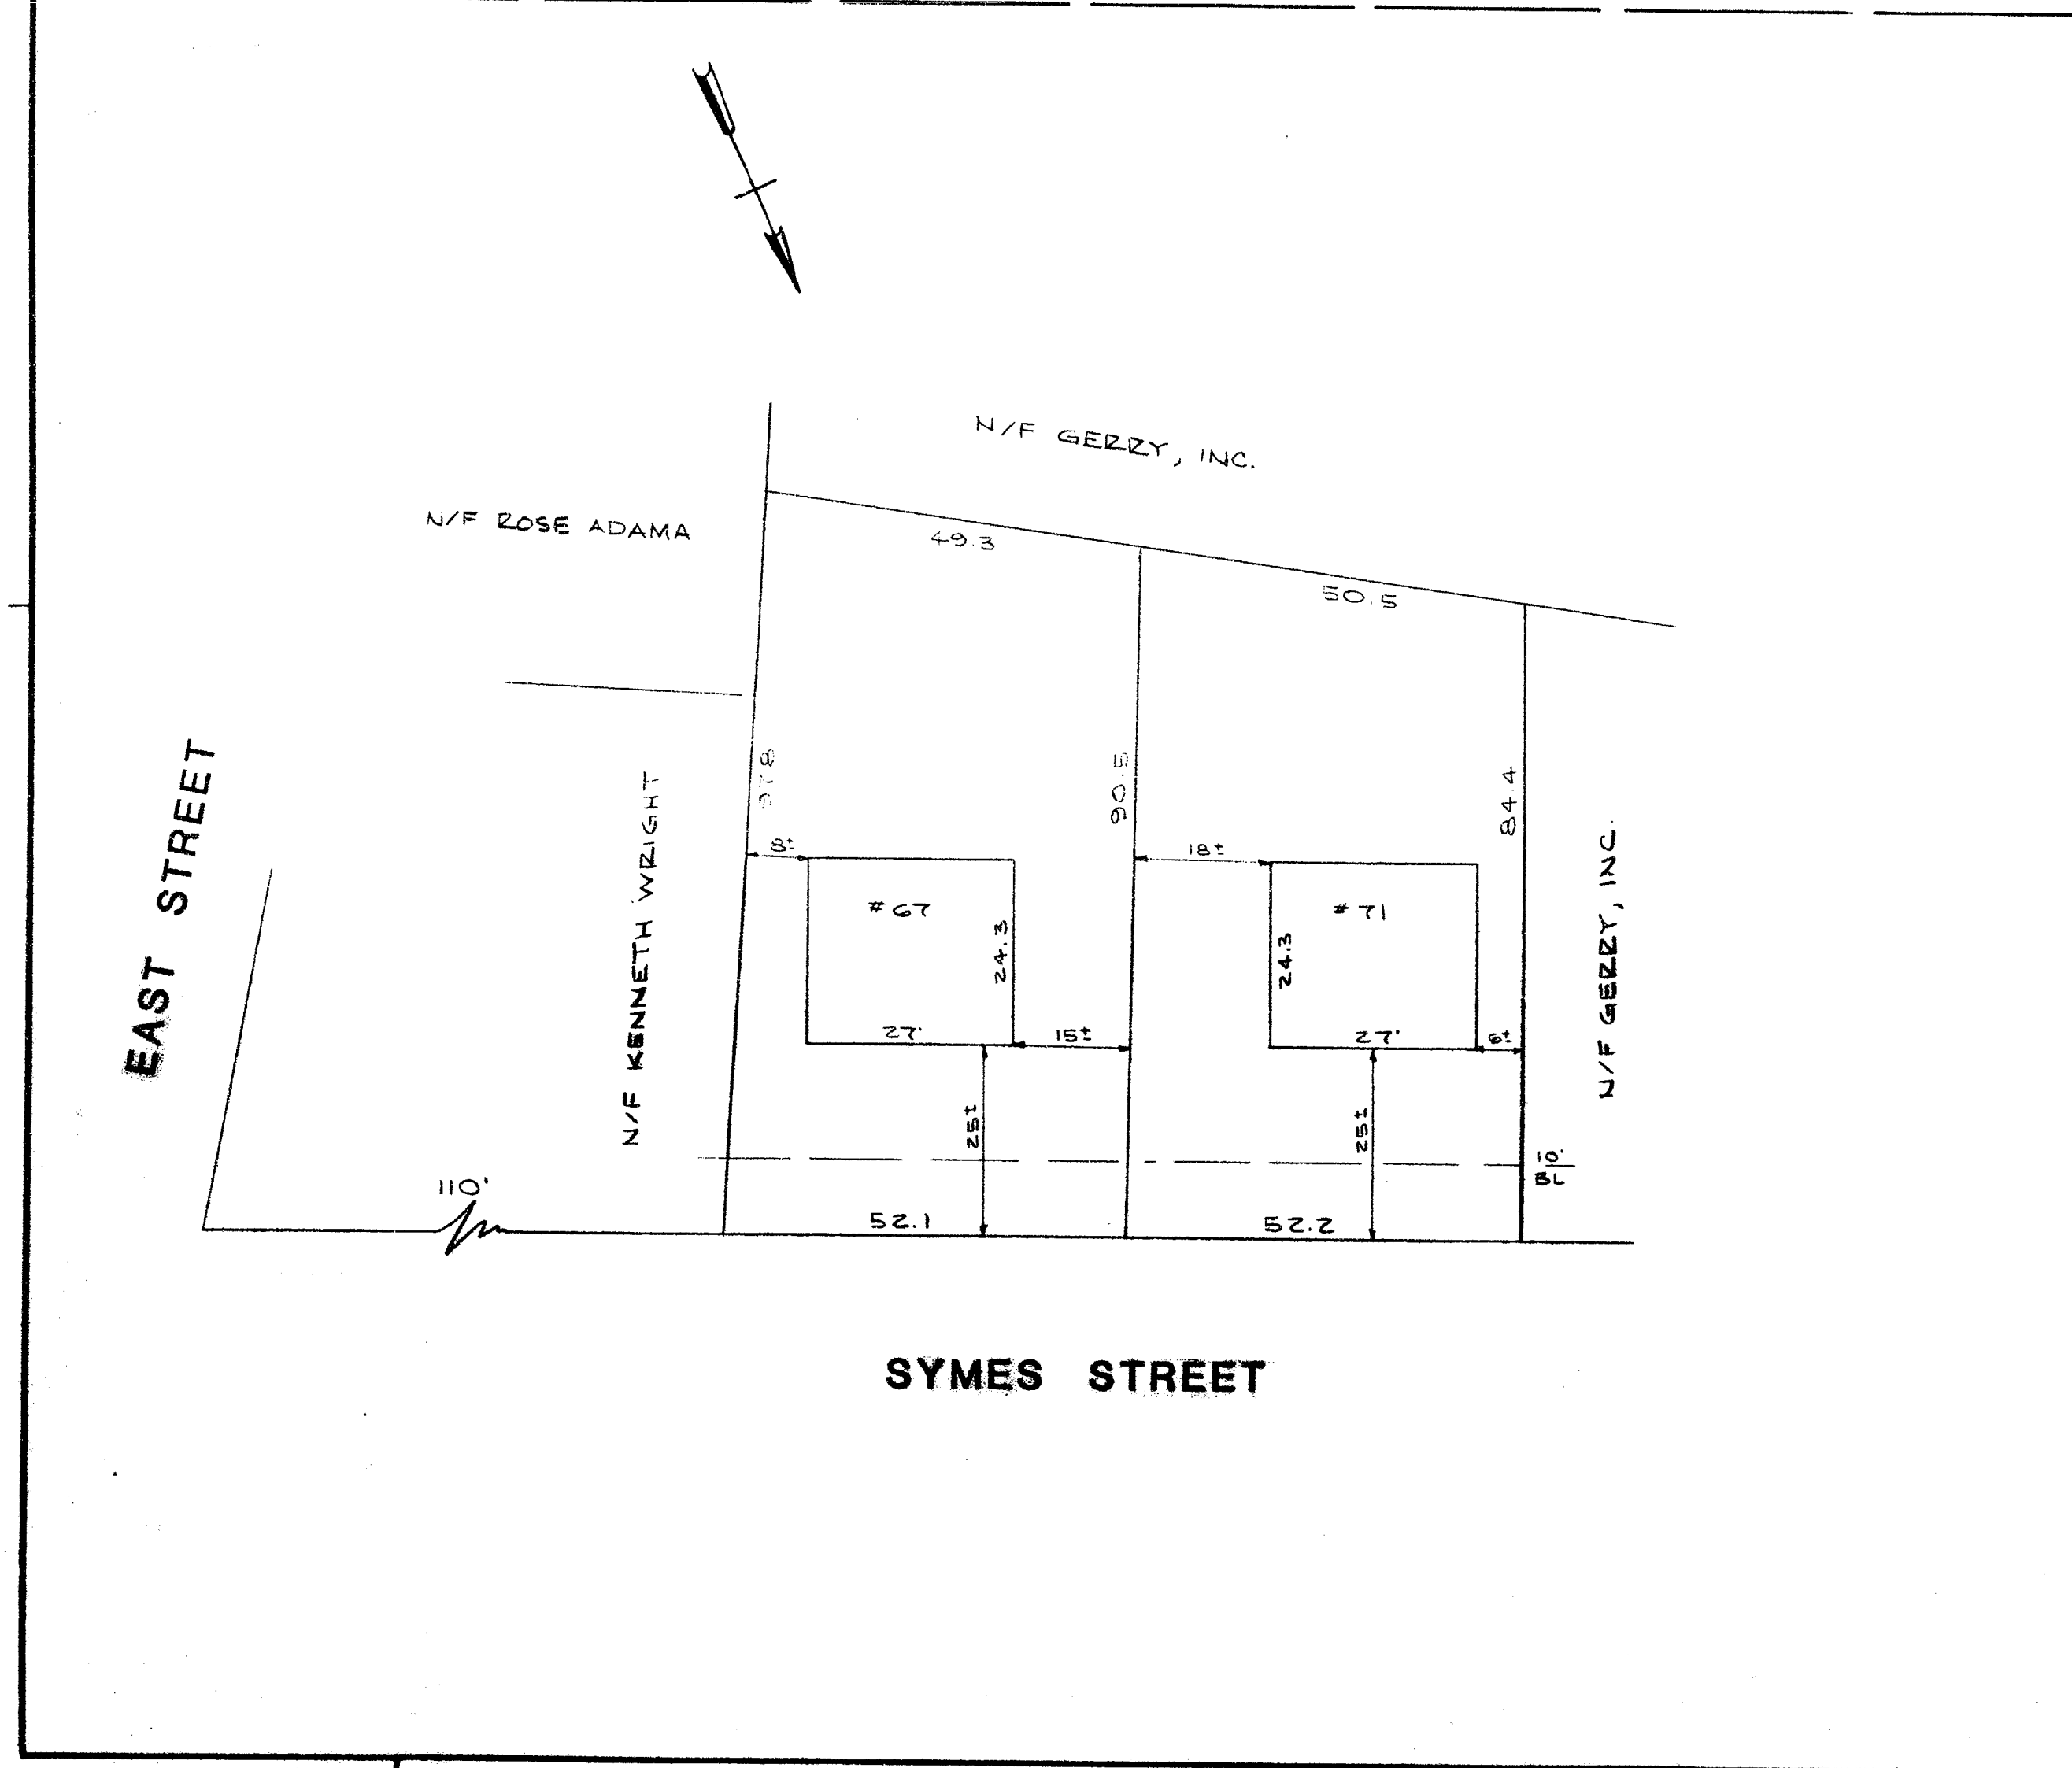


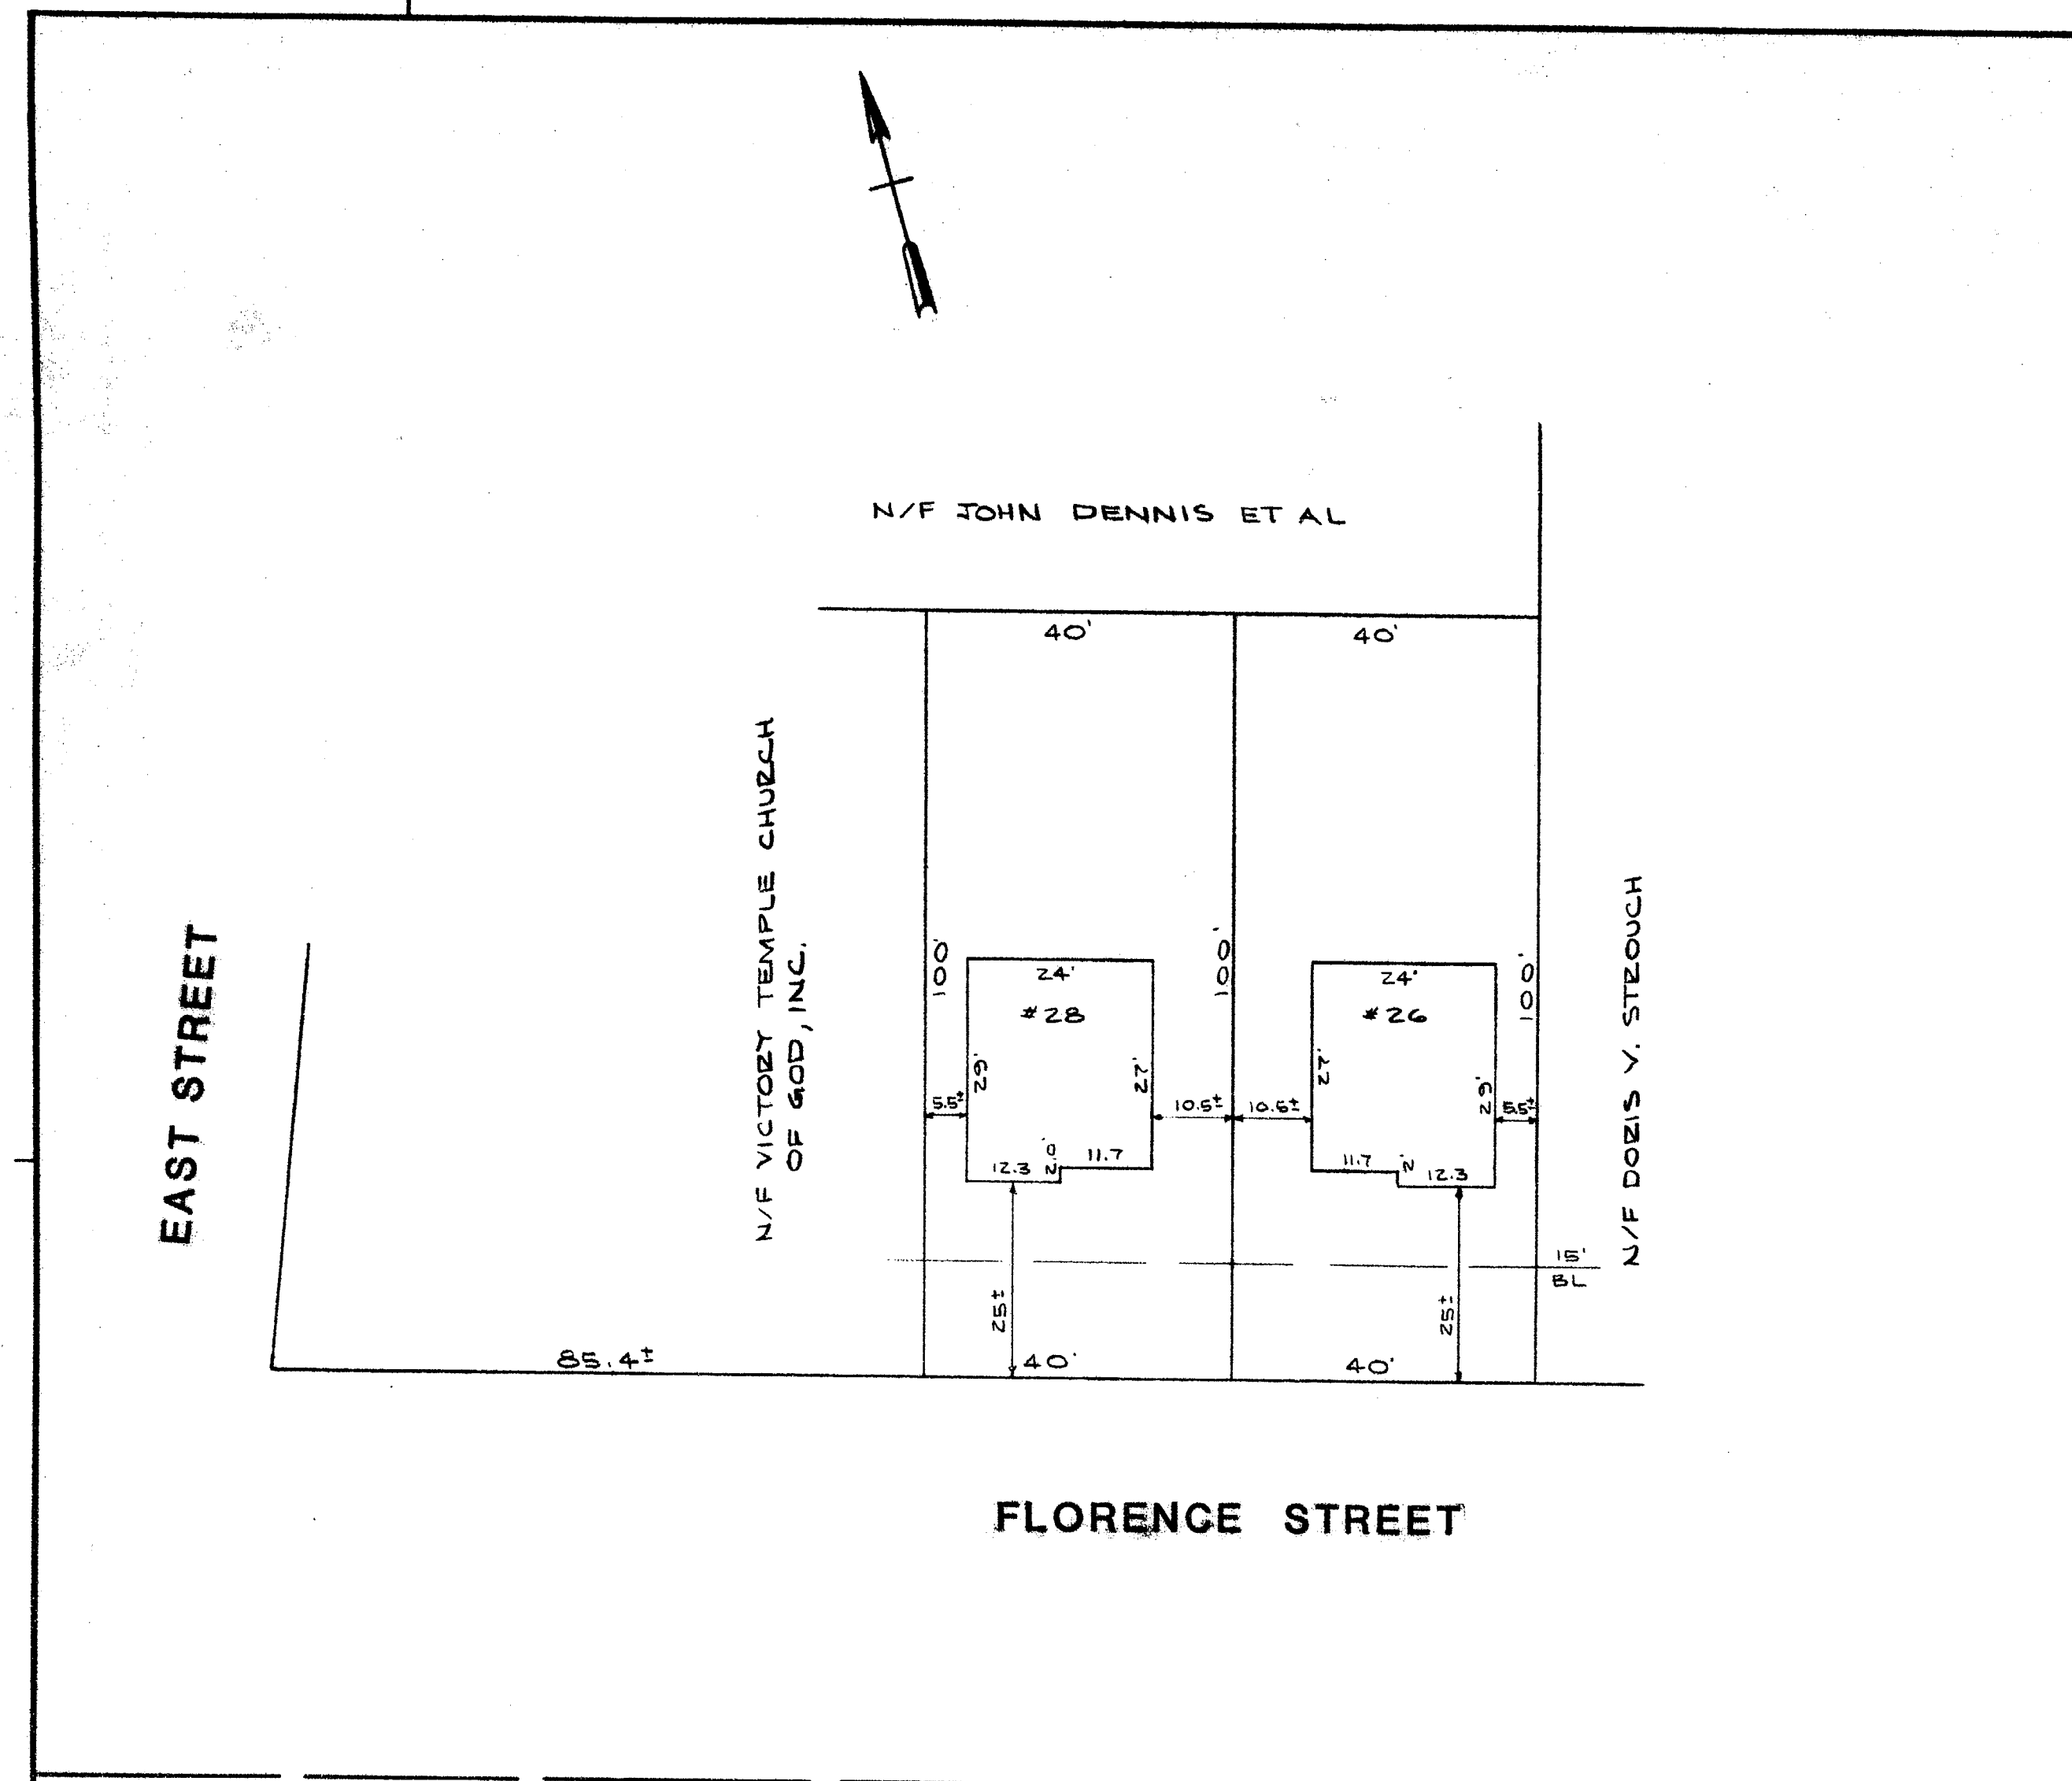

The portions of East St., Florence St., Hampton St., Montville St., Symes St. shown on this plan are established public streets of the City of Hartford.


2/10/83
Date

George A. Alfors
City Engineer

NOTE:
PARCELS A & B ARE SHOWN ON
A MAP ENTITLED "PROPERTY OF
THE CITY OF HARTFORD ON HAMPTON &
MONTVILLE STREETS IN HARTFORD CONN.
SCALE 1"=20' NOVEMBER 3, 1981"

FOUNDATIONS LOCATED AS SHOWN
NO ZONING VIOLATIONS

I HEREBY CERTIFY THAT THIS MAP COMPLIES WITH CLASS "D" CLASSIFICATION AS DEFINED BY CONNECTICUT ASSOCIATION OF LAND SURVEYORS, INC. <i>W. M. Alfors, Jr.</i>	
Alford ASSOCIATES CIVIL ENGINEERS WINDSOR, CONNECTICUT WILSON M. ALFORD, SR., P.E., S.E. WILSON M. ALFORD, JR., P.E., S.E.	
DATE	REVISION
DATE: JAN. 17, 1983	SCALE: 1 IN. = 20 FT.
PROPERTY OF DUTIL REALTY CORPORATION FLORENCE STREET SYMES STREET MONTVILLE STREET HARTFORD, CONN.	

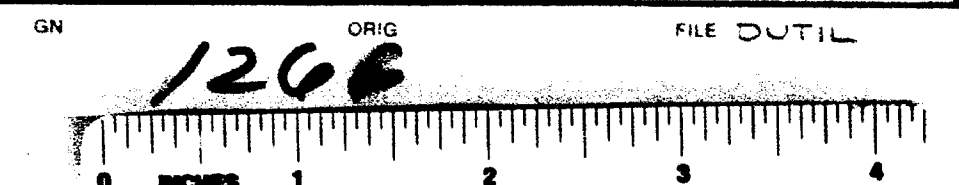

12621
