


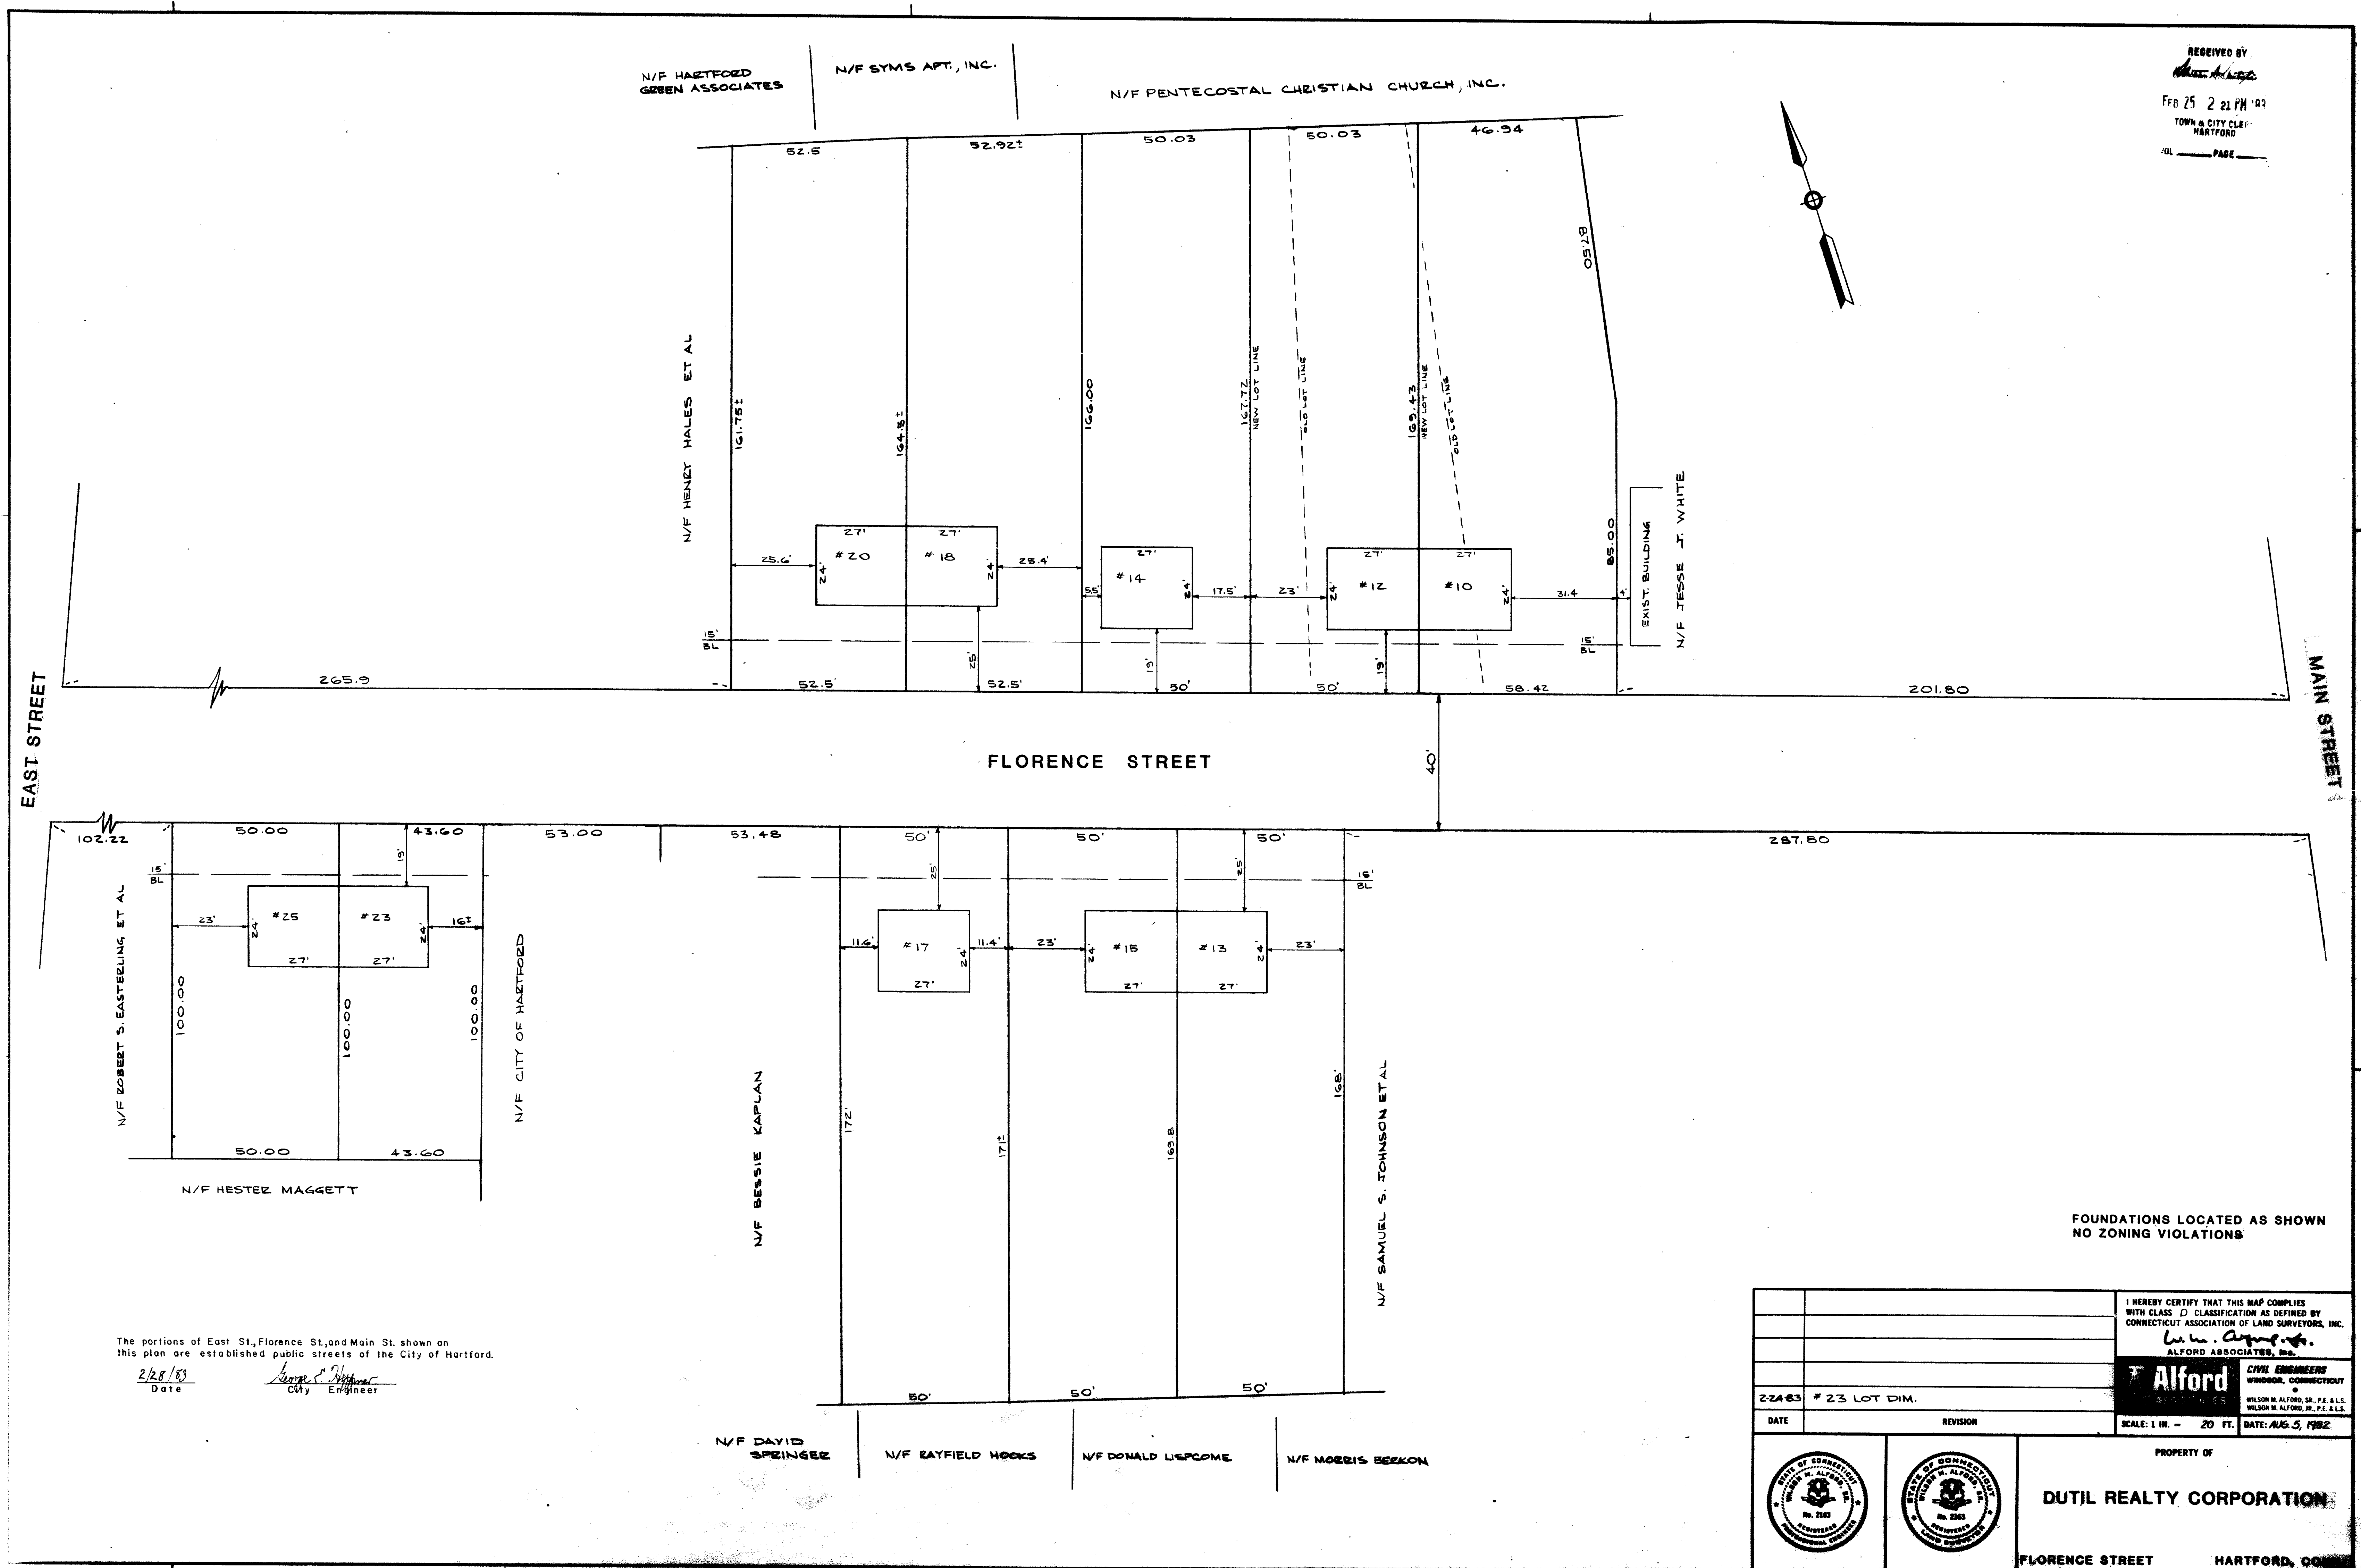

RECEIVED BY
FEB 25 2 21 PM '83
TOWN & CITY CLERK
HARTFORD
PAGE

1267

FOUNDATIONS LOCATED AS SHOWN
NO ZONING VIOLATIONS

The portions of East St., Florence St., and Main St. shown on
this plan are established public streets of the City of Hartford.
2/28/83
Date
City Engineer

I HEREBY CERTIFY THAT THIS MAP COMPLIES WITH CLASS D CLASSIFICATION AS DEFINED BY CONNECTICUT ASSOCIATION OF LAND SURVEYORS, INC. <i>Wm. A. Alford, Jr.</i> ALFORD ASSOCIATES, INC.	
Alford CIVIL ENGINEERS WINDSOR, CONNECTICUT WILSON H. ALFORD, JR., P.E., L.L.S. WILSON H. ALFORD, JR., P.E., L.L.S.	
2-2463	# 23 LOT DIM.
DATE	REVISION
SCALE: 1 IN. = 20 FT. DATE: AUG. 5, 1982	
PROPERTY OF DUTIL REALTY CORPORATION FLORENCE STREET HARTFORD, CT	

