


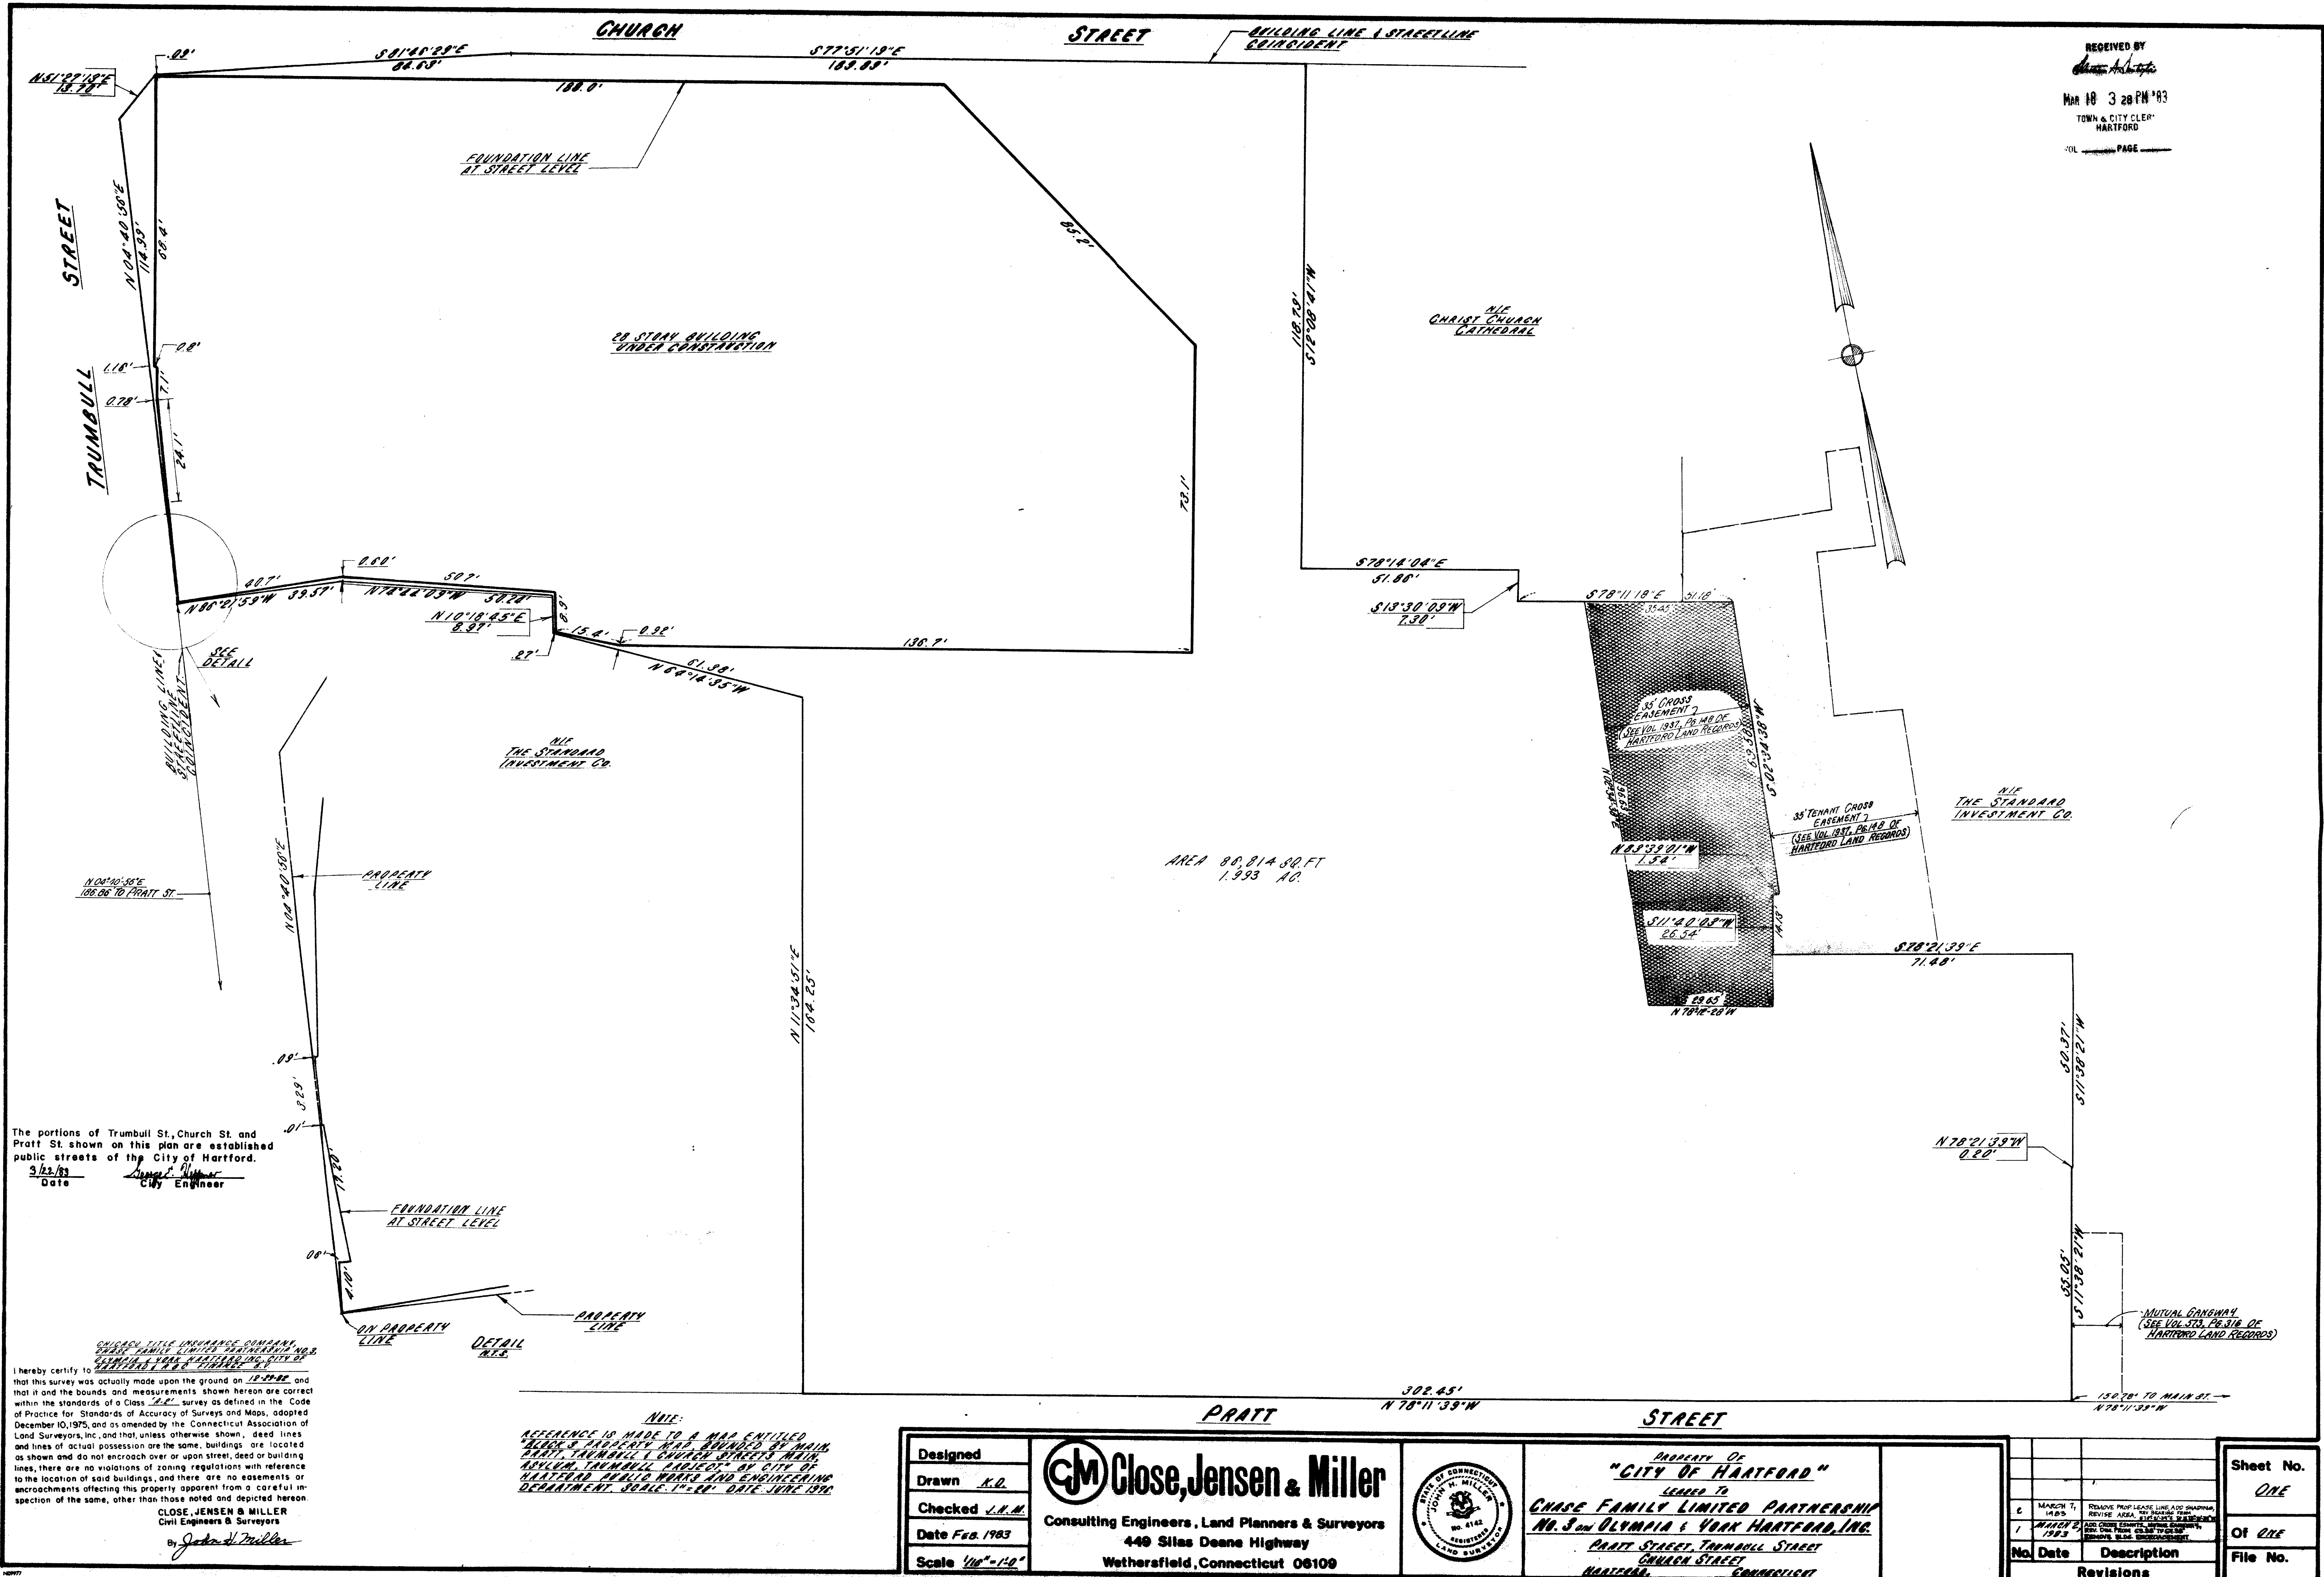

1272