
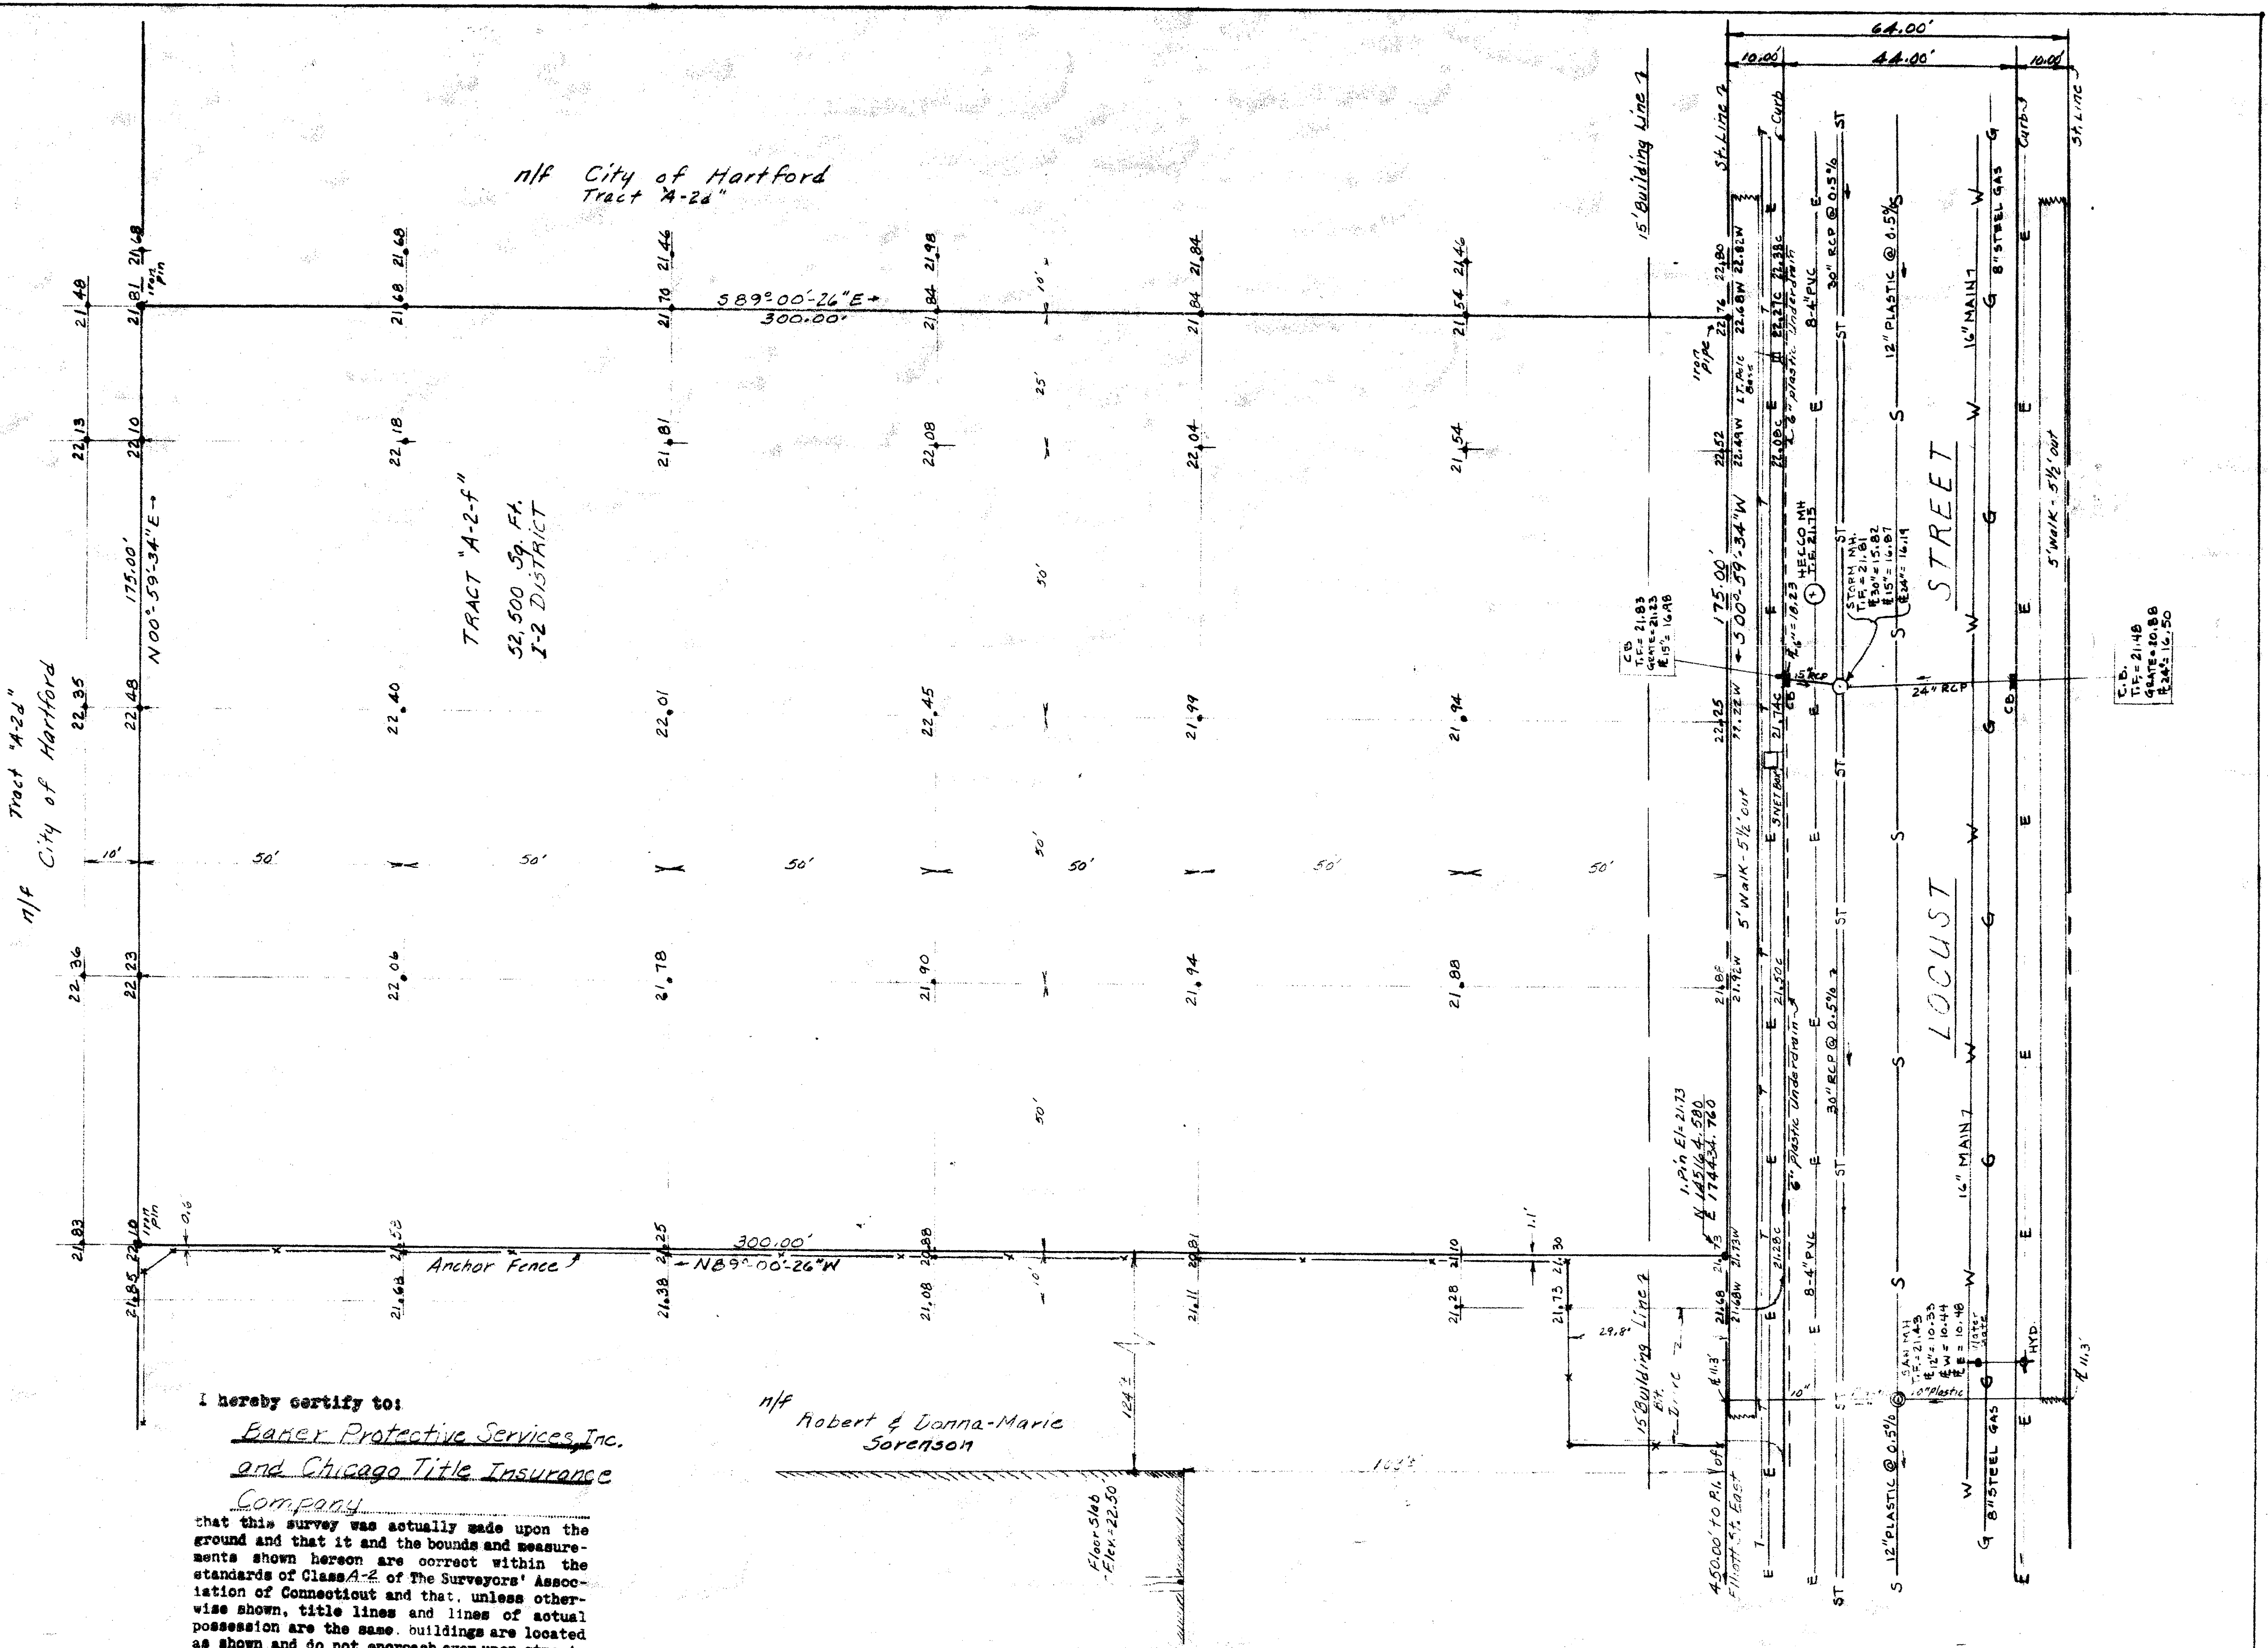


475490

RECEIVED BY
MAR 18 3 25 PM '83
TOWN & CITY CLERK
HARTFORD
VOL PAGE

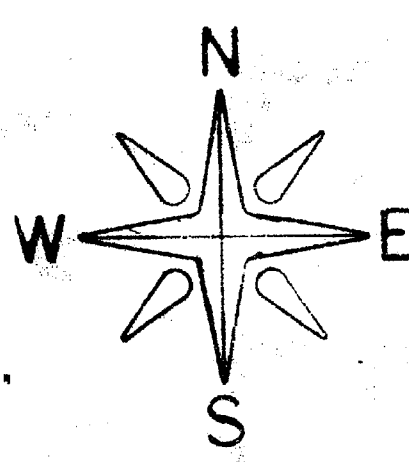

I hereby certify to:
Baker Protective Services, Inc.
and Chicago Title Insurance
Company

that this survey was actually made upon the ground and that it and the bounds and measurements shown hereon are correct within the standards of Class A-2 of The Surveyors' Association of Connecticut and that, unless otherwise shown, title lines and lines of actual possession are the same. Buildings are located as shown and do not encroach over upon street, title or building lines, there are no violations of zoning regulations with reference to the location of said buildings, and there are no easements or encroachments affecting this property apparent from a careful inspection of the same.
James J. D'Onofrio
Francis T. D'Onofrio
Comm. L.S. 8493 Date Mar. 5, 1983

The portion of Locust St. shown on this plan is an established public street of the City of Hartford.

4/14/83
Date
George E. D'Onofrio
City Engineer



LEGEND
T Telephone
G Gas
W Water
S Sanitary
ST Storm

Notes
(1) Elevations based on Metropolitan District Datum
(2) Bearings & coordinates based on Metropolitan District Grid System

COLT PARK SOUTH PROJECT
LAND TO BE ACQUIRED BY
BAKER PROTECTIVE SERVICES, INC.
HARTFORD, CONN.
SCALE: 1"=20' MAR. 5, 1983

