


EASI FILE CORP. IRVINE, CA EPH 34
1278

1278-2

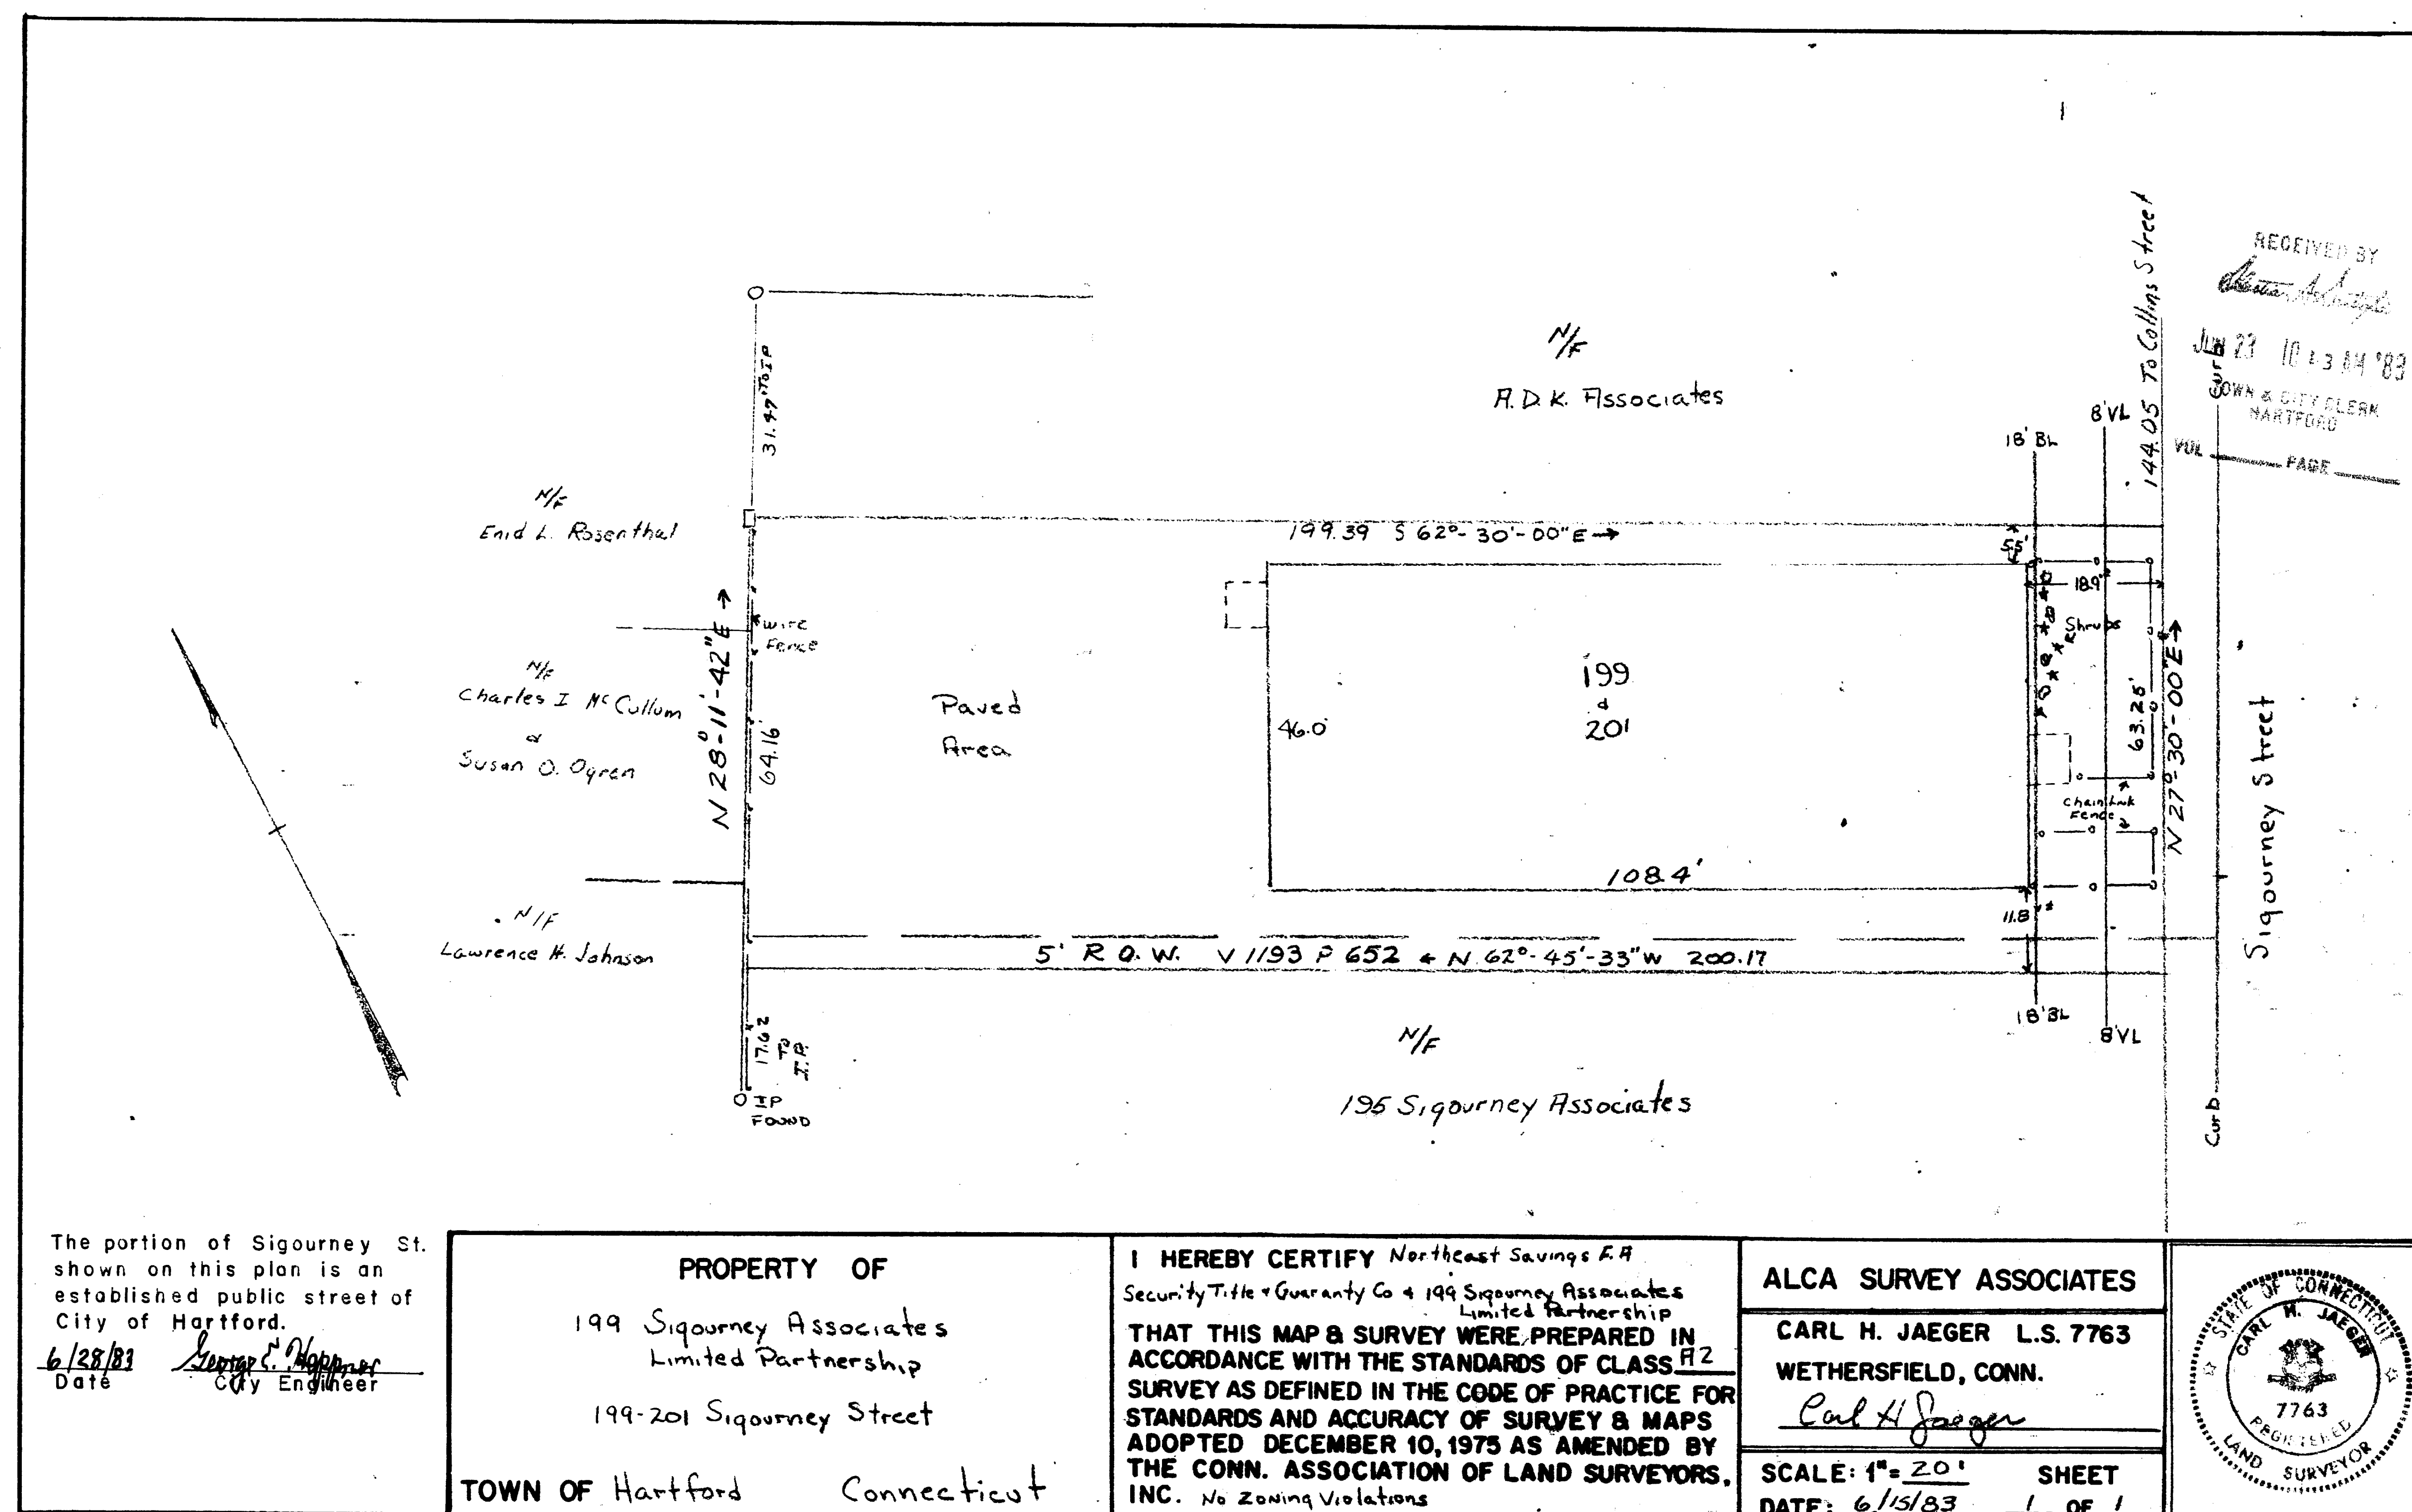

0 INCHES 1 2 3 4