


01287

RECEIVED BY
DATE
TIME

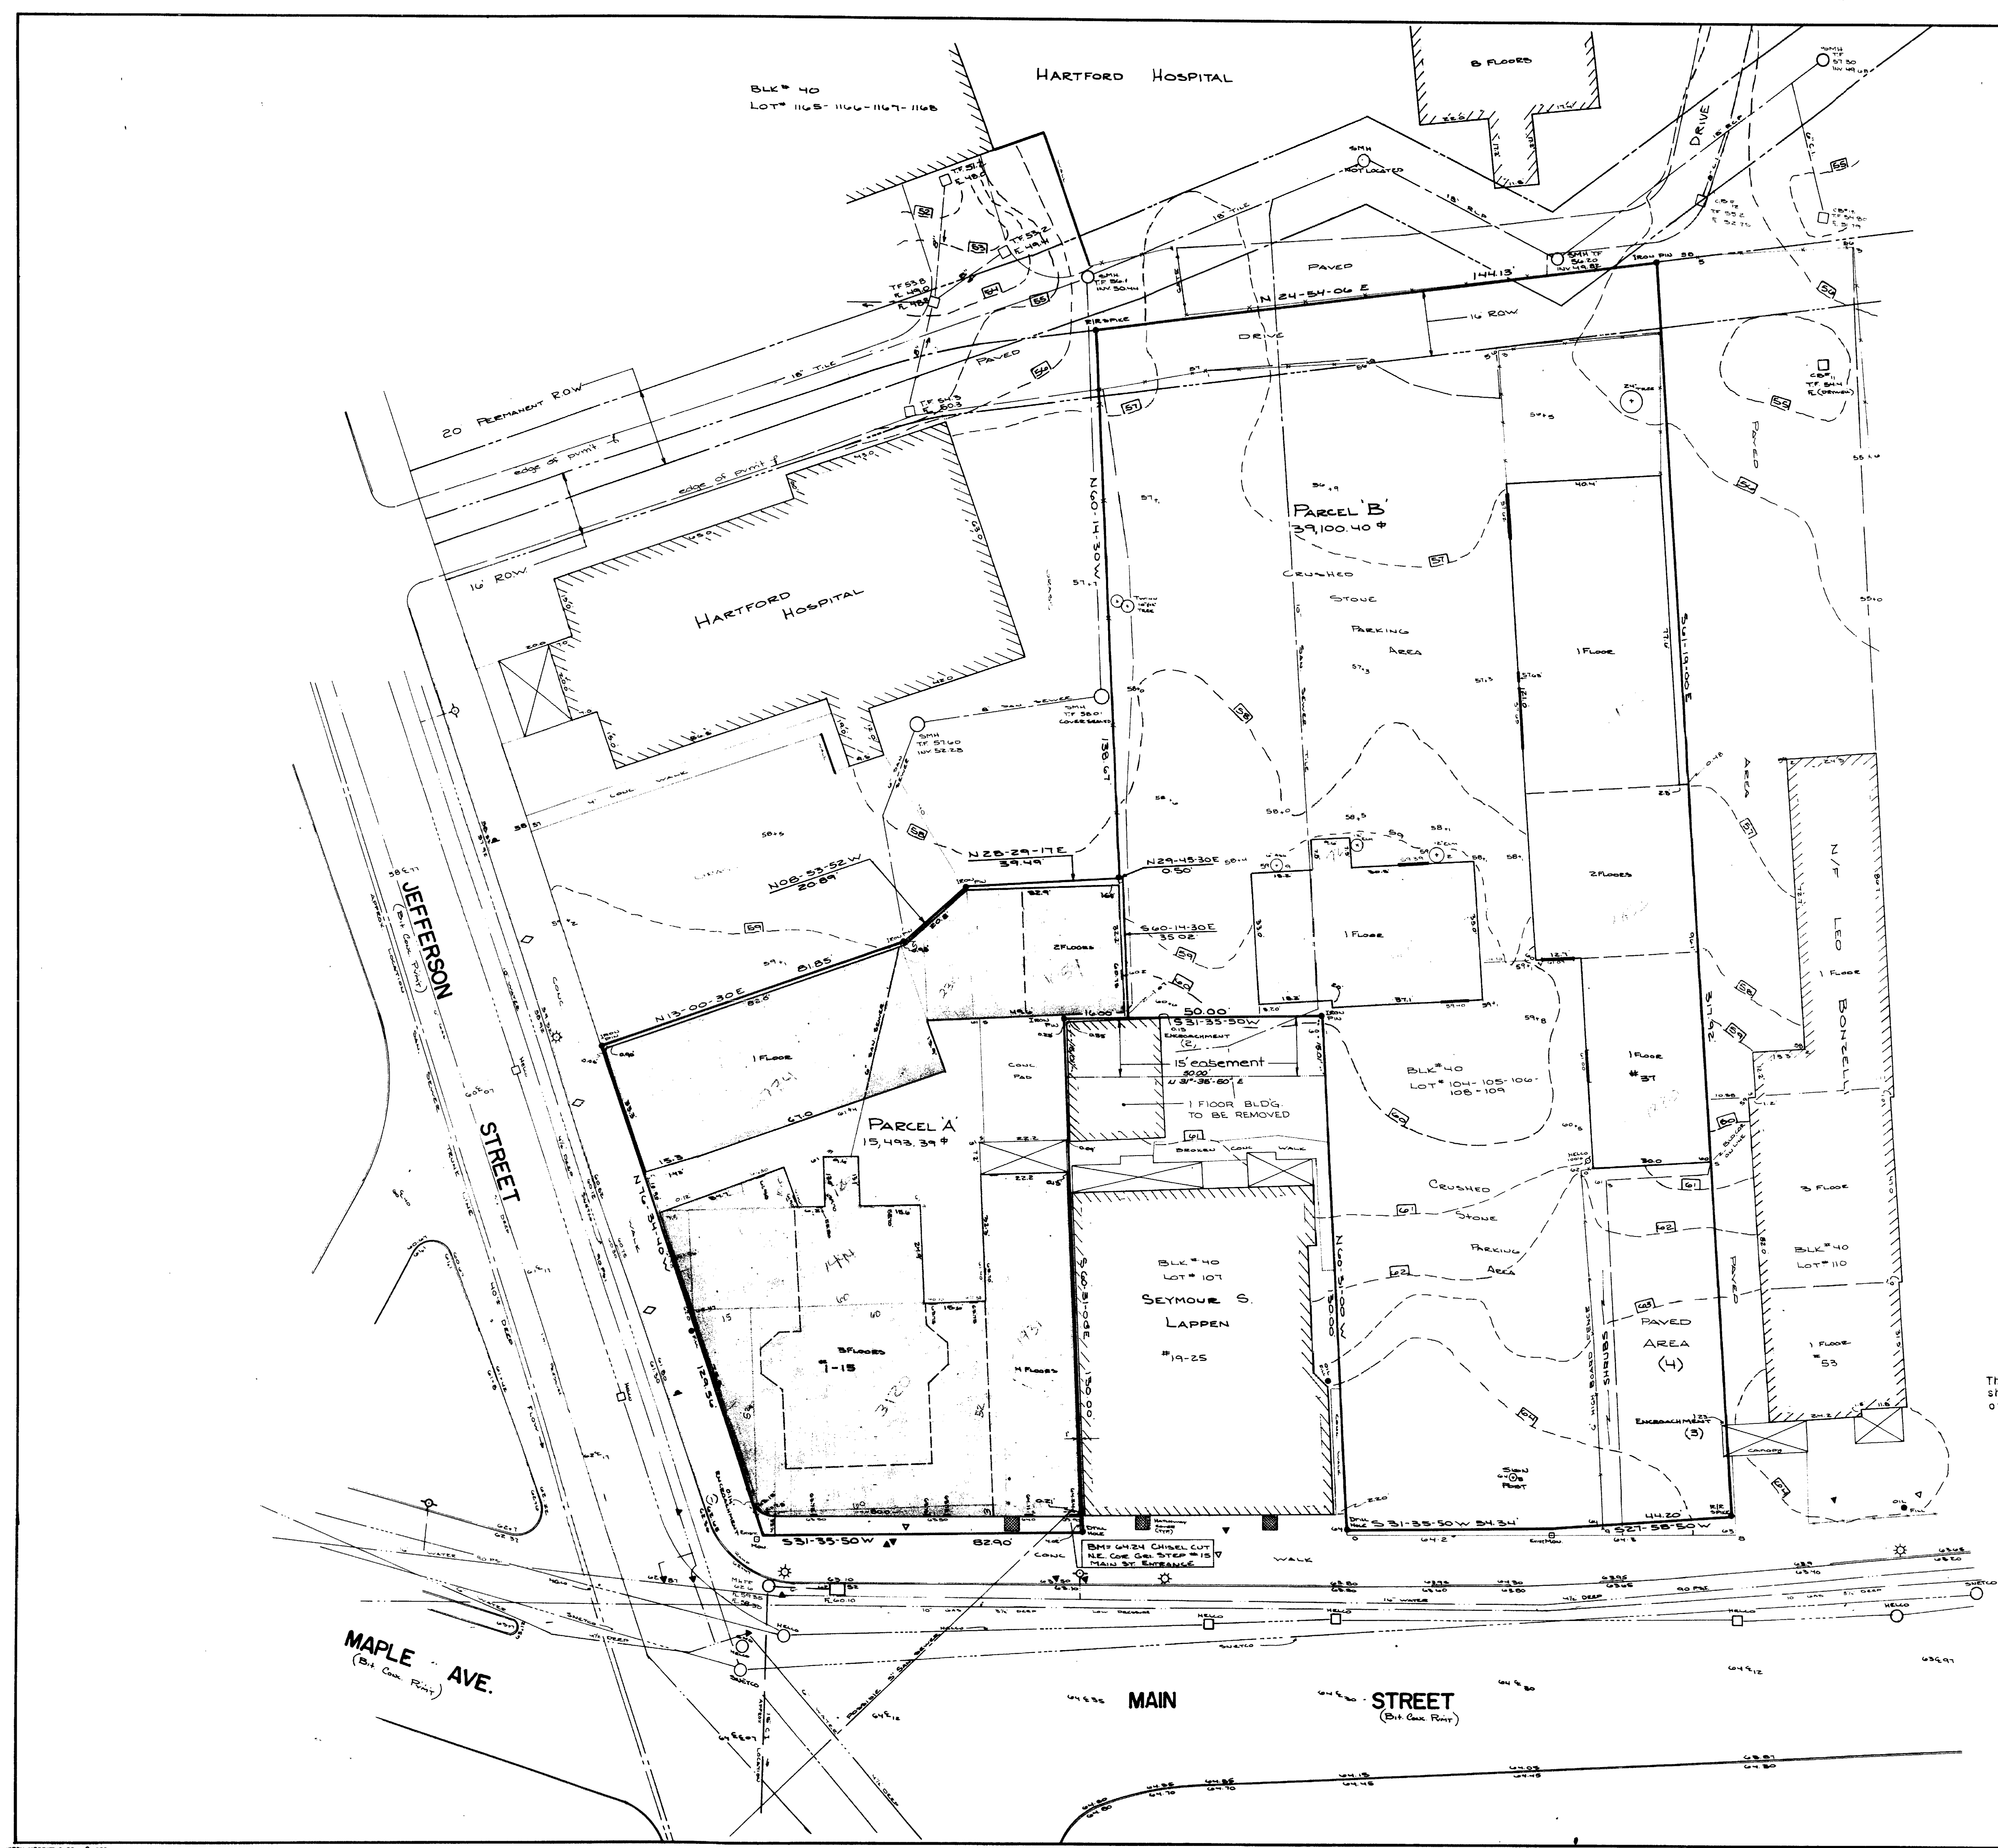

- NOTES
- (1) BUILDING ENCROACHES OVER STREET LINE.
 - (2) BUILDING ENCROACHES OVER PROPERTY LINE.
 - (3) CANOPY ENCROACHES OVER PROPERTY LINE.
 - (4) PAVED AREA USED BY ADJACENT PROPERTY (53 MAIN ST)

LEGEND

- SQUARE MANHOLE OR CATCH BASIN
 - CIRCLE MANHOLE
 - FIRE HYDRANT
 - LAMP POST
 - PARKING METER
 - TRAFFIC SIGN
 - WATER GATE
 - WATER LINE
 - GAS LINE
 - SHIELD CABLE
 - HELIX CABLE
 - SAN SEWER LINE
 - SAN SEWER LINE (TRUNK)
 - FENCE
 - EXISTING COUNTRY
 - EXISTING SPOT ELEV.
 - (1) NOTE NUMBER
- TOTAL AREA PARCEL A & B: 54,593.79 SQ FT / 1.253 AC


The portions of Jefferson St, Maple Ave, and Main St shown on this plan are established public streets of the City of Hartford.

5/10/83
Date
City Engineer

Certified Substantially Correct
Class A-2

James R. Peterson L.S. 10839

SITE PLAN JEFFERSON COURT HARTFORD, CONNECTICUT				
GARDNER & PETERSON ASSOCIATES 576 OLD POST ROAD TOLLAND, CONNECTICUT PROFESSIONAL ENGINEERS LAND SURVEYORS				
REVISIONS 4-11-83	BY	SCALE	DATE	SHEET NO.
	RHH	1" = 20'	9-9-82	OF 587C

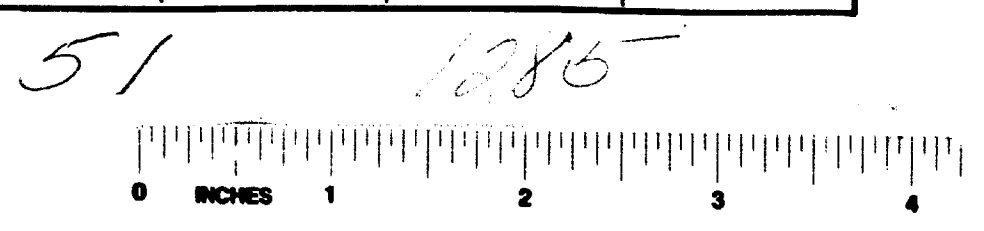

1285