1294-1

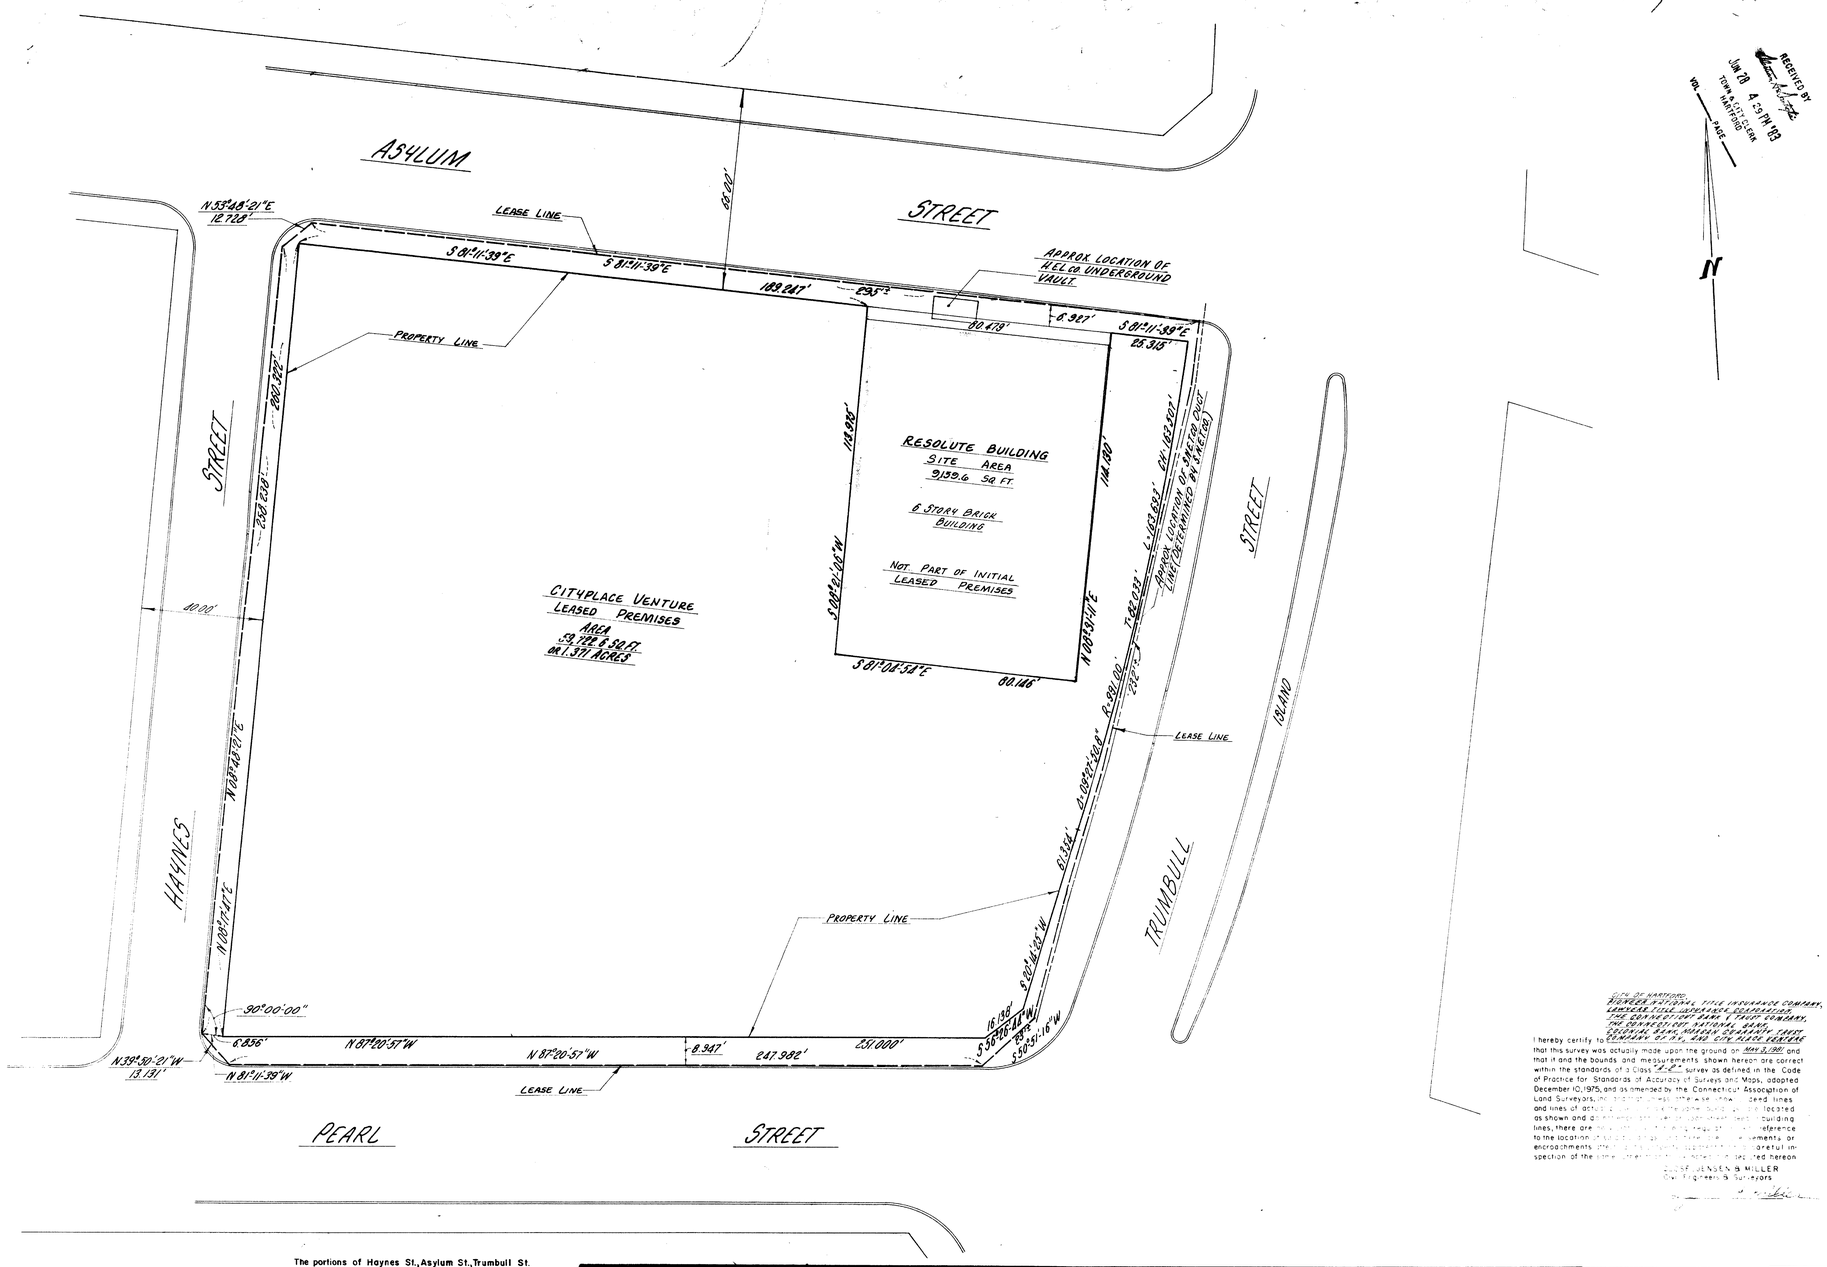

RECEIVED BY
TOWN & CITY CLERK
HARTFORD
VOL. PAGE

The portions of Haynes St., Asylum St., Trumbull St. and Pearl St. shown on this plan are established public streets of the City of Hartford.

7/1/93 Date — George F. Wolcott, City Engineer

CITY OF HARTFORD,
LAWYERS TITLE INSURANCE CORPORATION,
THE CONNECTICUT BANK & TRUST COMPANY,
THE CONNECTICUT NATIONAL BANK,

I hereby certify to the [illegible] that this survey was actually made upon the ground on MAY 3, 1991 and that it and the bounds and measurements shown hereon are correct within the standards of a Class "A-2" survey as defined in the Code of Practice for Standards of Accuracy of Surveys and Maps, adopted December 10, 1975, and as amended by the Connecticut Association of Land Surveyors, Inc. [illegible] unless otherwise shown, deed lines and lines of actual [illegible] located as shown and do not [illegible] building lines, there are no [illegible] reference to the location of [illegible] easements, or encroachments other than those shown hereon based upon careful inspection of the premises [illegible] located hereon

CLOSE JENSEN & MILLER
Civil Engineers & Surveyors

Designed	
Drawn	R.B.B.
Checked	J.H.M.
Date	MAY 1991
Scale	1"=20'

Close, Jensen & Miller
Consulting Engineers, Land Planners & Surveyors
449 Silas Deane Highway
Wethersfield, Connecticut 06109

STATE OF CONNECTICUT — JOHN H. MILLER — No. 4142 — REGISTERED LAND SURVEYOR

PREMISES TO BE CONVEYED TO
CITY OF HARTFORD
AND TO BE LEASED TO
CITYPLACE VENTURE
HAYNES STREET, ASYLUM STREET,
TRUMBULL STREET & PEARL STREET
HARTFORD, CONNECTICUT

No.	Date	Description
		Revisions

Sheet No. 2
Of 2
File No. M-1600

#63

1294

0 INCHES 1 2 3 4