


07570
 RECEIVED
 APR 11 1983
 CITY OF HARTFORD
 ENGINEERING DEPARTMENT

THE UNDERSIGNED UTILITY EMPLOYEE
 CERTIFIES THIS MAP TO BE
 "SUBSTANTIALLY CORRECT" AND IN
 ACCORDANCE WITH CLASS D OF CODE
 OF CONN. TECHNICAL COUNCIL, INC.
 PER *Thomas J. Shea*

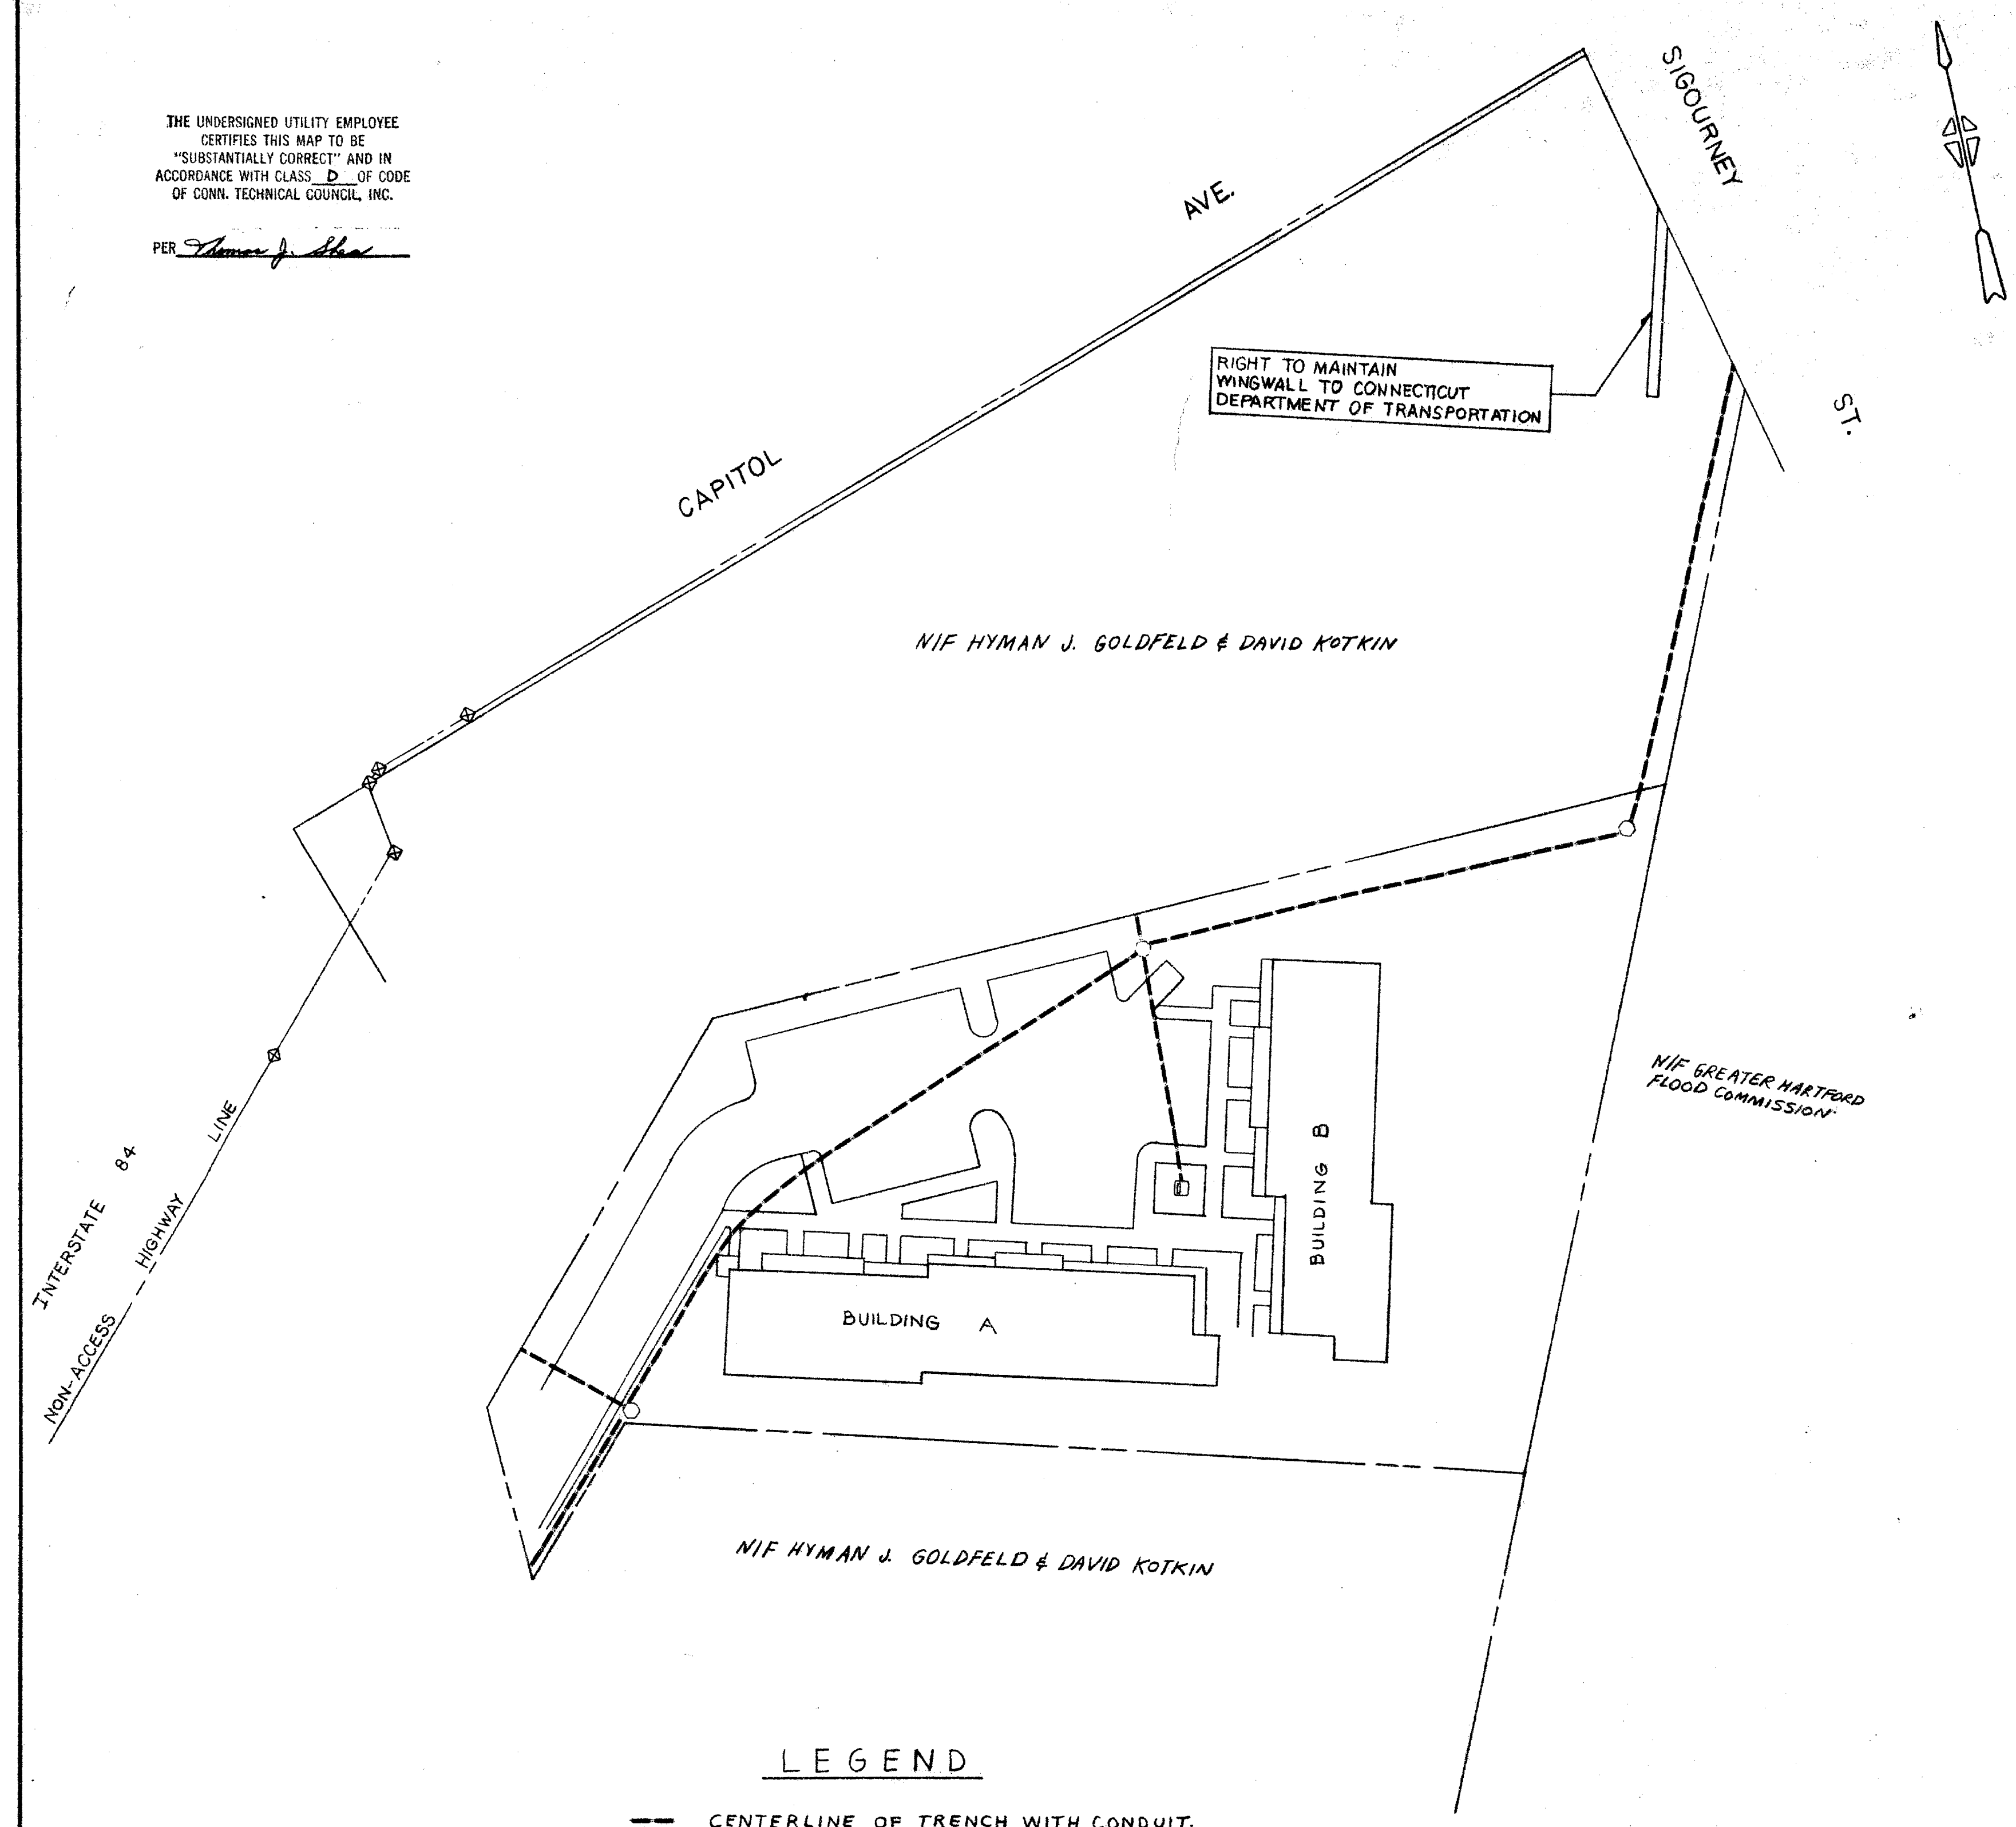

LEGEND

- CENTERLINE OF TRENCH WITH CONDUIT.
- PRECAST HEX-HOLE.
- PRECAST TRANSFORMER PAD, SINGLE PHASE.

The portion of Capitol Ave. shown on this plan
 is an established public street of the City of Hartford.
 The portion of Sigourney St. is City maintained.
 Interstate 84 is State Hwy.
 Date *8/10/82* City Engineer *George P. [Signature]*

THIS SKETCH COMPILED FROM TWO MAPS. ONE ENTITLED CITY OF HARTFORD
 TOPOGRAPHIC MAP, PROPERTY OF HYMAN J. GOLDFELD & DAVID KOTKIN
 (FORMER UNDERWOOD SITE) CE MAGUIRE, INC., ARCHITECTS-ENGINEERS-
 PLANNERS, SCALE 1"=40' DATE AUGUST 17, 1982. THE OTHER MAP
 ENTITLED LAUREL VILLAGE HARTFORD, CONN. SITE PLAN LOW RISE
 BUILDINGS, ARCHITECTS/PLANNERS, MAITLAND/STRAUSS/BEHR,
 ARCHITECTS, P.C. 80 MANSON STREET, GREENWICH, CONNECTICUT
 SCALE: AS NOTED DATE: 8-30-82 NO. SU-1

DRAWN BY T.J.S. DATE: 3-23-83
 CHECKED BY SKK DATE: 4/4/83
 APPROVED BY RLC DATE: 4/4/83

NO.	DATE	DESCRIPTION	BY

THE CONNECTICUT LIGHT & POWER COMPANY
 FACILITIES ON THE PROPERTY OF
 UNDERWOOD ASSOCIATES LIMITED PARTNERSHIP,
 LAUREL STREET, BUILDING A AND B,
 HARTFORD, CONNECTICUT
 SCALE: 1"=40' NO. E-CJOSH7-1185
 DATE: 3-23-83

1305

1305 #82

