


51770 #
RECEIVED BY
68 MAR 11 1983
ARCHITECTS
3049



1306

1306

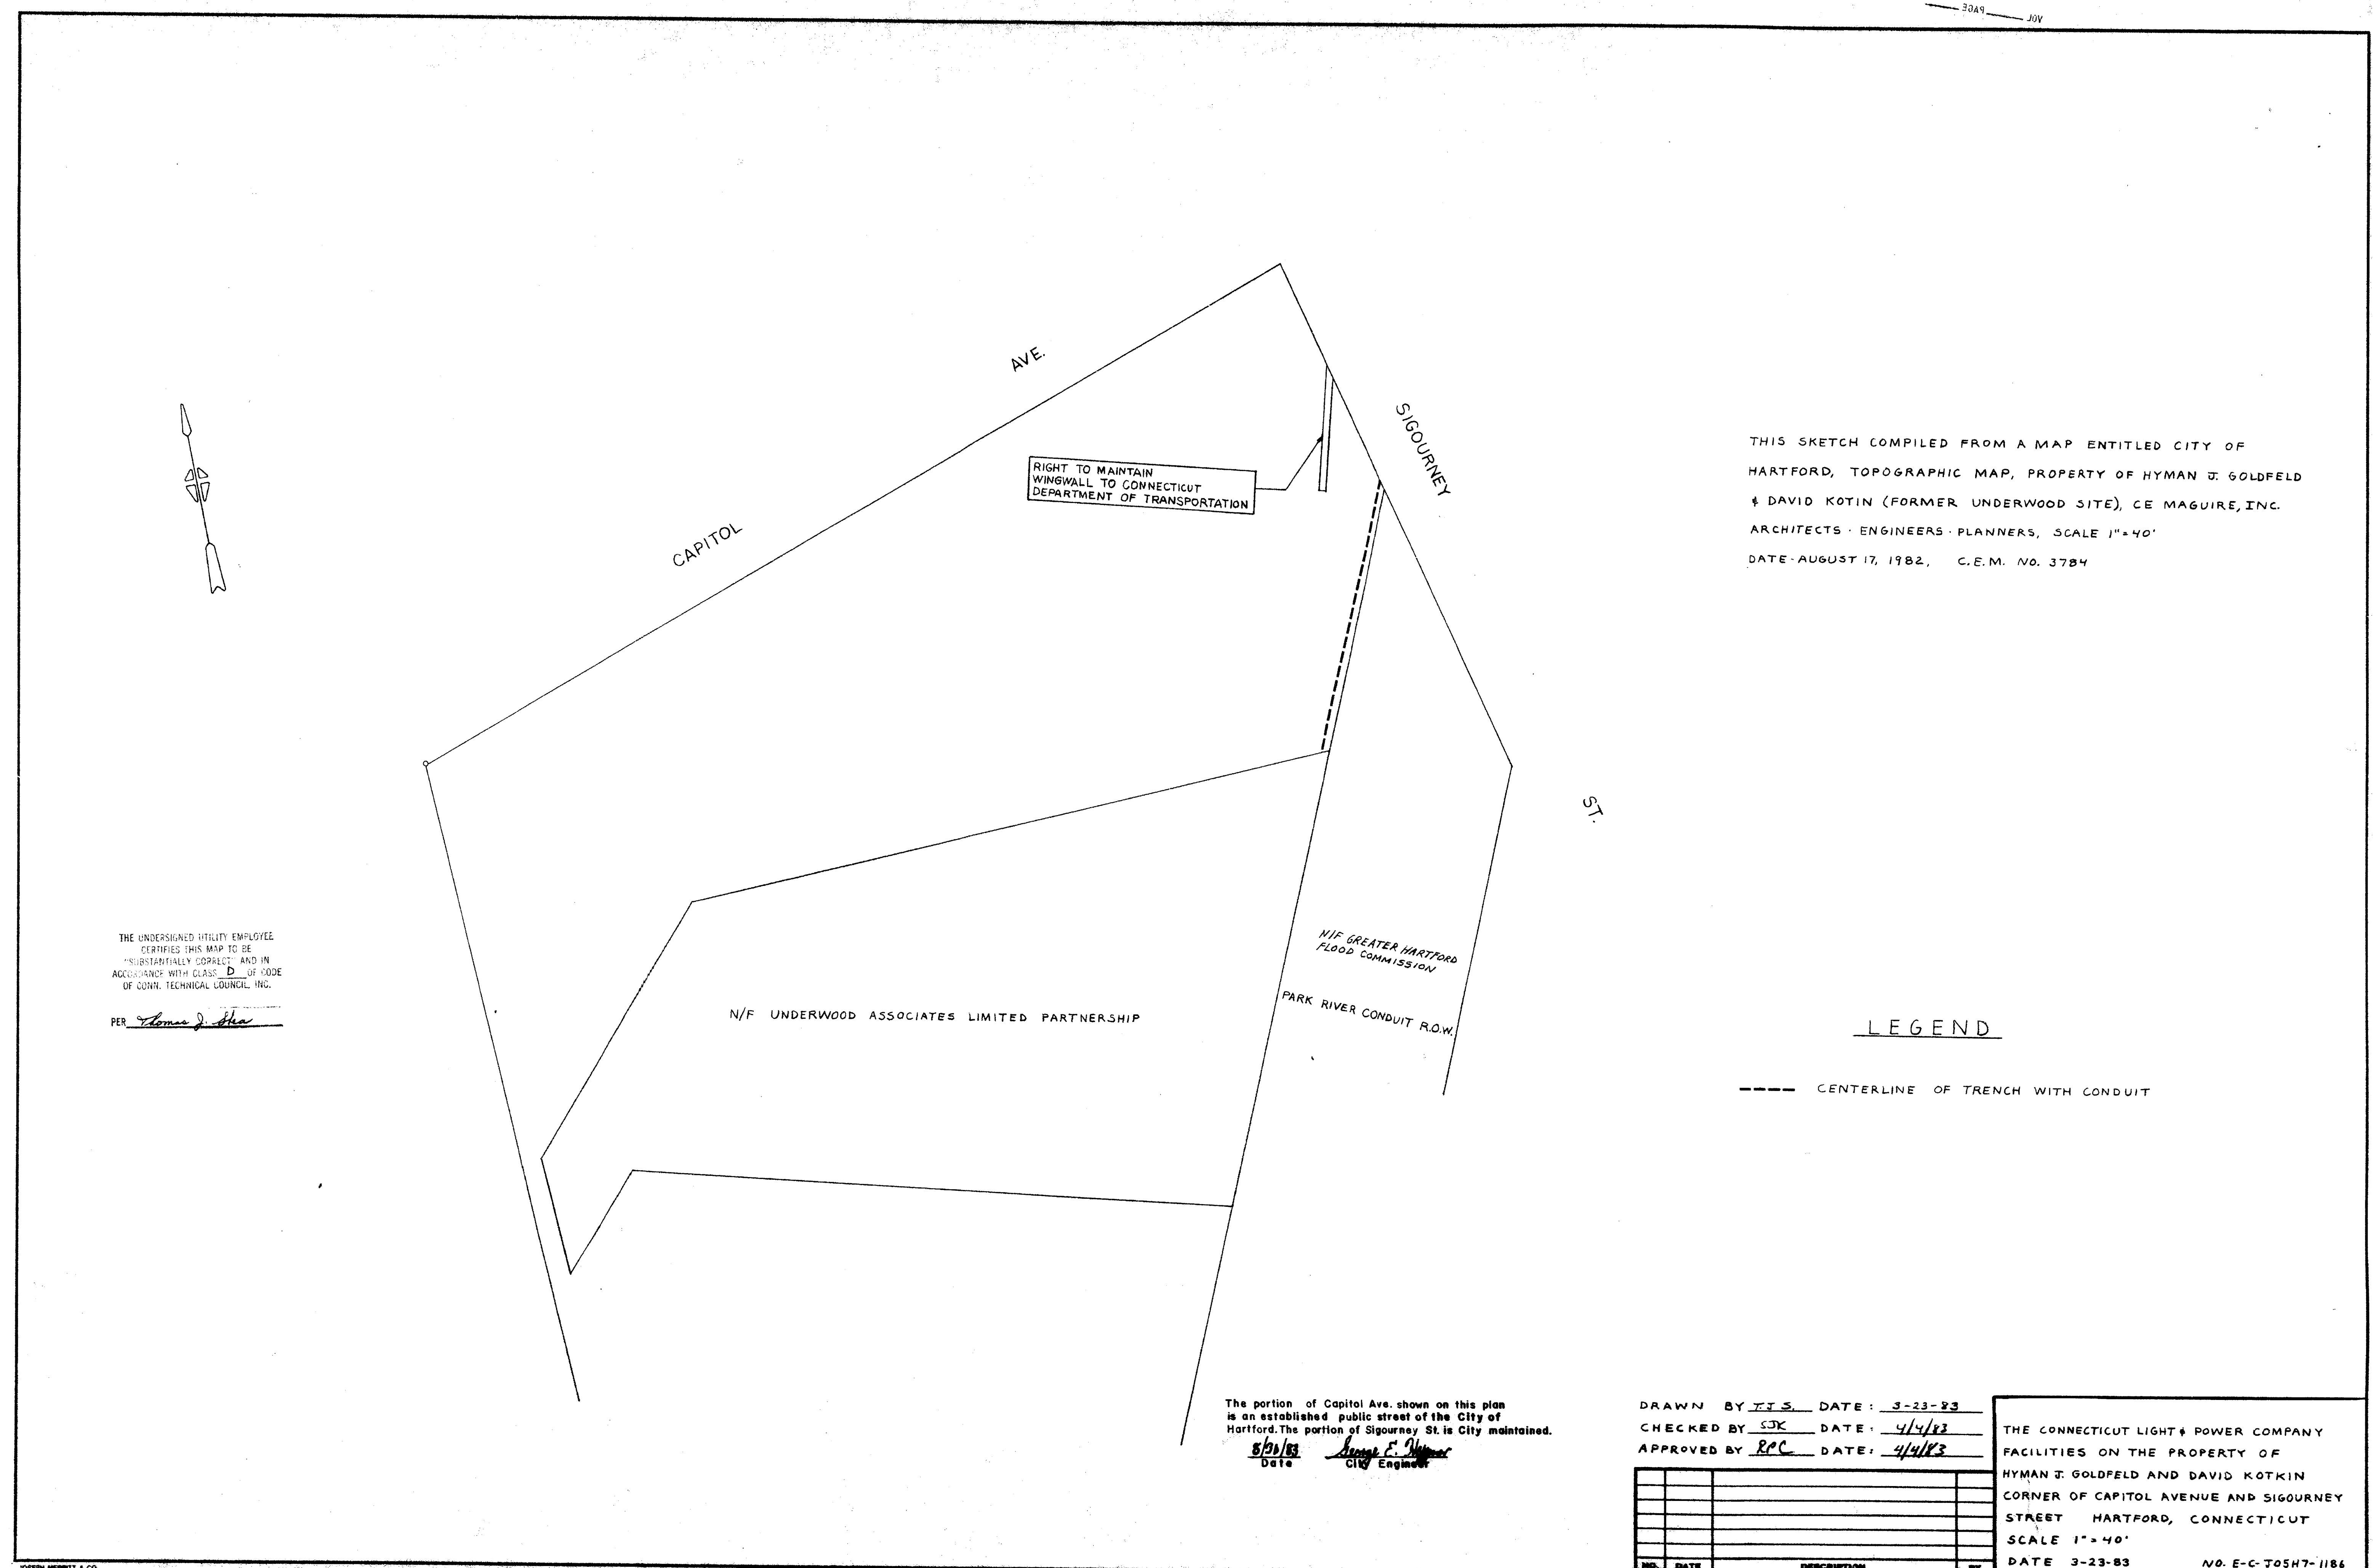