
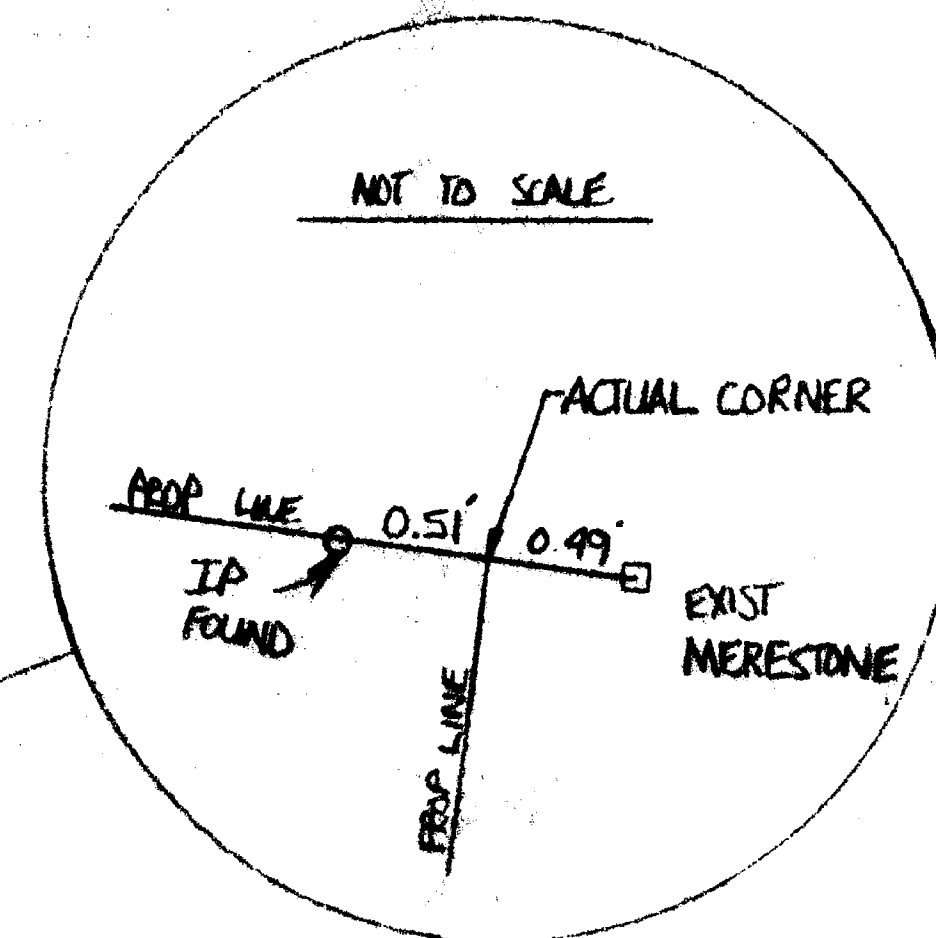


RECEIVED BY
 SEP 30 1 27 PM '83
 TOWN CLERK
 HARTFORD
 VOL PAGE

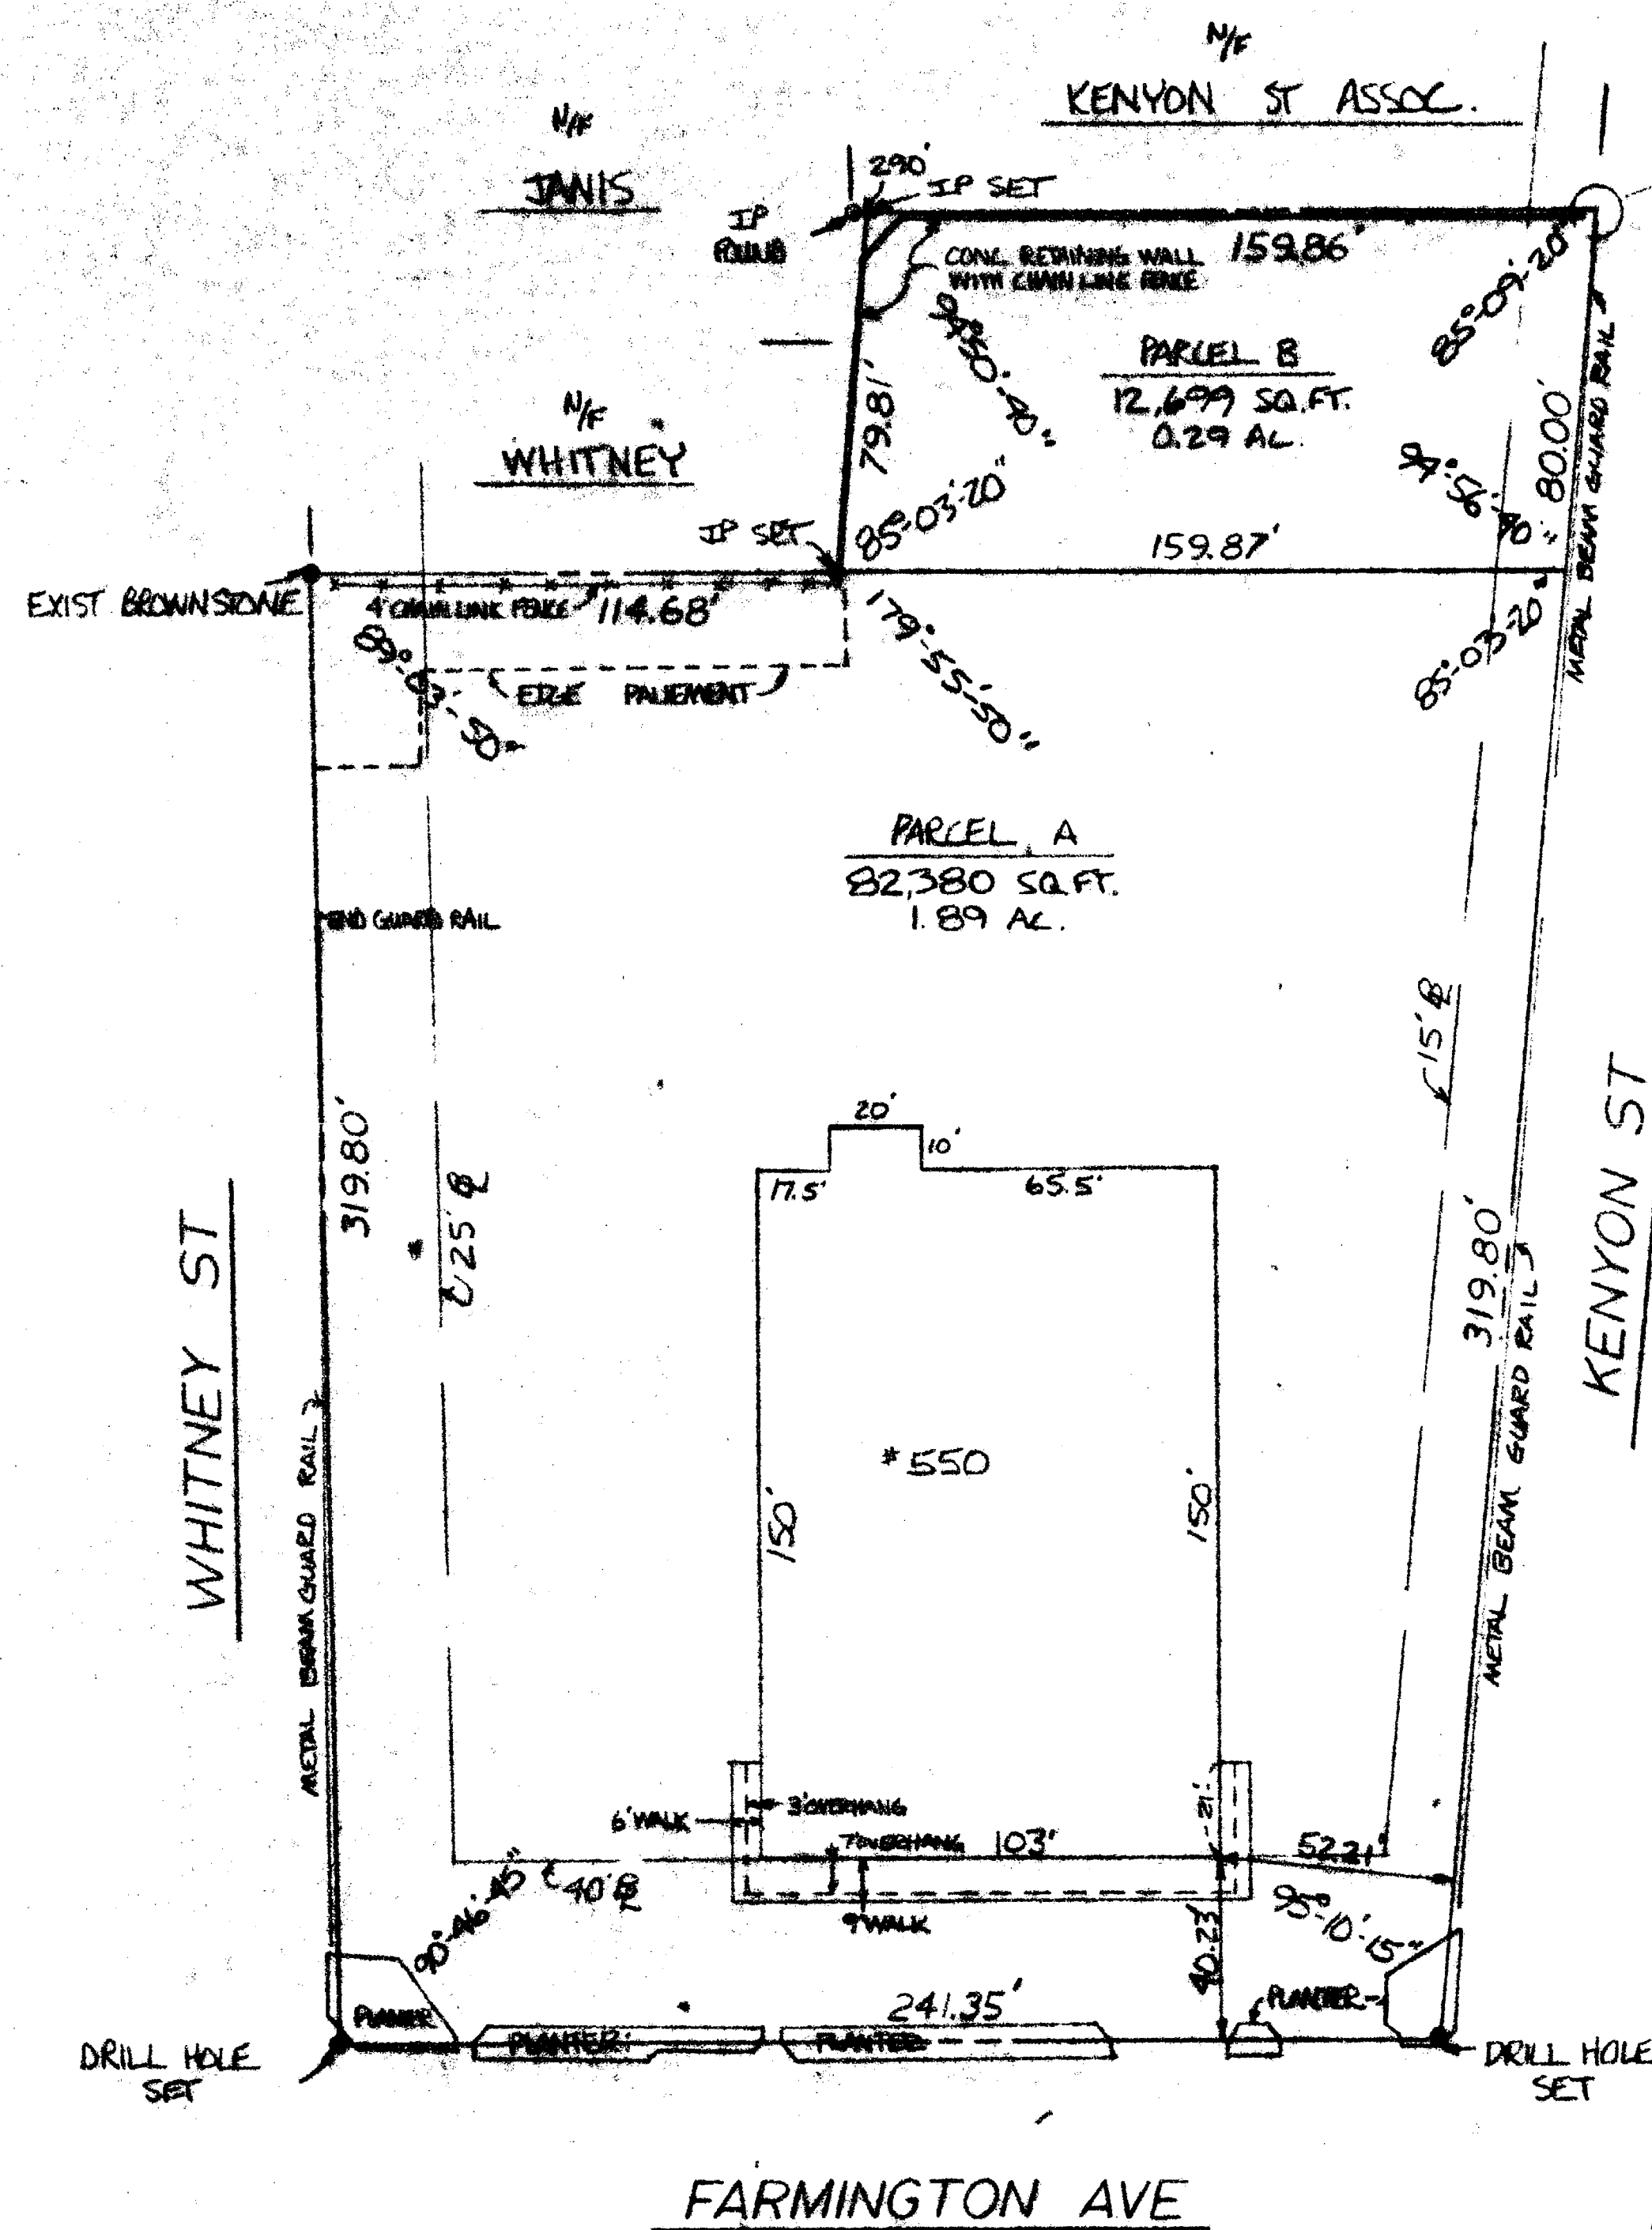

NOTES
 BUILDING LOCATED AS SHOWN

The portions of Farmington Ave., Whitney St. and Kenyon St. shown on this plan are established public streets of the City of Hartford.

10/11/83
 Date
 George E. Palmborg
 City Engineer

I HEREBY CERTIFY THAT THIS MAP AND SURVEY WERE PREPARED IN ACCORDANCE WITH THE STANDARDS OF A CLASS 'A-2' SURVEY AS DEFINED IN THE CODE OF ORDINANCES FOR STANDARDS OF ACCURACY OF SURVEYS AND MAPS ADOPTED DECEMBER 10, 1925 AS AMENDED BY THE CONNECTICUT ASSOCIATION OF LAND SURVEYORS, INC.

Wm. R. Palmborg



LAND TO BE CONVEYED TO
 BRAHM ASSOCIATES
 HARTFORD, CONN

PALMBERG & RUSSO
 LAND SURVEYORS & PROFESSIONAL ENGINEERS
 522 COTTAGE GROVE ROAD
 BLOOMFIELD, CONNECTICUT

NO. KD	SCALE 1"=40'	DATE 9-21-83	SHEET 1 of 1	CHECKED	NO. 83079
--------	--------------	--------------	--------------	---------	-----------

90

1310

