



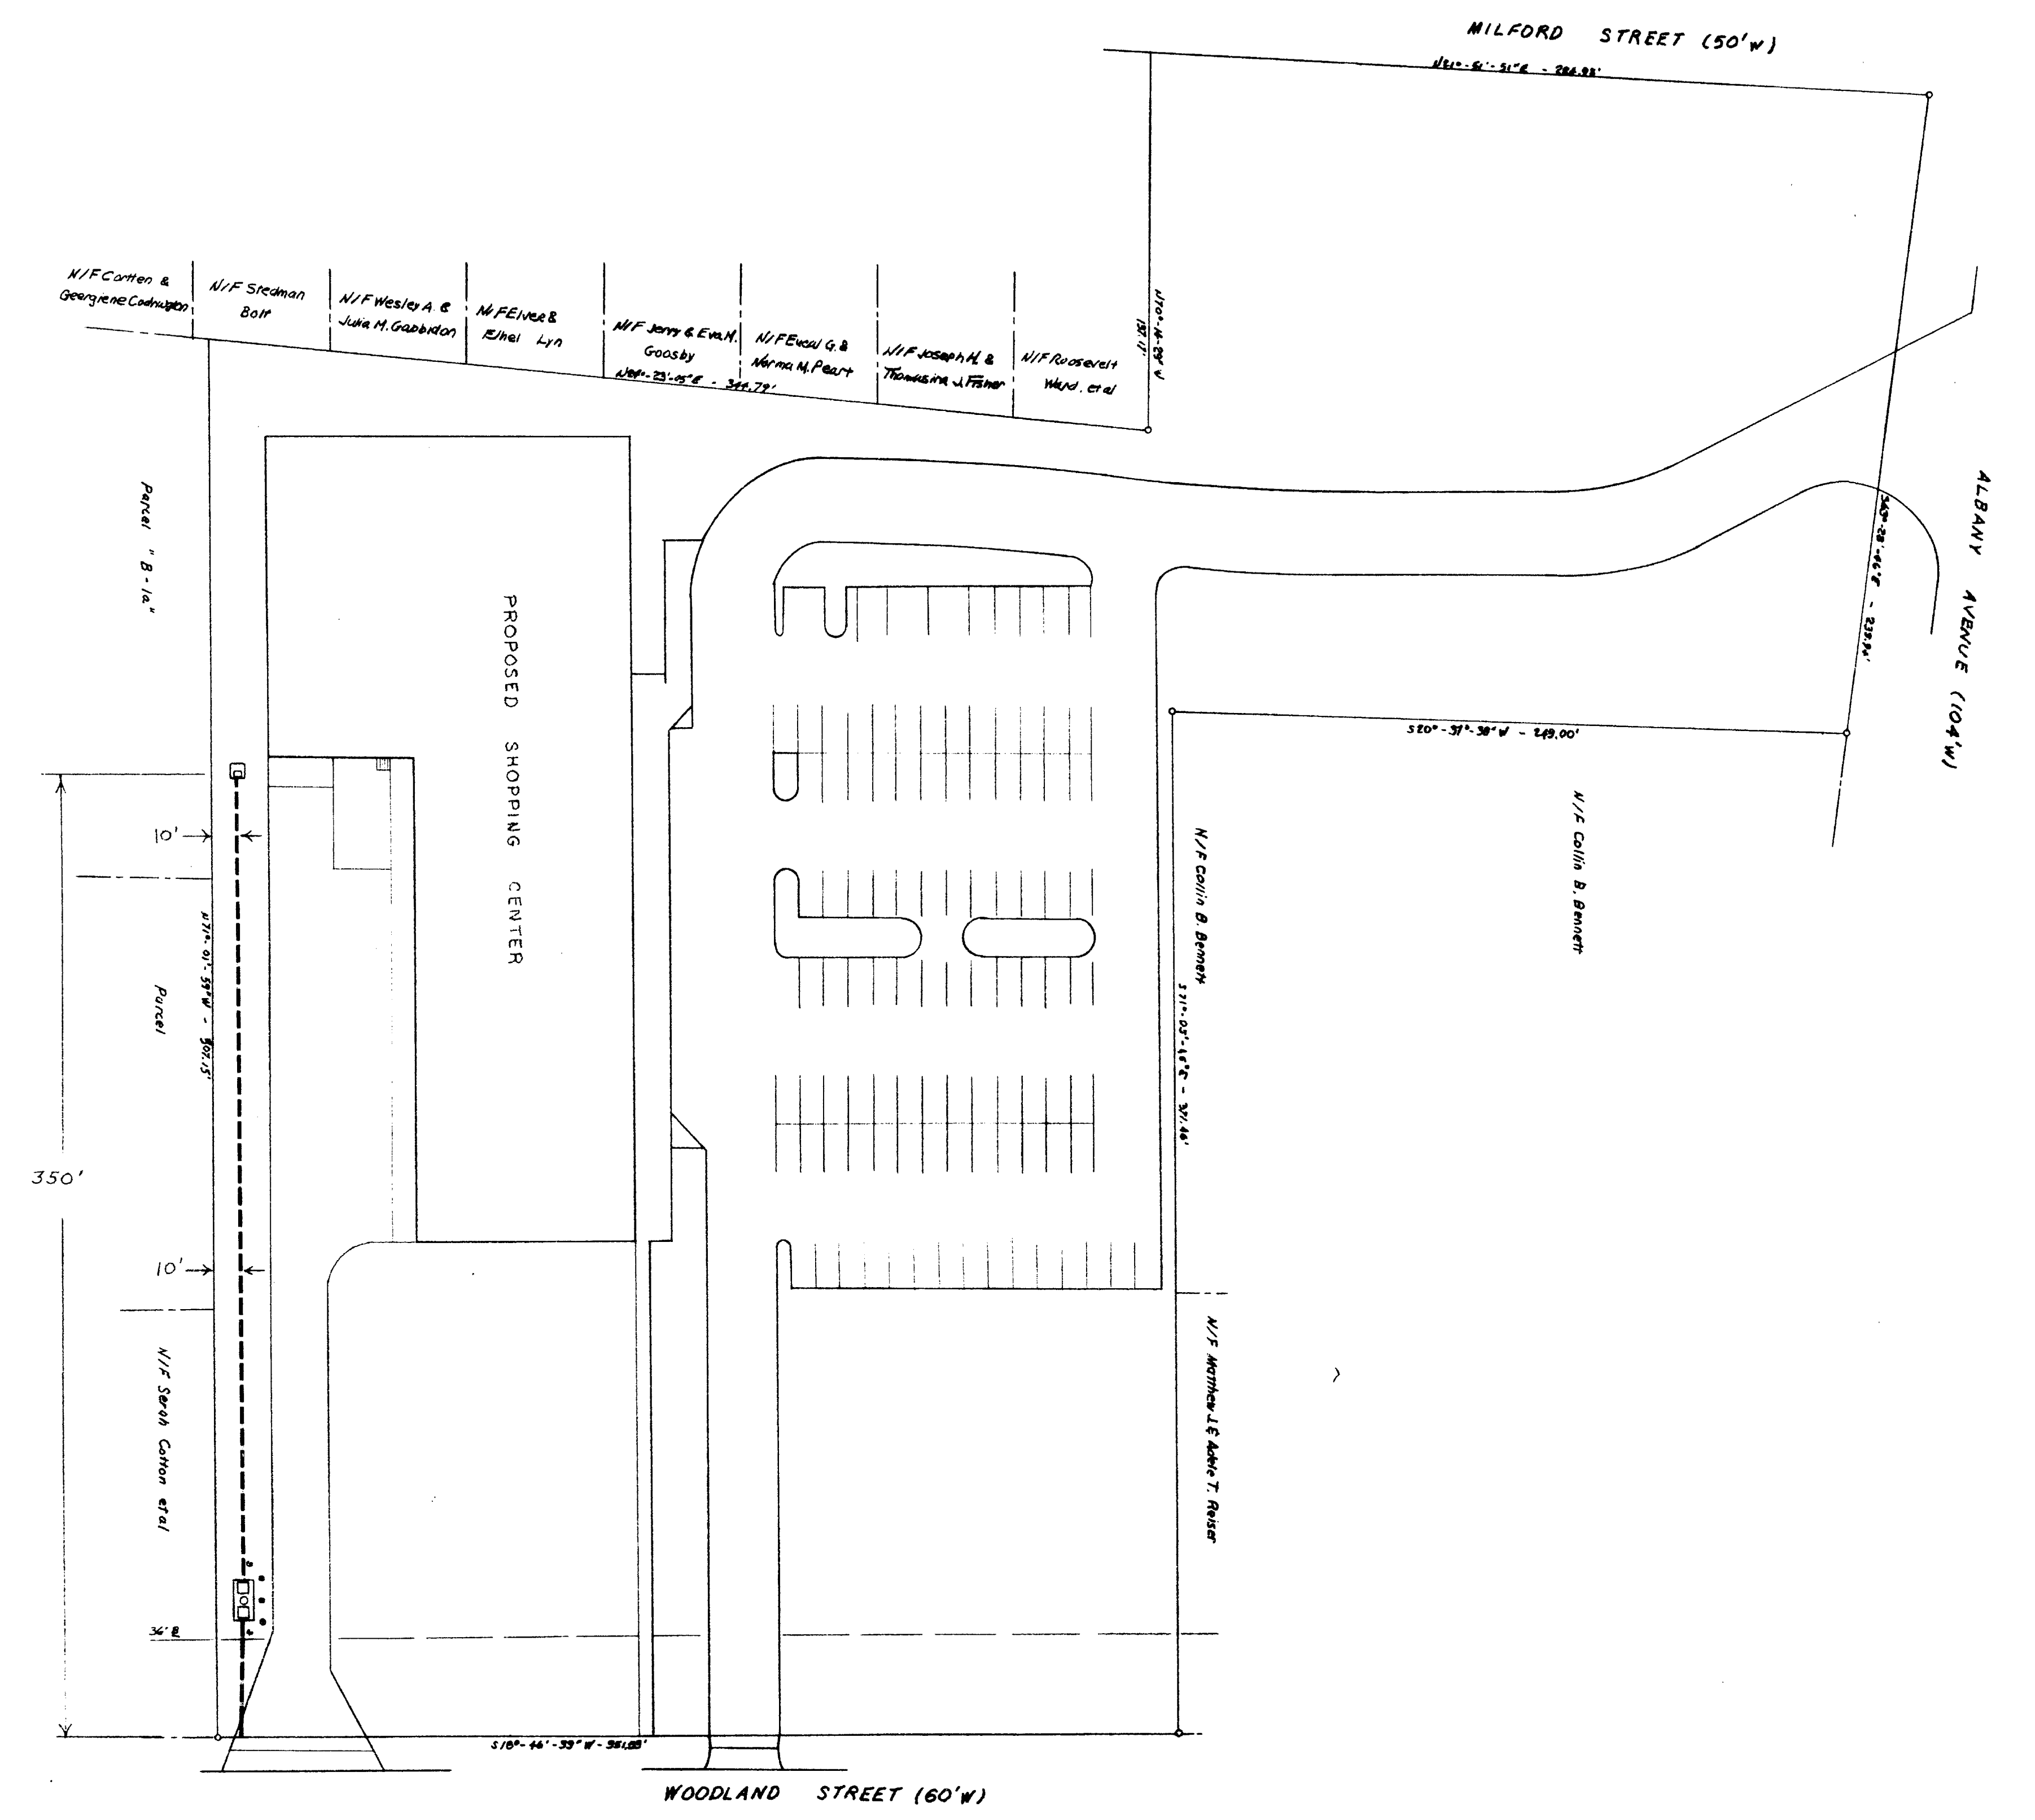

LEGEND

- PEDESTAL CABLE & CONDUIT
- □ □ S & C SWITCH GEAR
- TRANSFORMER
- TRANSFORMER PROTECTION

THIS MAP WAS COMPILED FROM A MAP ENTITLED "COMPOSITE LAYOUT MAP UPPER ALBANY PLAZA HARTFORD, CONN." PREPARED BY HENRY, LEWIS, HOWARD ASSOCIATES, INC. HARTFORD, CONNECTICUT TEL (203) 242-3399 00002

1/23/83

THIS MAP WAS COMPILED FROM A MAP ENTITLED "COMPOSITE LAYOUT MAP UPPER ALBANY PLAZA HARTFORD, CONN." PREPARED BY HENRY, LEWIS, HOWARD ASSOCIATES, INC. HARTFORD, CONNECTICUT TEL (203) 242-3399 00002

The portions of Woodland St., Milford St. and Albany Ave. shown on this plan are established public streets of the City of Hartford.  
Date 1/23/83  
City Engineer

Drawn By: SJK  
Checked By: SJK  
Approved By: SJK

| NO. | DATE    | DESCRIPTION                       | BY  |
|-----|---------|-----------------------------------|-----|
| 1   | 9/12/83 | ROAD ELECTRIC FACILITY DIMENSIONS | SJK |
|     |         |                                   |     |
|     |         |                                   |     |
THE CONNECTICUT LIGHT & POWER COMPANY  
FACILITIES ON THE PROPERTY OF THE CITY OF HARTFORD, UPPER ALBANY PLAZA HARTFORD, CONN.  
NO. E-C-705K3-1234  
Scale 1"=40' Date: 6-3-1983

