


1320

1320-3

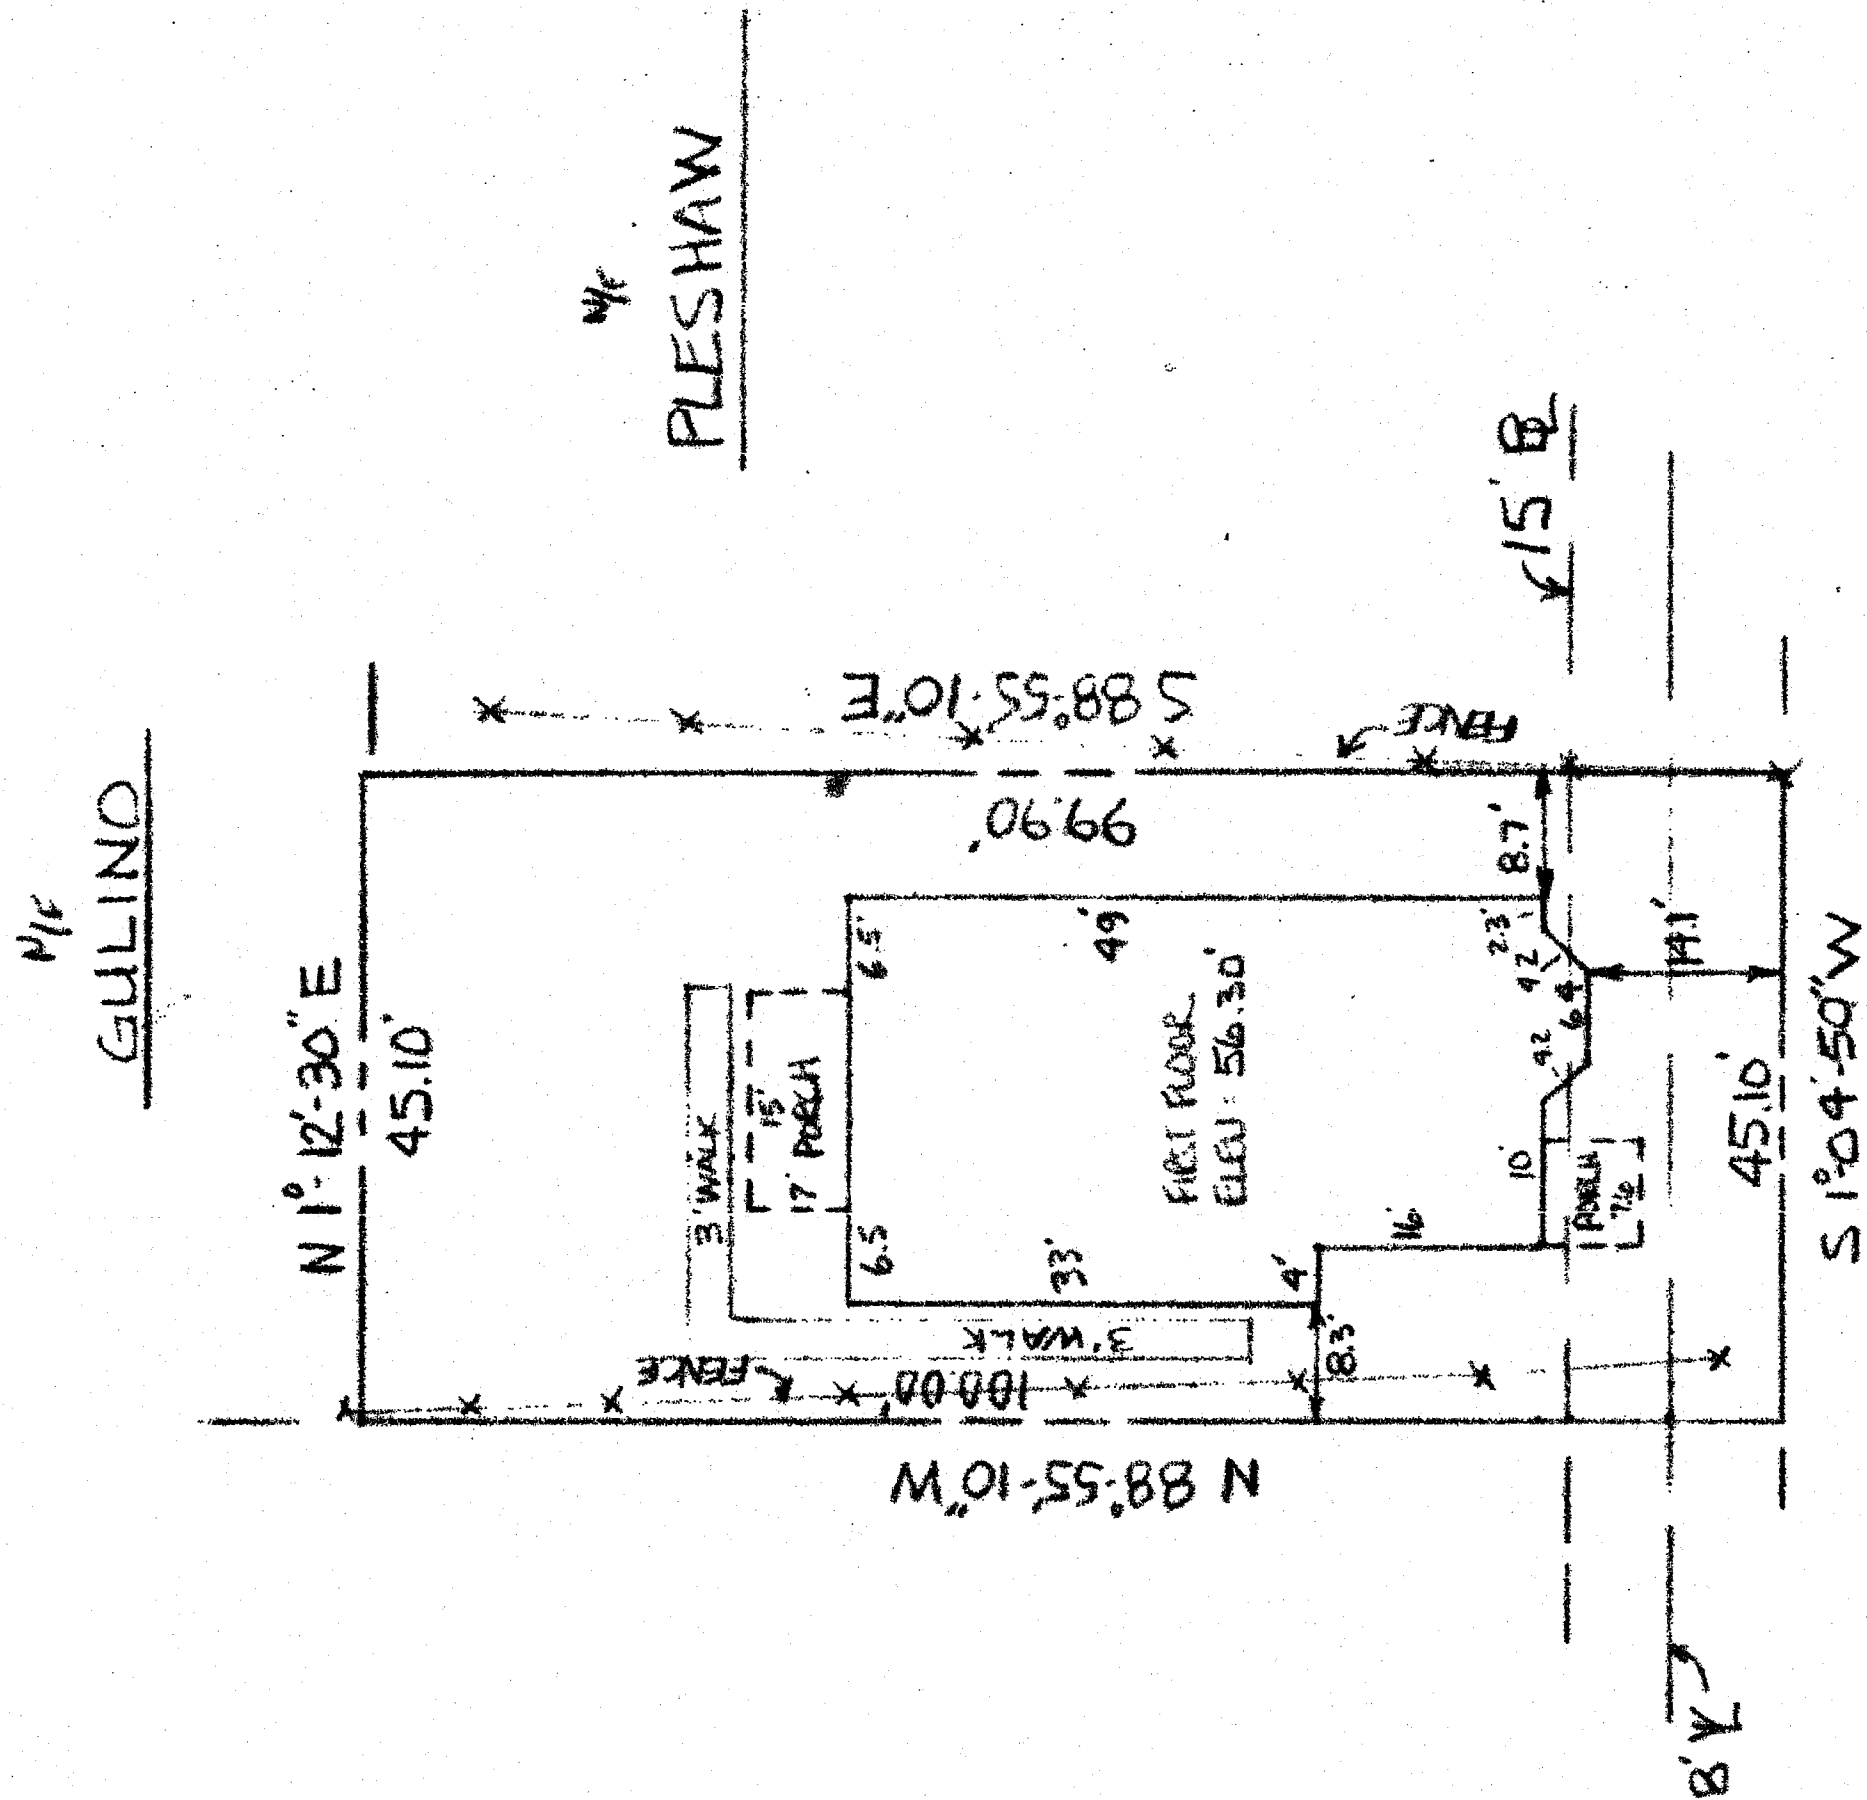

NOTES

ELEVATION BASED ON MDC DATUM


The portion of Babcock St. shown on this plan is an established public street of the City of Hartford.

11/17/83

Date

George E. Palmer
City Engineer

I HEREBY CERTIFY THAT THIS MAP AND SURVEY WERE PREPARED IN ACCORDANCE WITH THE STANDARDS OF A CLASS A-2 SURVEY AS DEFINED IN THE CODE OF PRACTICE FOR STANDARDS OF ACCURACY OF SURVEYS AND MAPS, ADOPTED DECEMBER 10, 1975 AS AMENDED BY THE CONNECTICUT ASSOCIATION OF LAND SURVEYORS, INC.

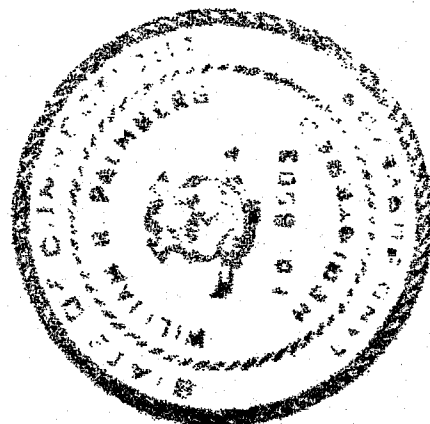

09172
RECEIVED BY
William A. DeWitt
NOV 9 12 01 PM '83
TOWN & CITY CLERK
HARTFORD
VOL. _____ PAGE _____

MULTIFAMILY DWELLING

19 BABCOCK ST

HARTFORD CONNECTICUT

PALMBERG & RUSSO

LAND SURVEYORS & PROFESSIONAL ENGINEERS

522 COTTAGE GROVE ROAD

BLOOMFIELD, CONNECTICUT

BY	SCALE	DATE	SHEET	CHECKED	NO.
KD	1"=20'	6-30-83	1 of 1	WP	83055

1320

100

CITY OF HARTFORD, CONNECTICUT