
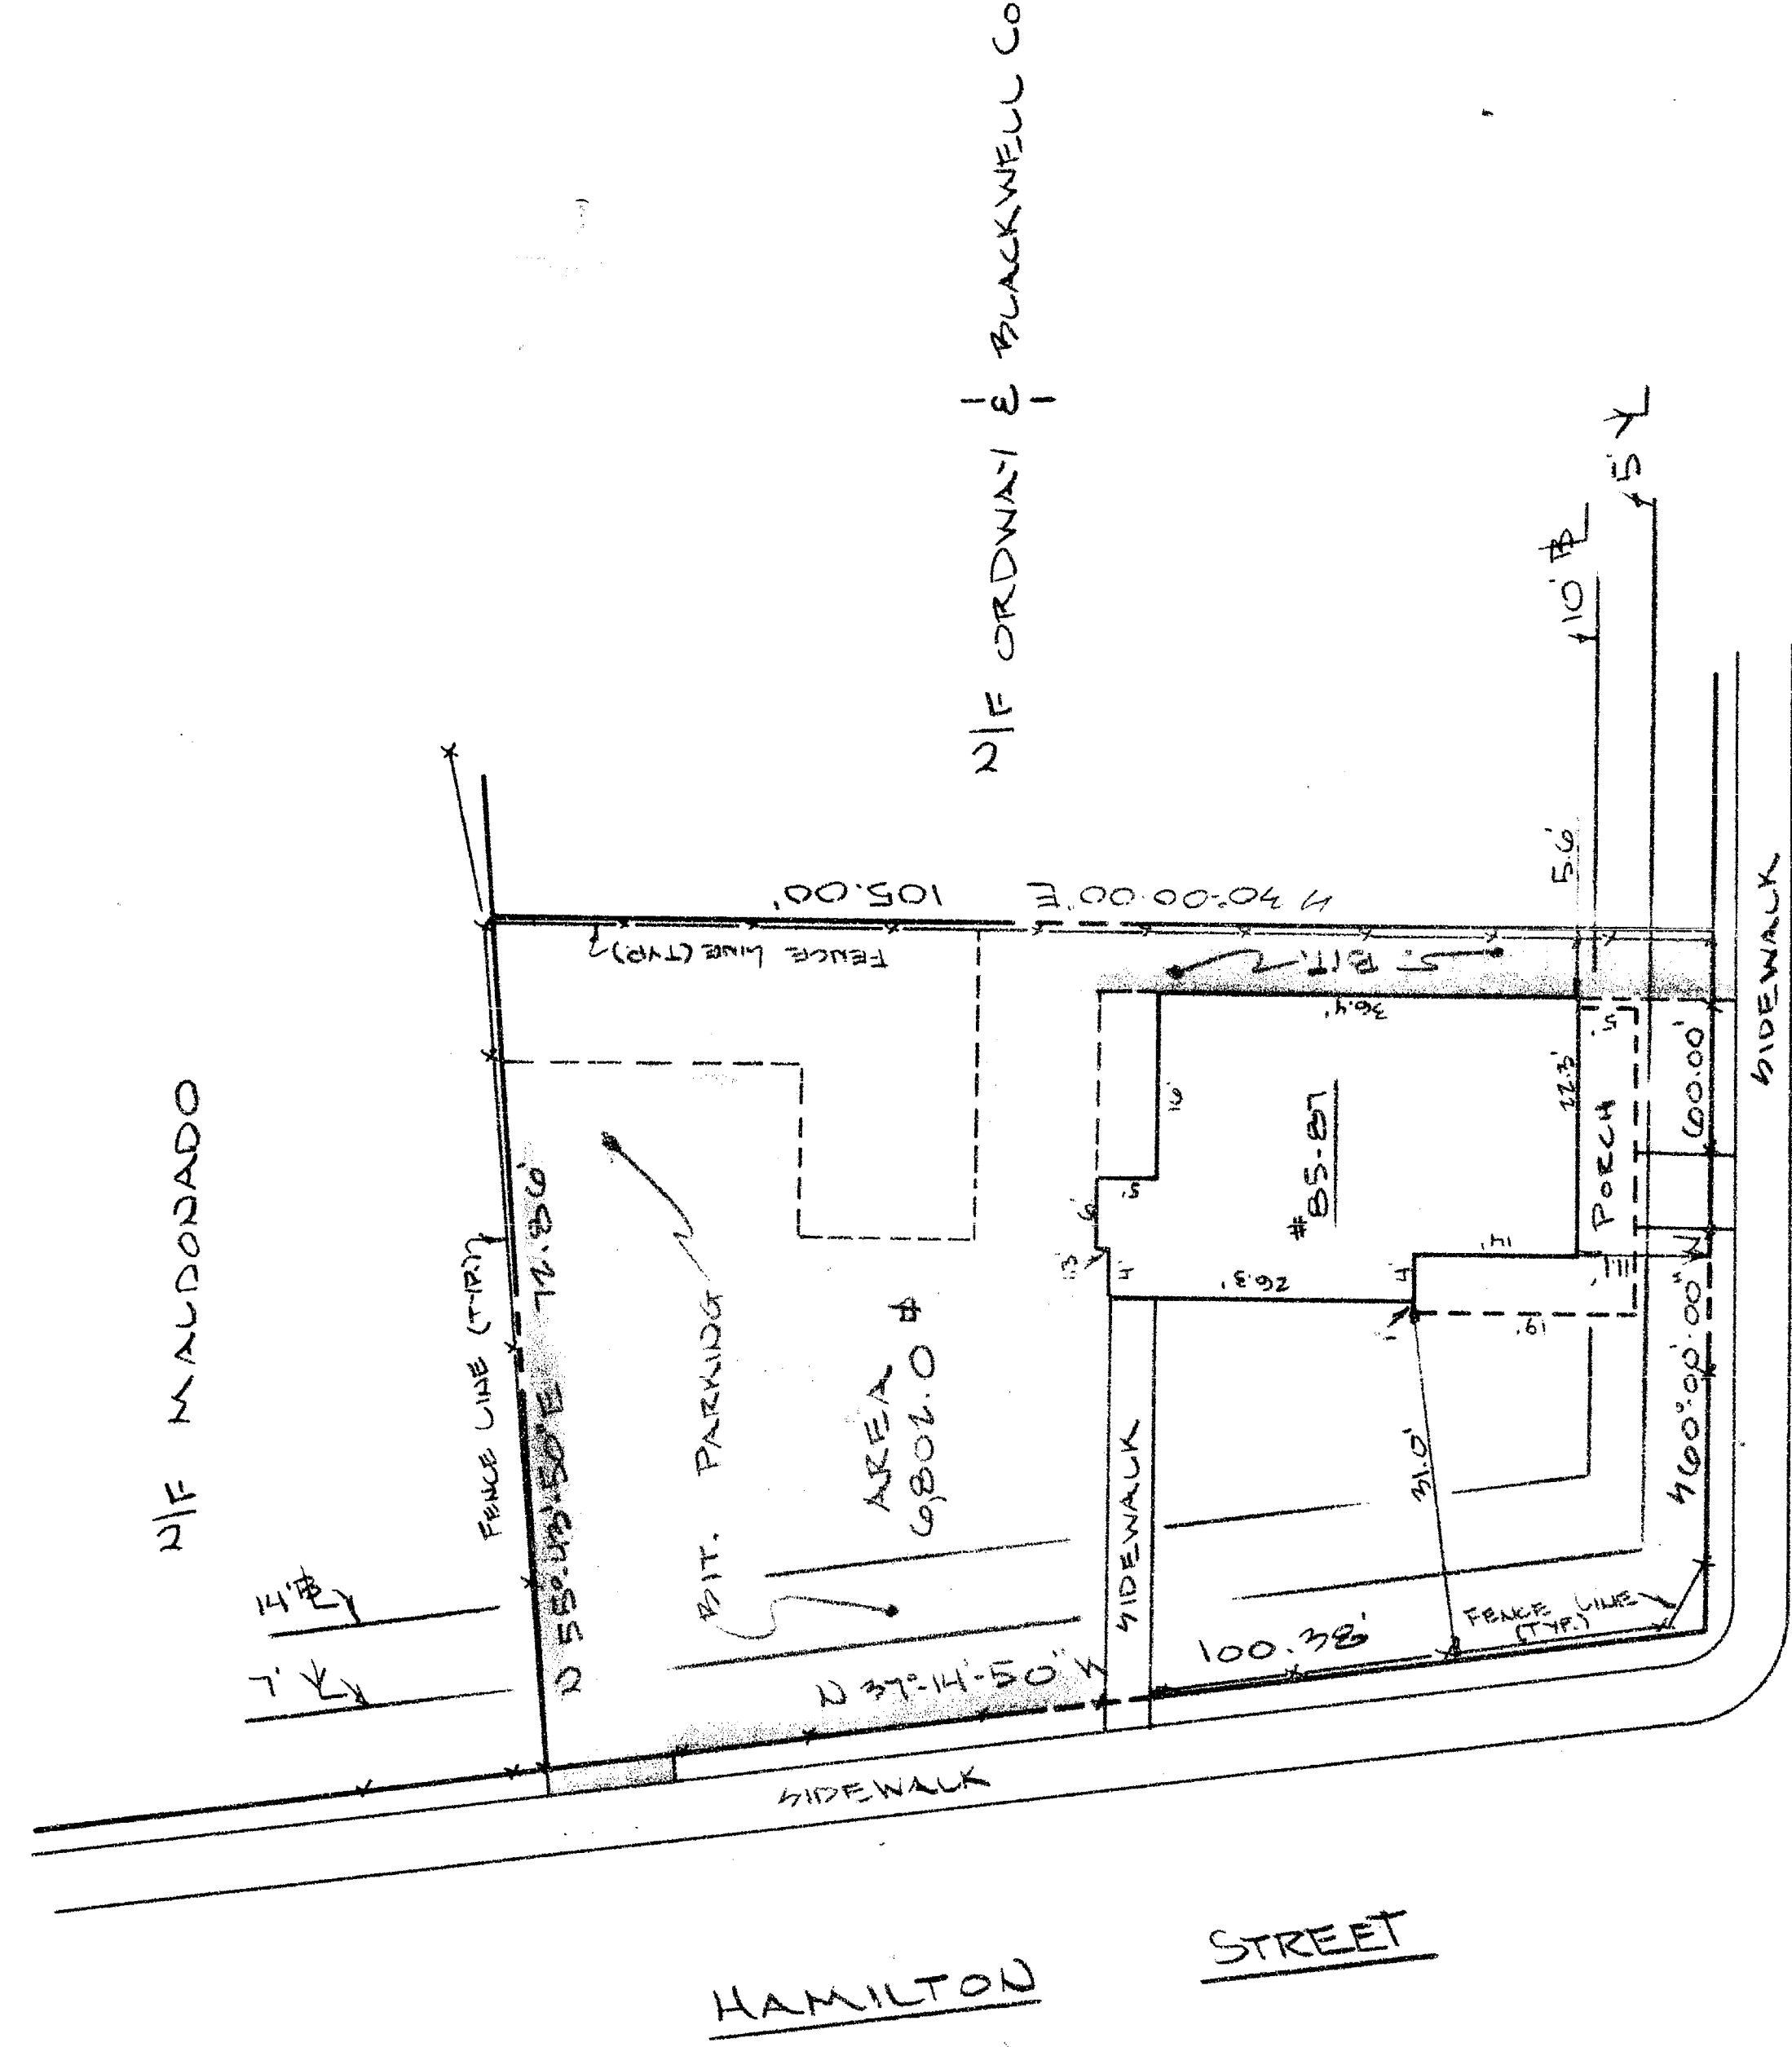


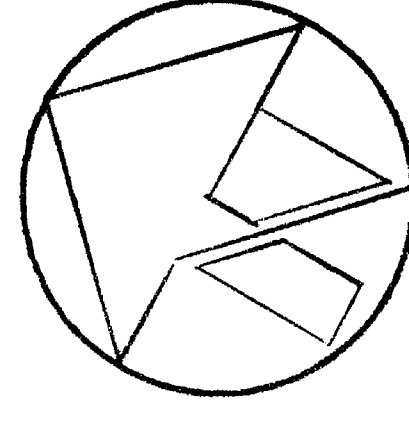


REF. MAP: "SUBDIVISION PROPERTY OF
WILLIAM FRANKS" 1"=100' FEB. 1951
NOTE: PROPERTY NOT LOCATED IN
A FLOOD HAZARD AREA.
BEARINGS ASSUMED

FRANCIS AVENUE

BUILDING LOCATED AS SHOWN
AND CHAS. T. HARRIS, CO. THAT THIS
MAP IS SUBSTANTIALLY CORRECT IN ACCORDANCE
WITH CURRENT ZONING REGULATIONS ARE
NOT VIOLATED.

WIDENY PREPARED FOR
KENNETH S. NELSON JR. & BEATRICE R. NELSON
ALBINO S. AND MARIA A. LUIS
HARTFORD, CONN.

William R. Nelson

 

The portions of Francis Ave. and Hamilton St.
shown on this plan are established public
streets of the City of Hartford.

11/21/93
Date
City Engineer

DATE: 11-17-93 SCALE: 1"=20'

1321

1321

