


132

1 3 2 1 - 1

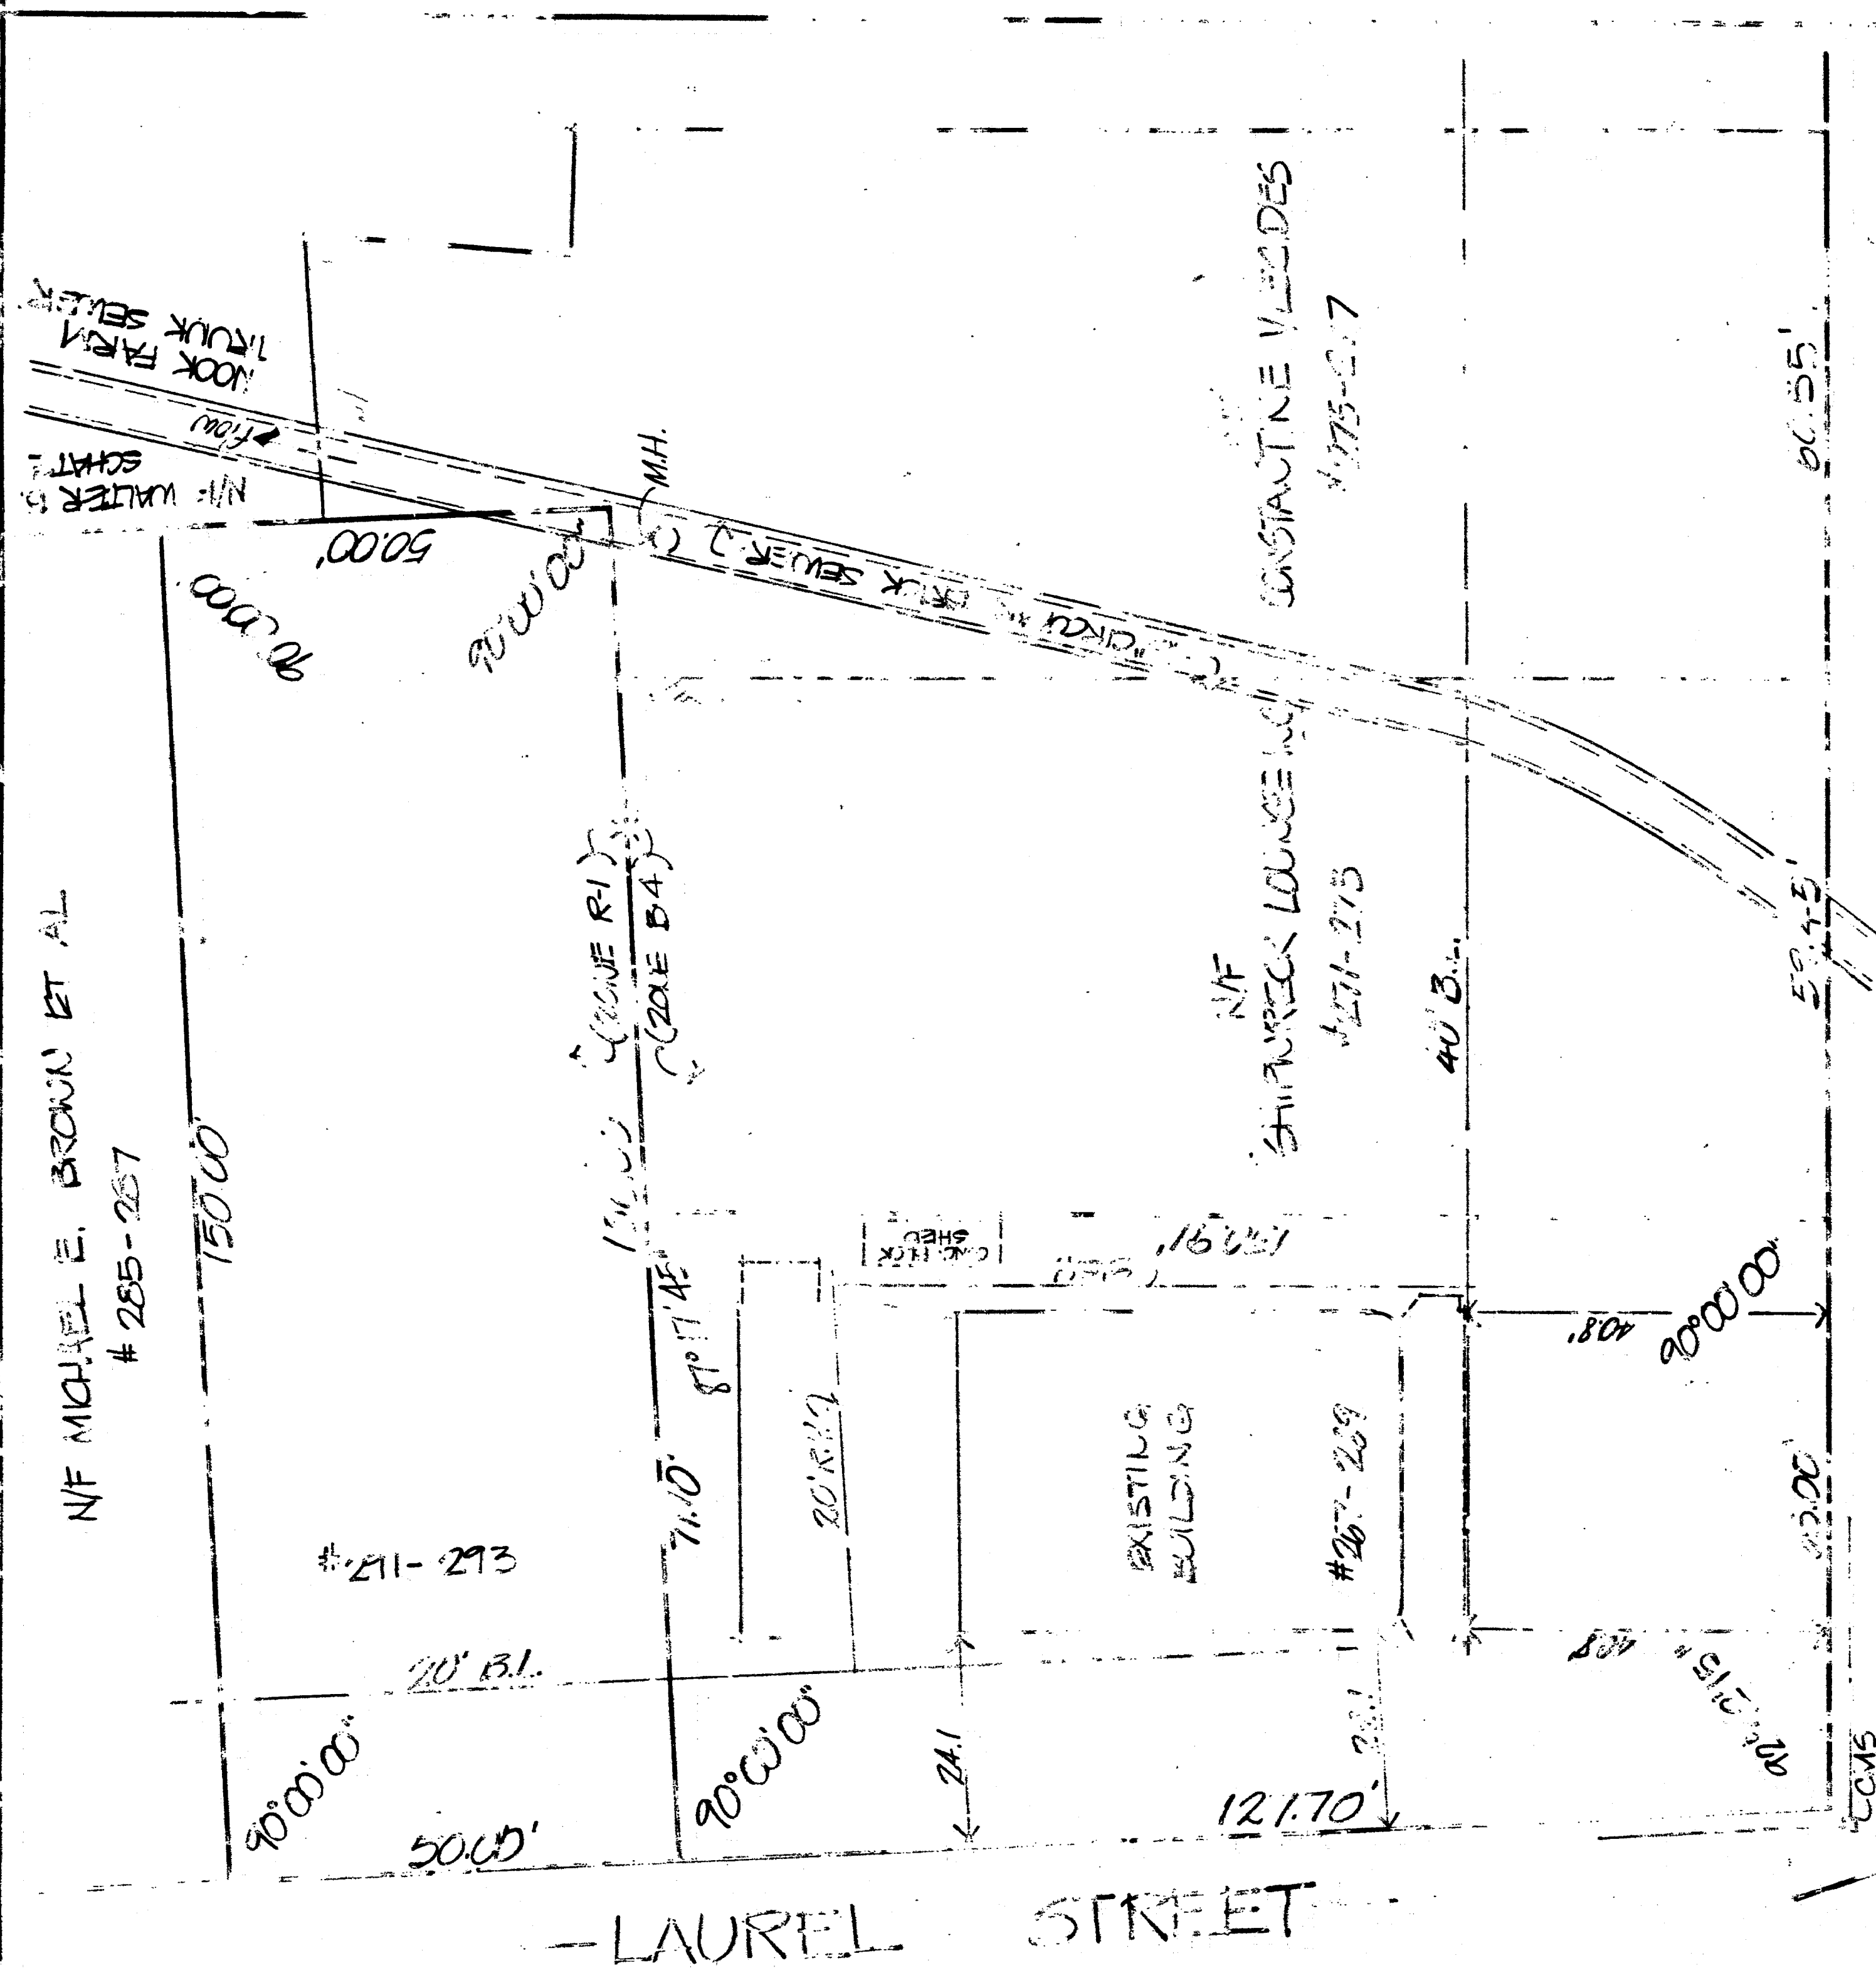

RECEIVED BY

Martin H. Sengstacke

Nov 21 3 50 PM '83

TOWN & CITY CLERK
HARTFORD

VOL. _____ PAGE _____

The portions of Farmington Ave. and Laurel St. shown on this plan are established public streets of the City of Hartford.

George C. Dappner
City Engineer

11/22/83
Date

NOTE: BUILDING DOES CONFORM TO REAR YARD

REAR WARD

— ERVINGTON AVENUE —

I HEREBY CERTIFY TO CONVEY WITHOUT DULOCK & TRUST CO. FA.
CHICAGO TITLE INSURANCE COMPANY, UNITED BANK
& TRUST COMPANY, LAURENCE TITLE INSURANCE
CORPORATION, COMET ASSOCIATES LIMITED PARTNER-
SHIP, HELEN VECLODES AND CONSTANCE VECLODES
THAT THIS MAP WAS PREPARED IN ACCORDANCE
WITH THE STANDARDS OF A CLASS A-2 SURVEY AS DEMAND
IN THE CODE OF PRACTICE FOR STANDARDS OF ACCURACY
OF SURVEYS AND MAPS, ADOPTED DEC. 10, 1975 AS AMENDED
BY THE CONNECTICUT ASSOCIATION OF LAND SURVEYORS INC.,
THAT THE BUILDING IS LOCATED AS SHOWN AND THERE ARE
NO VIOLATIONS OF ZONING REGULATIONS WITH REFERENCE
TO THE LOCATION OF SAID BUILDING.

COMET ASSOCIATES
LIMITED PARTNERSHIP

#291-293 LAUREL STREET
#261-259 FARMINGTON AVE.

HARTFORD, CONN.

AUGUST 1, 1933 SCALE 1"=20'
CERTIFICATE REISSUED NOV. 5, 1983

JOHN LAWRENCE & ASSOCIATES

John Lawrence, L.S.
JOHN J. LAWRENCE JR. TELLS

JOHN J. LAURENCE JR. 7/1/15

701

32