


10064
RECEIVED BY
DEC 1 12 14 PM '83
VCL PAGE

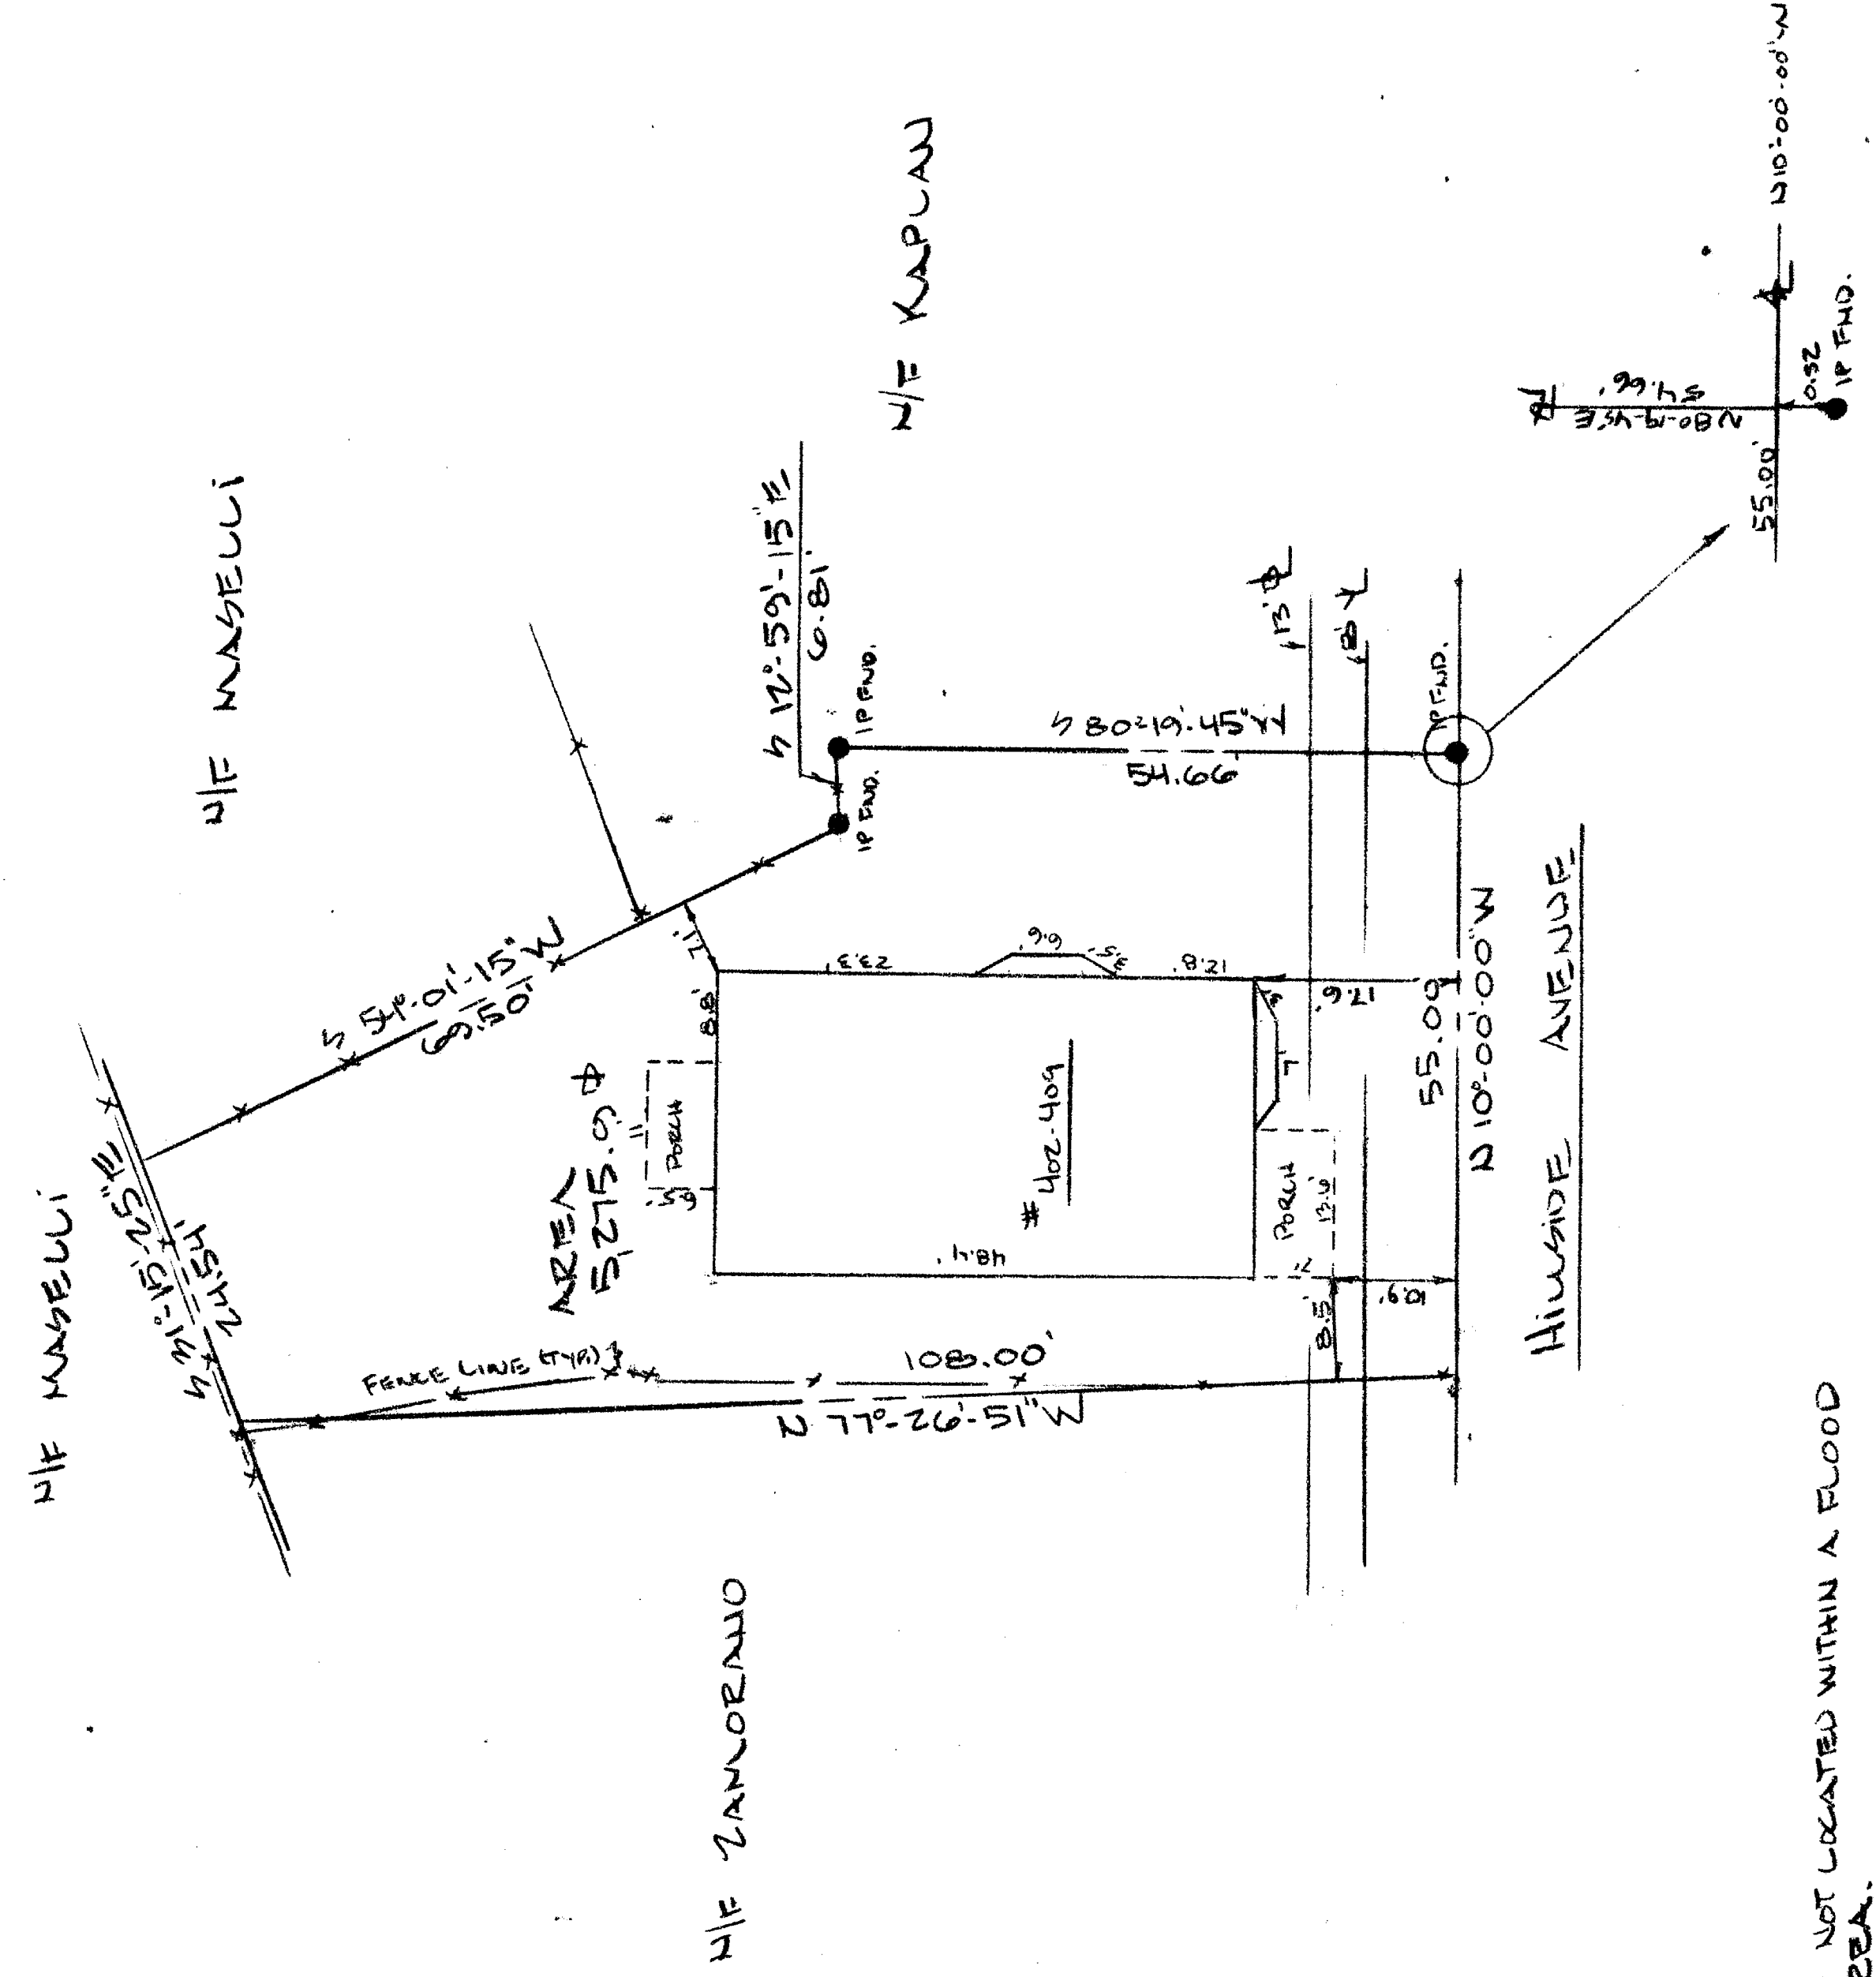


NOTES:
1. PROPERTY NOT LOCATED WITHIN A FLOOD
HAZARD AREA.
2. BEARINGS ASSUMED.

PROPERTY OF
RICCARDO P. & GIOVANNA LOMBARDO
TO BE SOLD TO
JESSE F. & SARA A. RAMBOY
HARTFORD, CONN.

BUILDING LOCATED AS SHOWN

I HEREBY CERTIFY TO NORTHEAST SURVEYS, P.A.
AND COMMUNITY TITLE INSURANCE CO. THAT THIS MAP
IS SUBSTANTIALLY CORRECT IN ACCORDANCE WITH
CLASS ACT, AND ZONING REGULATIONS ARE NOT VIOLATED.

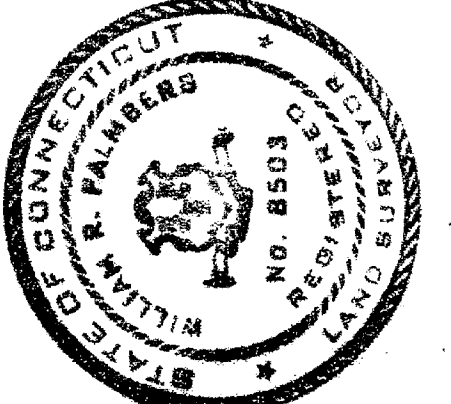

The portion of Hillside Ave. shown on this plan
is an established public street of the City of
Hartford.

DATE: 12/6/83
City Engineer

DATE: 11/21/83 SCALE: 1"=20'

03133

107

1321

