


132

1321-3

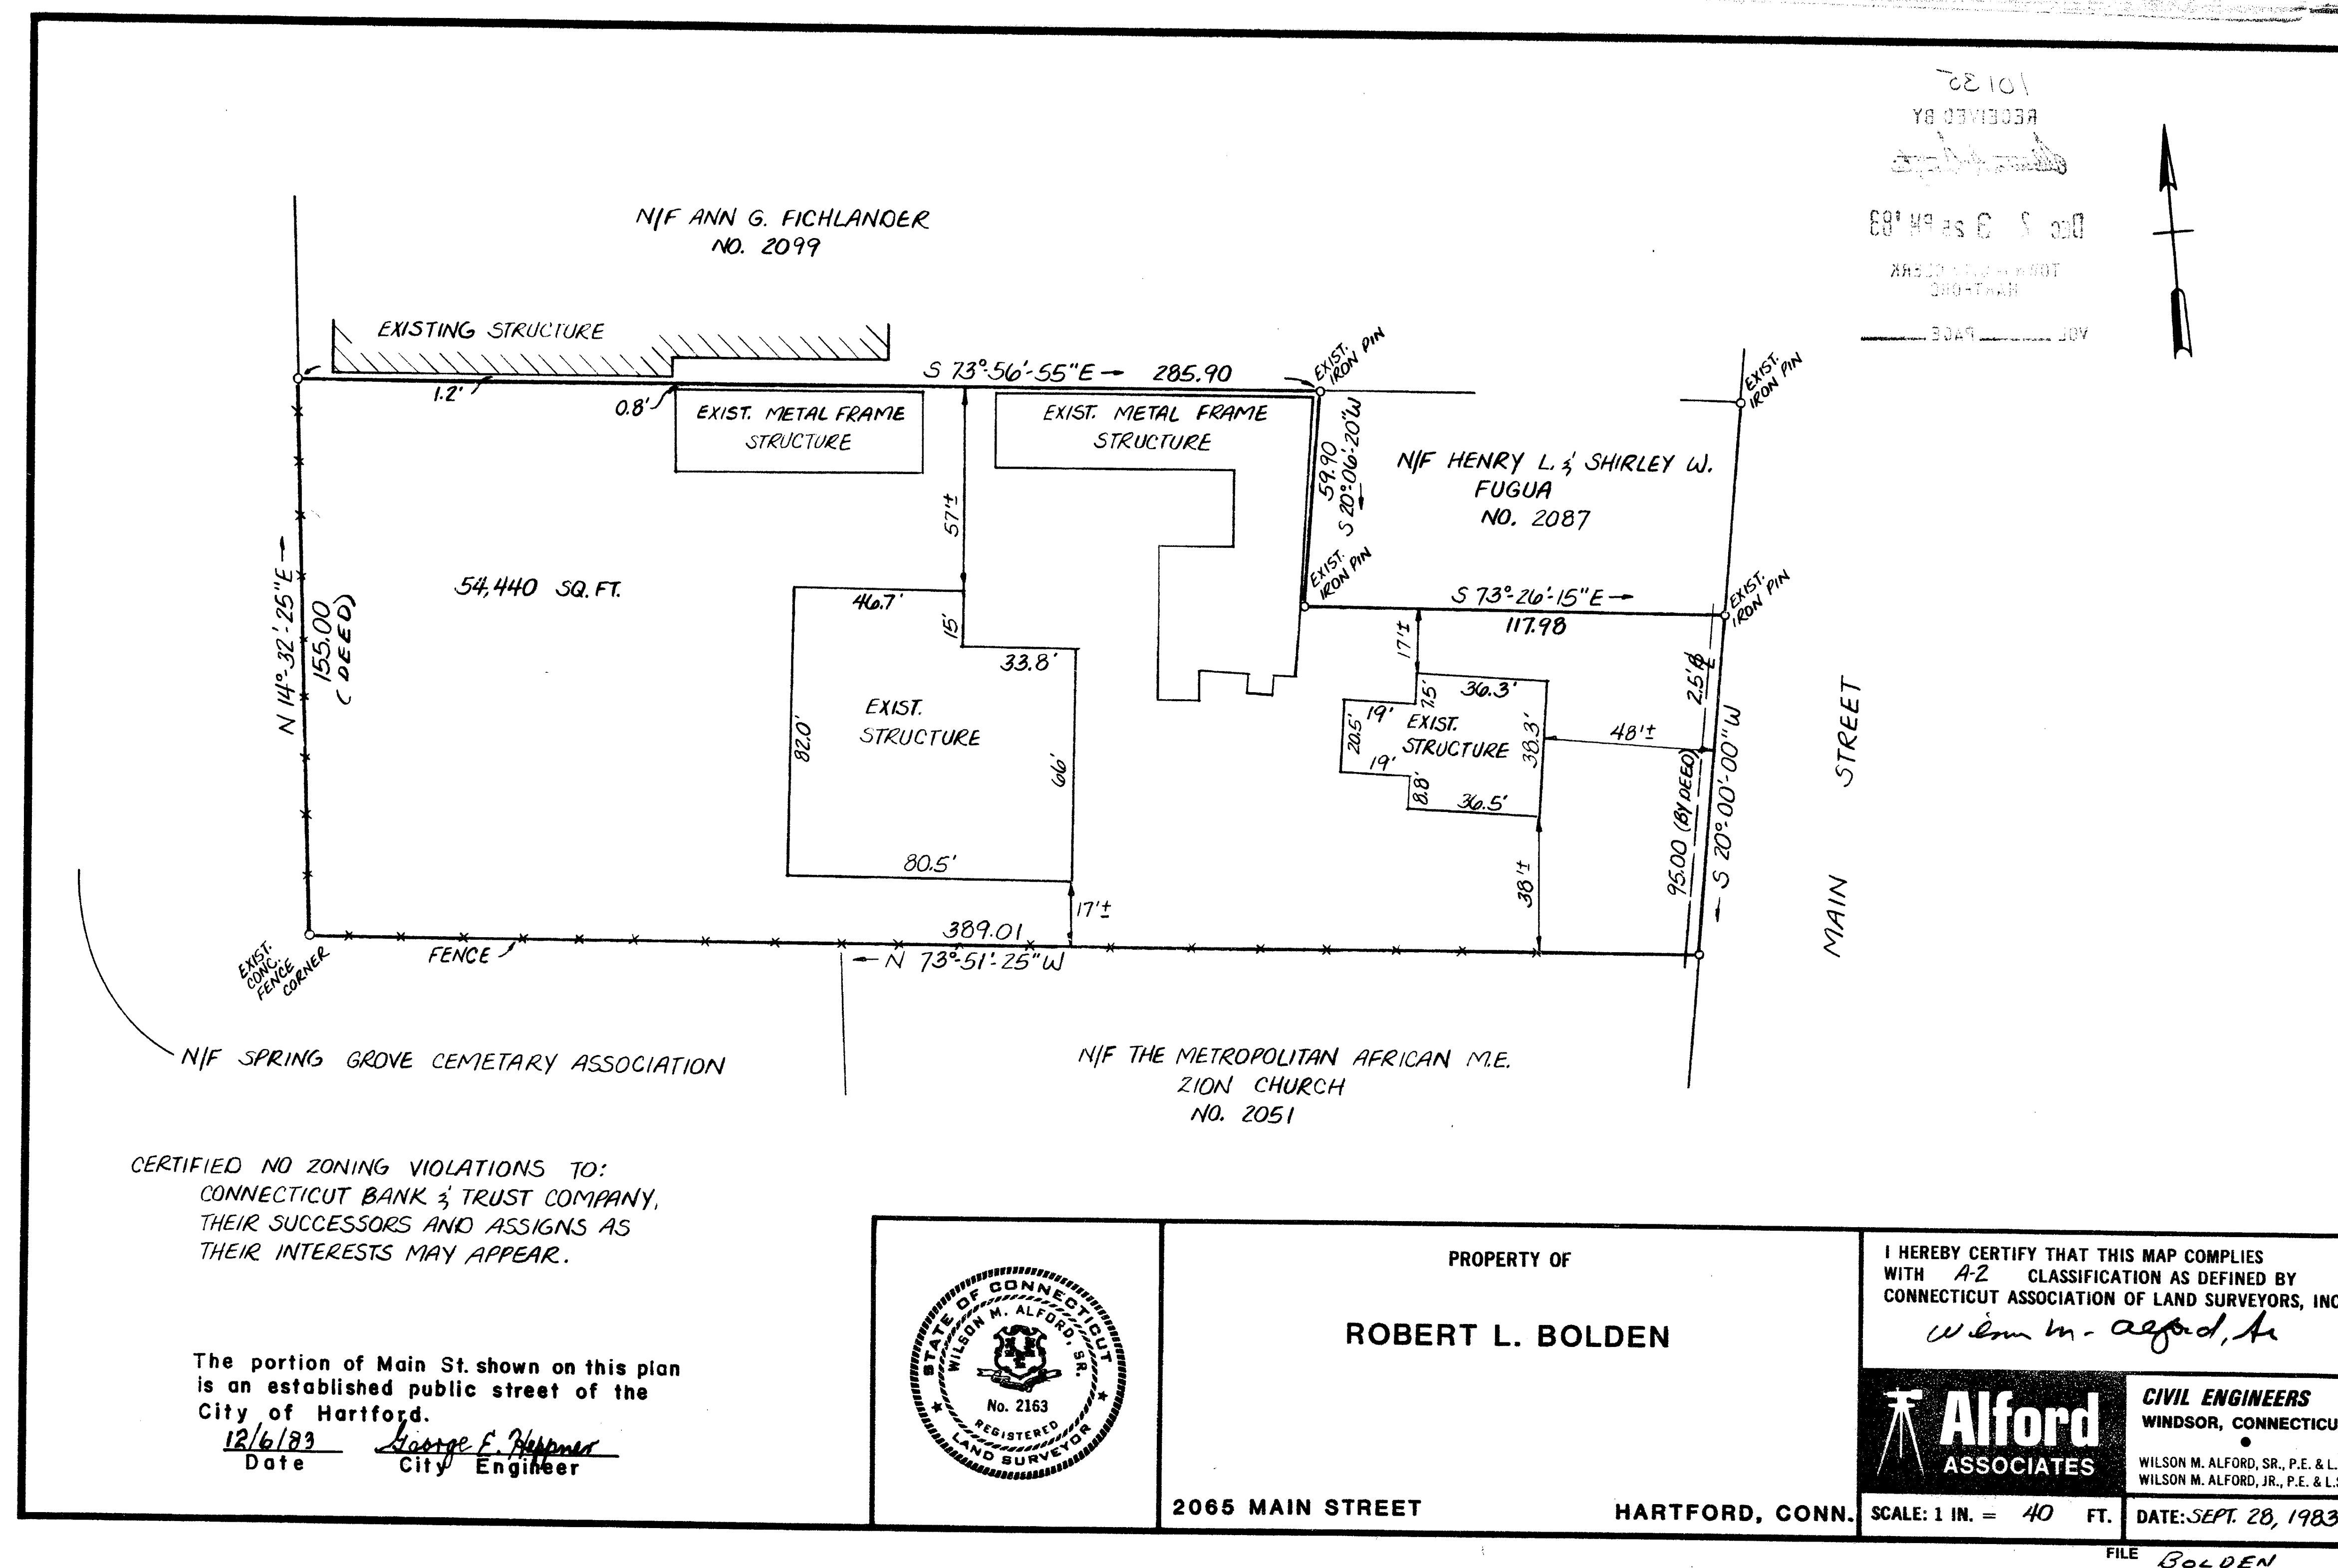

N. SCALE: 1 IN. = 40 FT

DATE: SEPT. 28, 1983

FILE *BOLDEN*