


EAB FILE CORP. IRVINE CA EPH 34
1323

1323-3

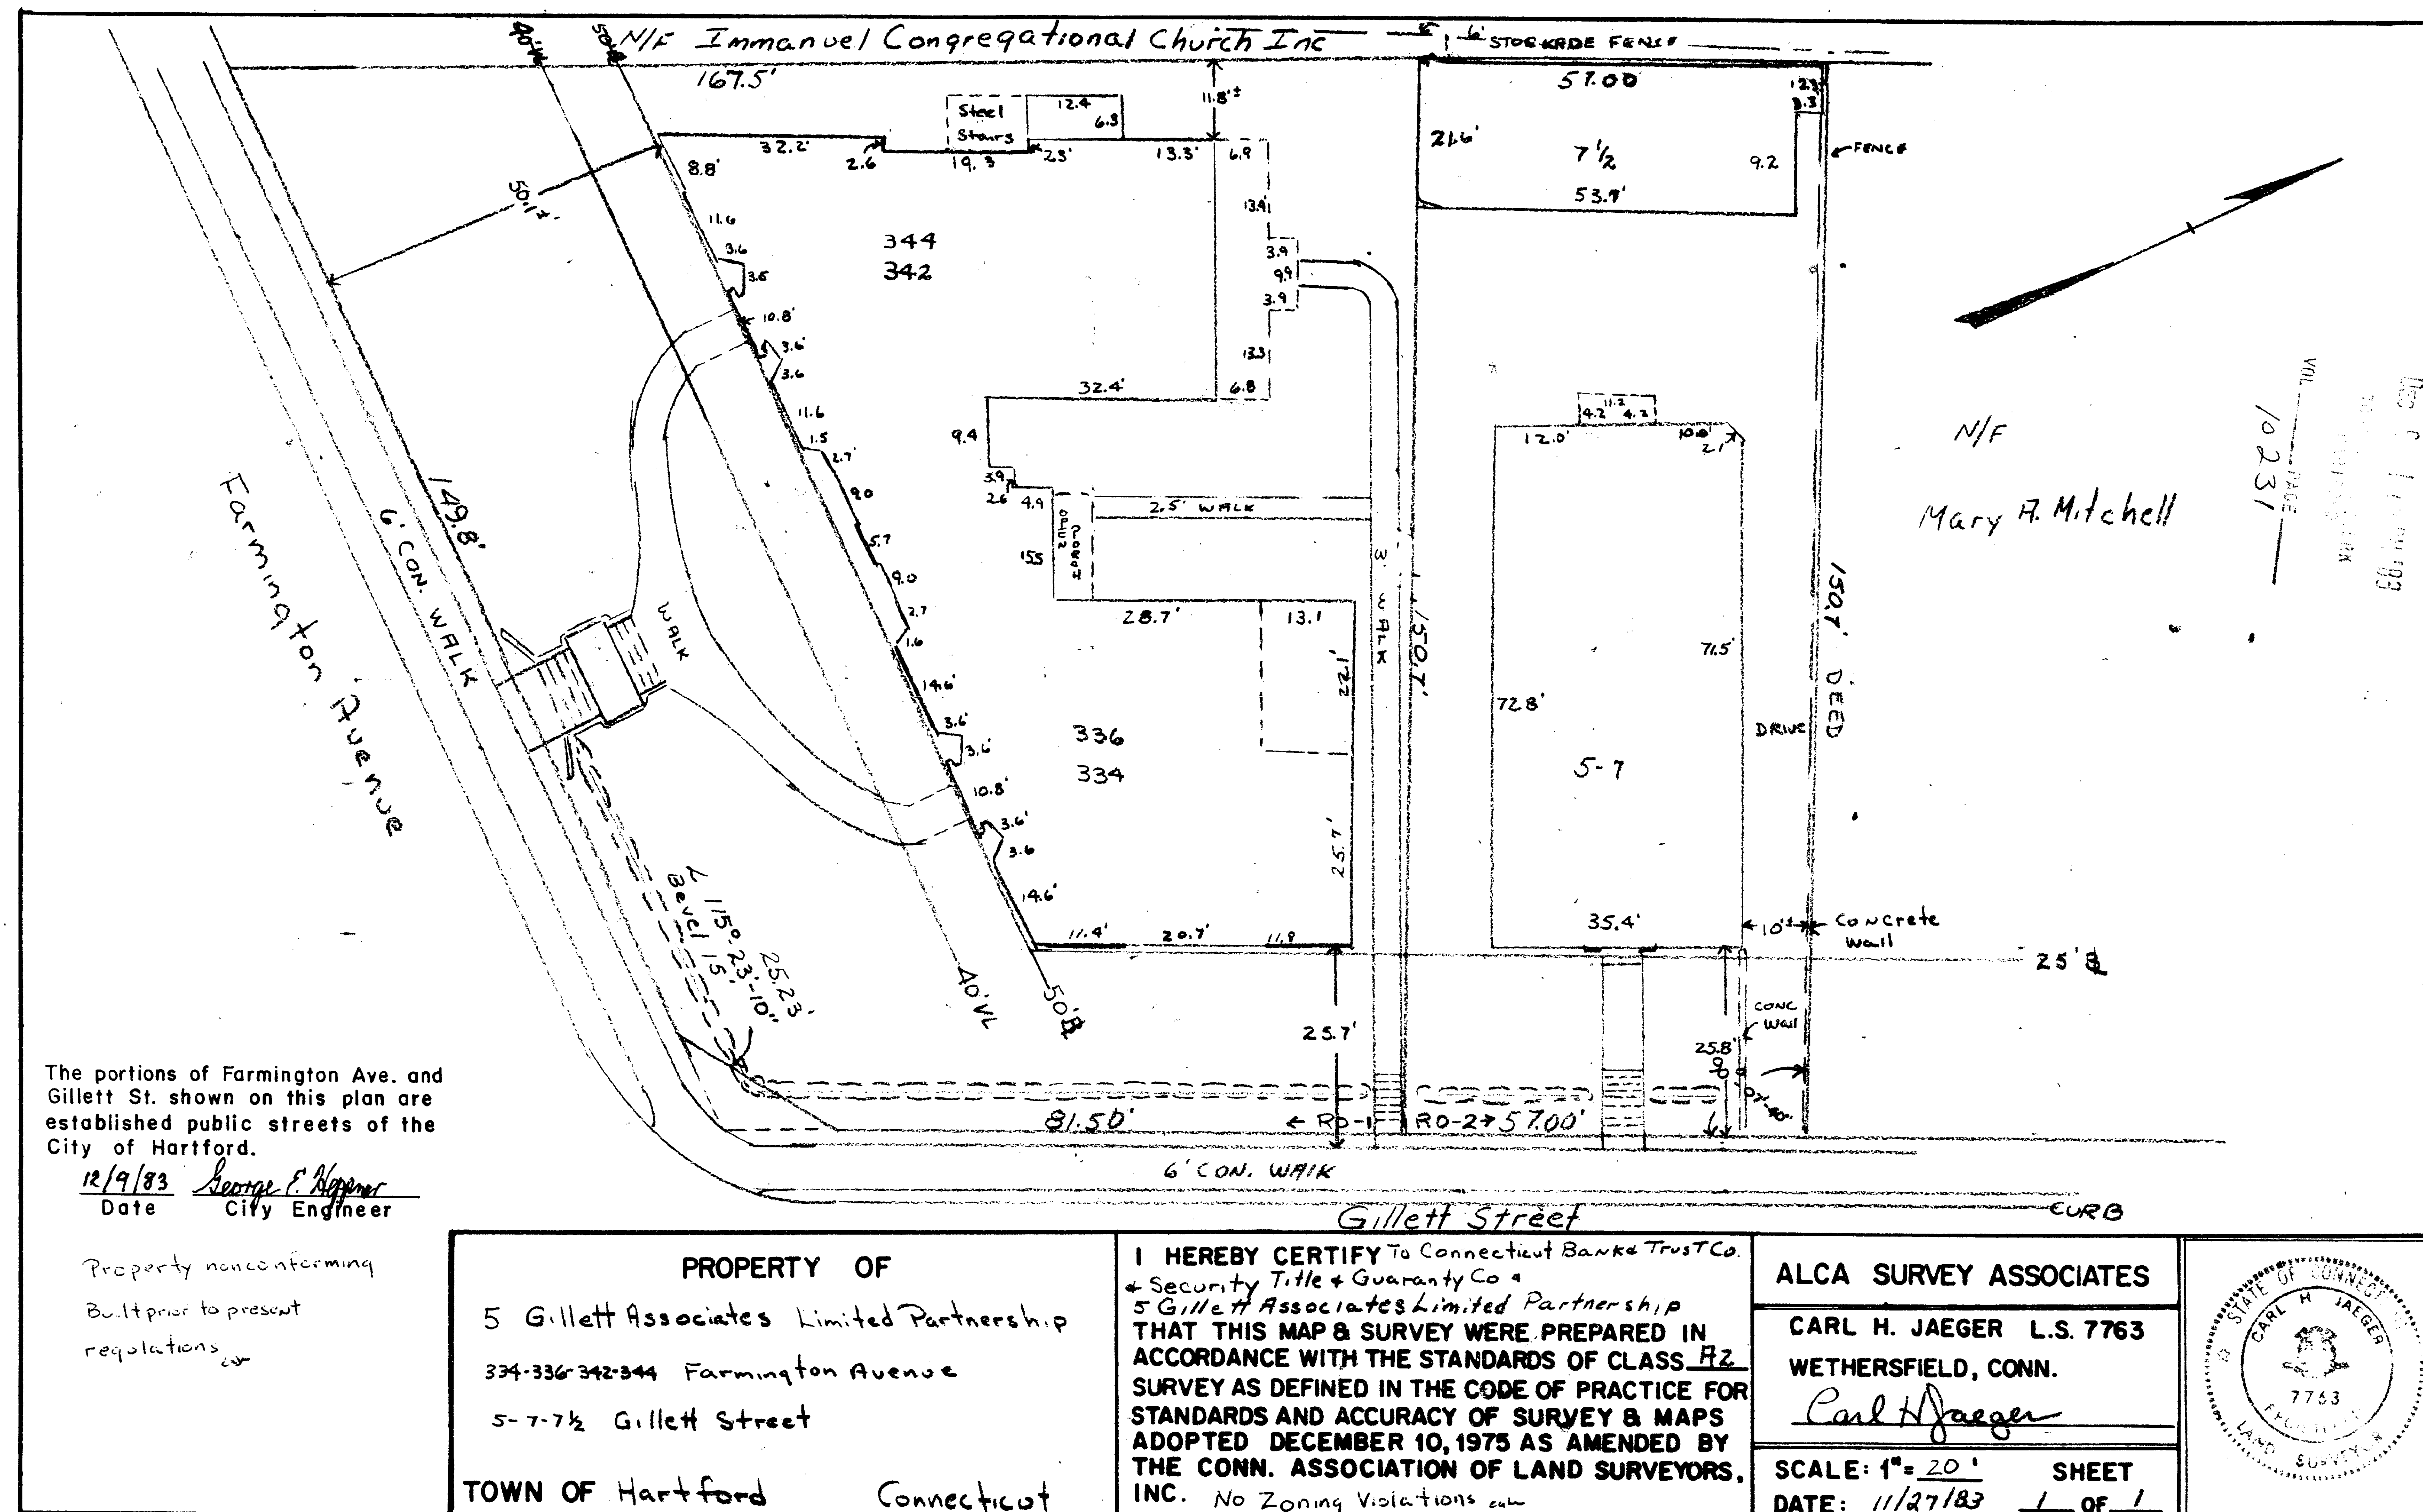

PLAN SIZE: 12" x 18"

