


CONGRESS STREET CONDOMINIUM—AN EXPANDABLE CONDOMINIUM
DECLARANT: HISTORIC HARTFORD HOUSING ASSOCIATES

CONGRESS STREET & MAPLE AVENUE
HARTFORD, CONNECTICUT

SCALE: 1 INCH = 20 FEET DECEMBER, 1983
PETERSEN & HOFFMAN, LAND SURVEYORS

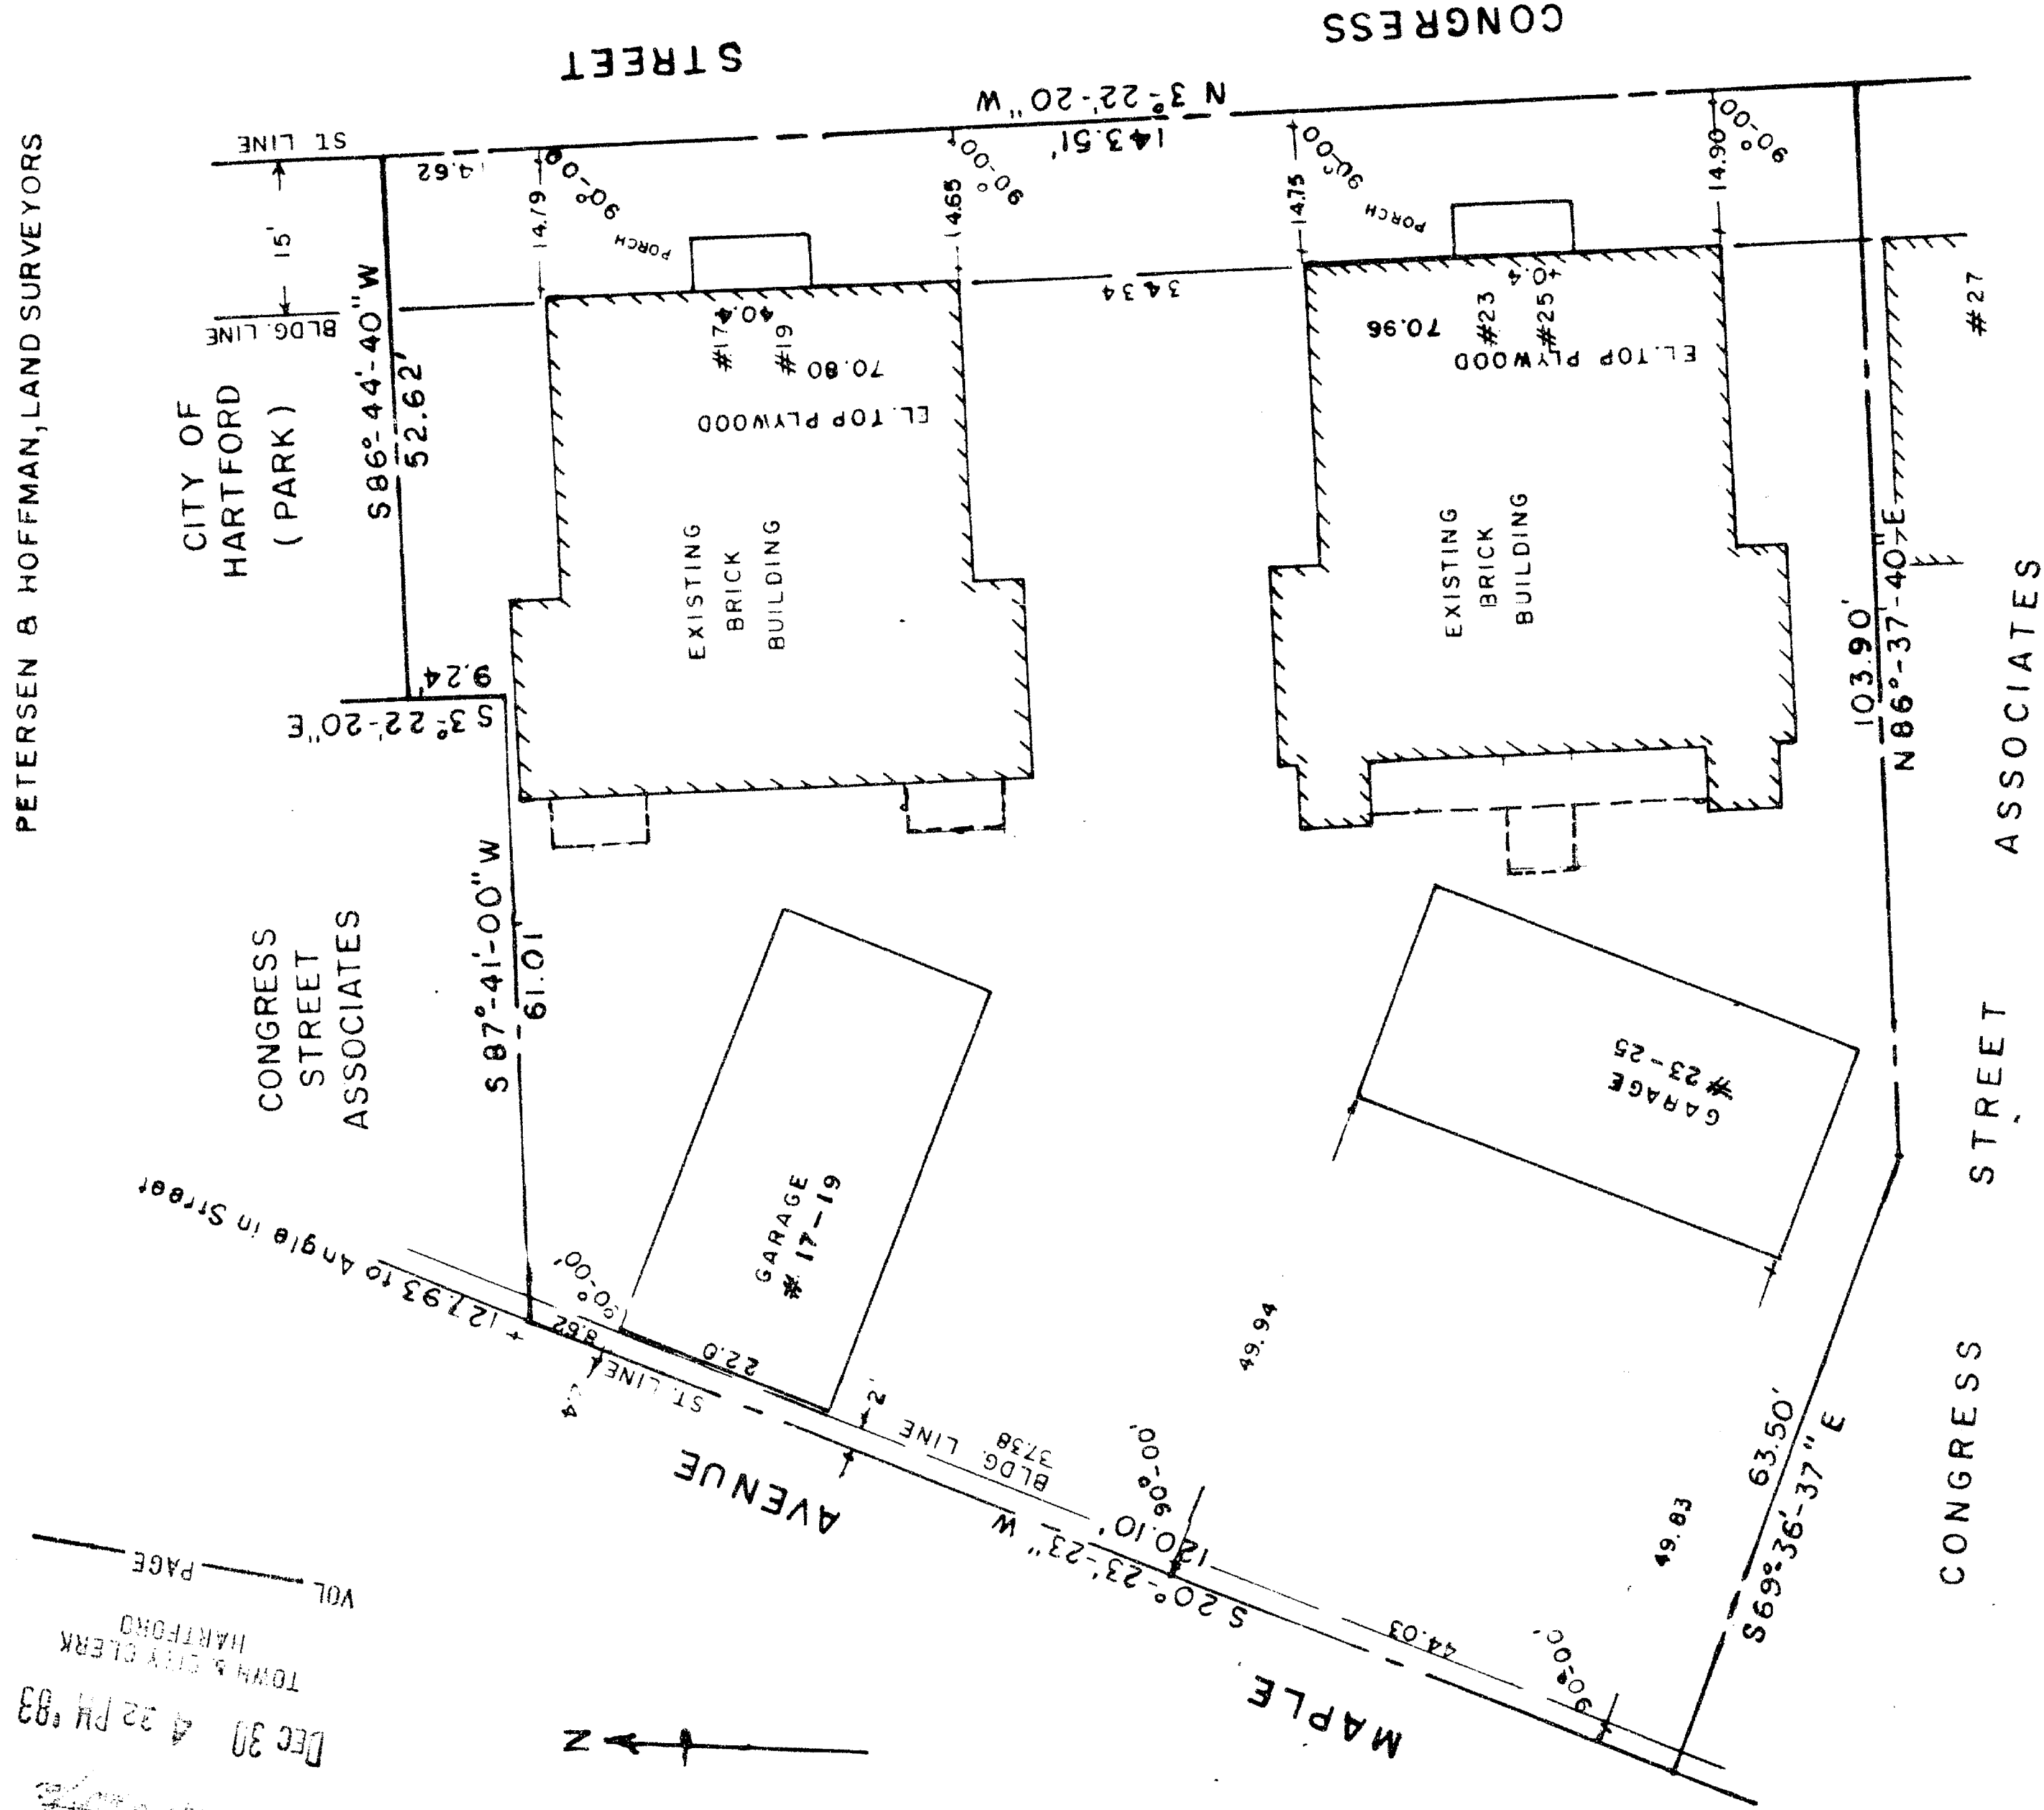


NOTE: BUILDINGS ARE SHOWN AS LOCATED UPON THE
GROUND, AND ARE OVER THE PRESENT BUILDING
LINE 1" TO 3".

The portions of Maple Ave. and Congress St. shown
on this plan are established public streets of the
City of Hartford.

1/10/84 Date
George E. Hoffman City Engineer

I HEREBY CERTIFY THAT THIS MAP AND SURVEY WERE PREPARED IN ACCORDANCE
WITH THE STANDARDS OF A CLASS "A-2" SURVEY AS DEFINED IN THE CODE OF
PRACTICE FOR STANDARDS OF ACCURACY OF SURVEYS AND MAPS ADOPTED
DECEMBER 10, 1975 AS AMENDED BY THE CONNECTICUT ASSOCIATION OF LAND
SURVEYORS, INC.

Alton E. Smith SURVEYOR DEC. 19 1983 DATE 2967 REGISTRATION NO.

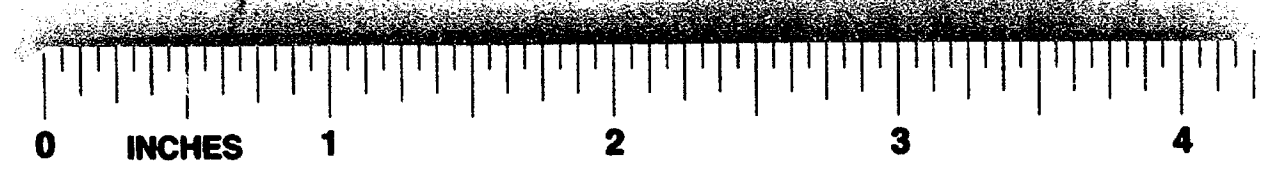

EASI FILE CORP. IRVINE CA EFM 34
1324

1324-1

N.B. 8-111-78 F.B. 42-180

127