
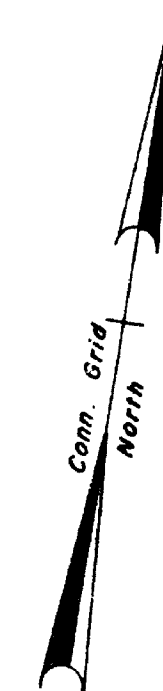


Zone: R-1
Area = 89 129 s.f.
(2.046 acr.)

WEST BOULEVARD

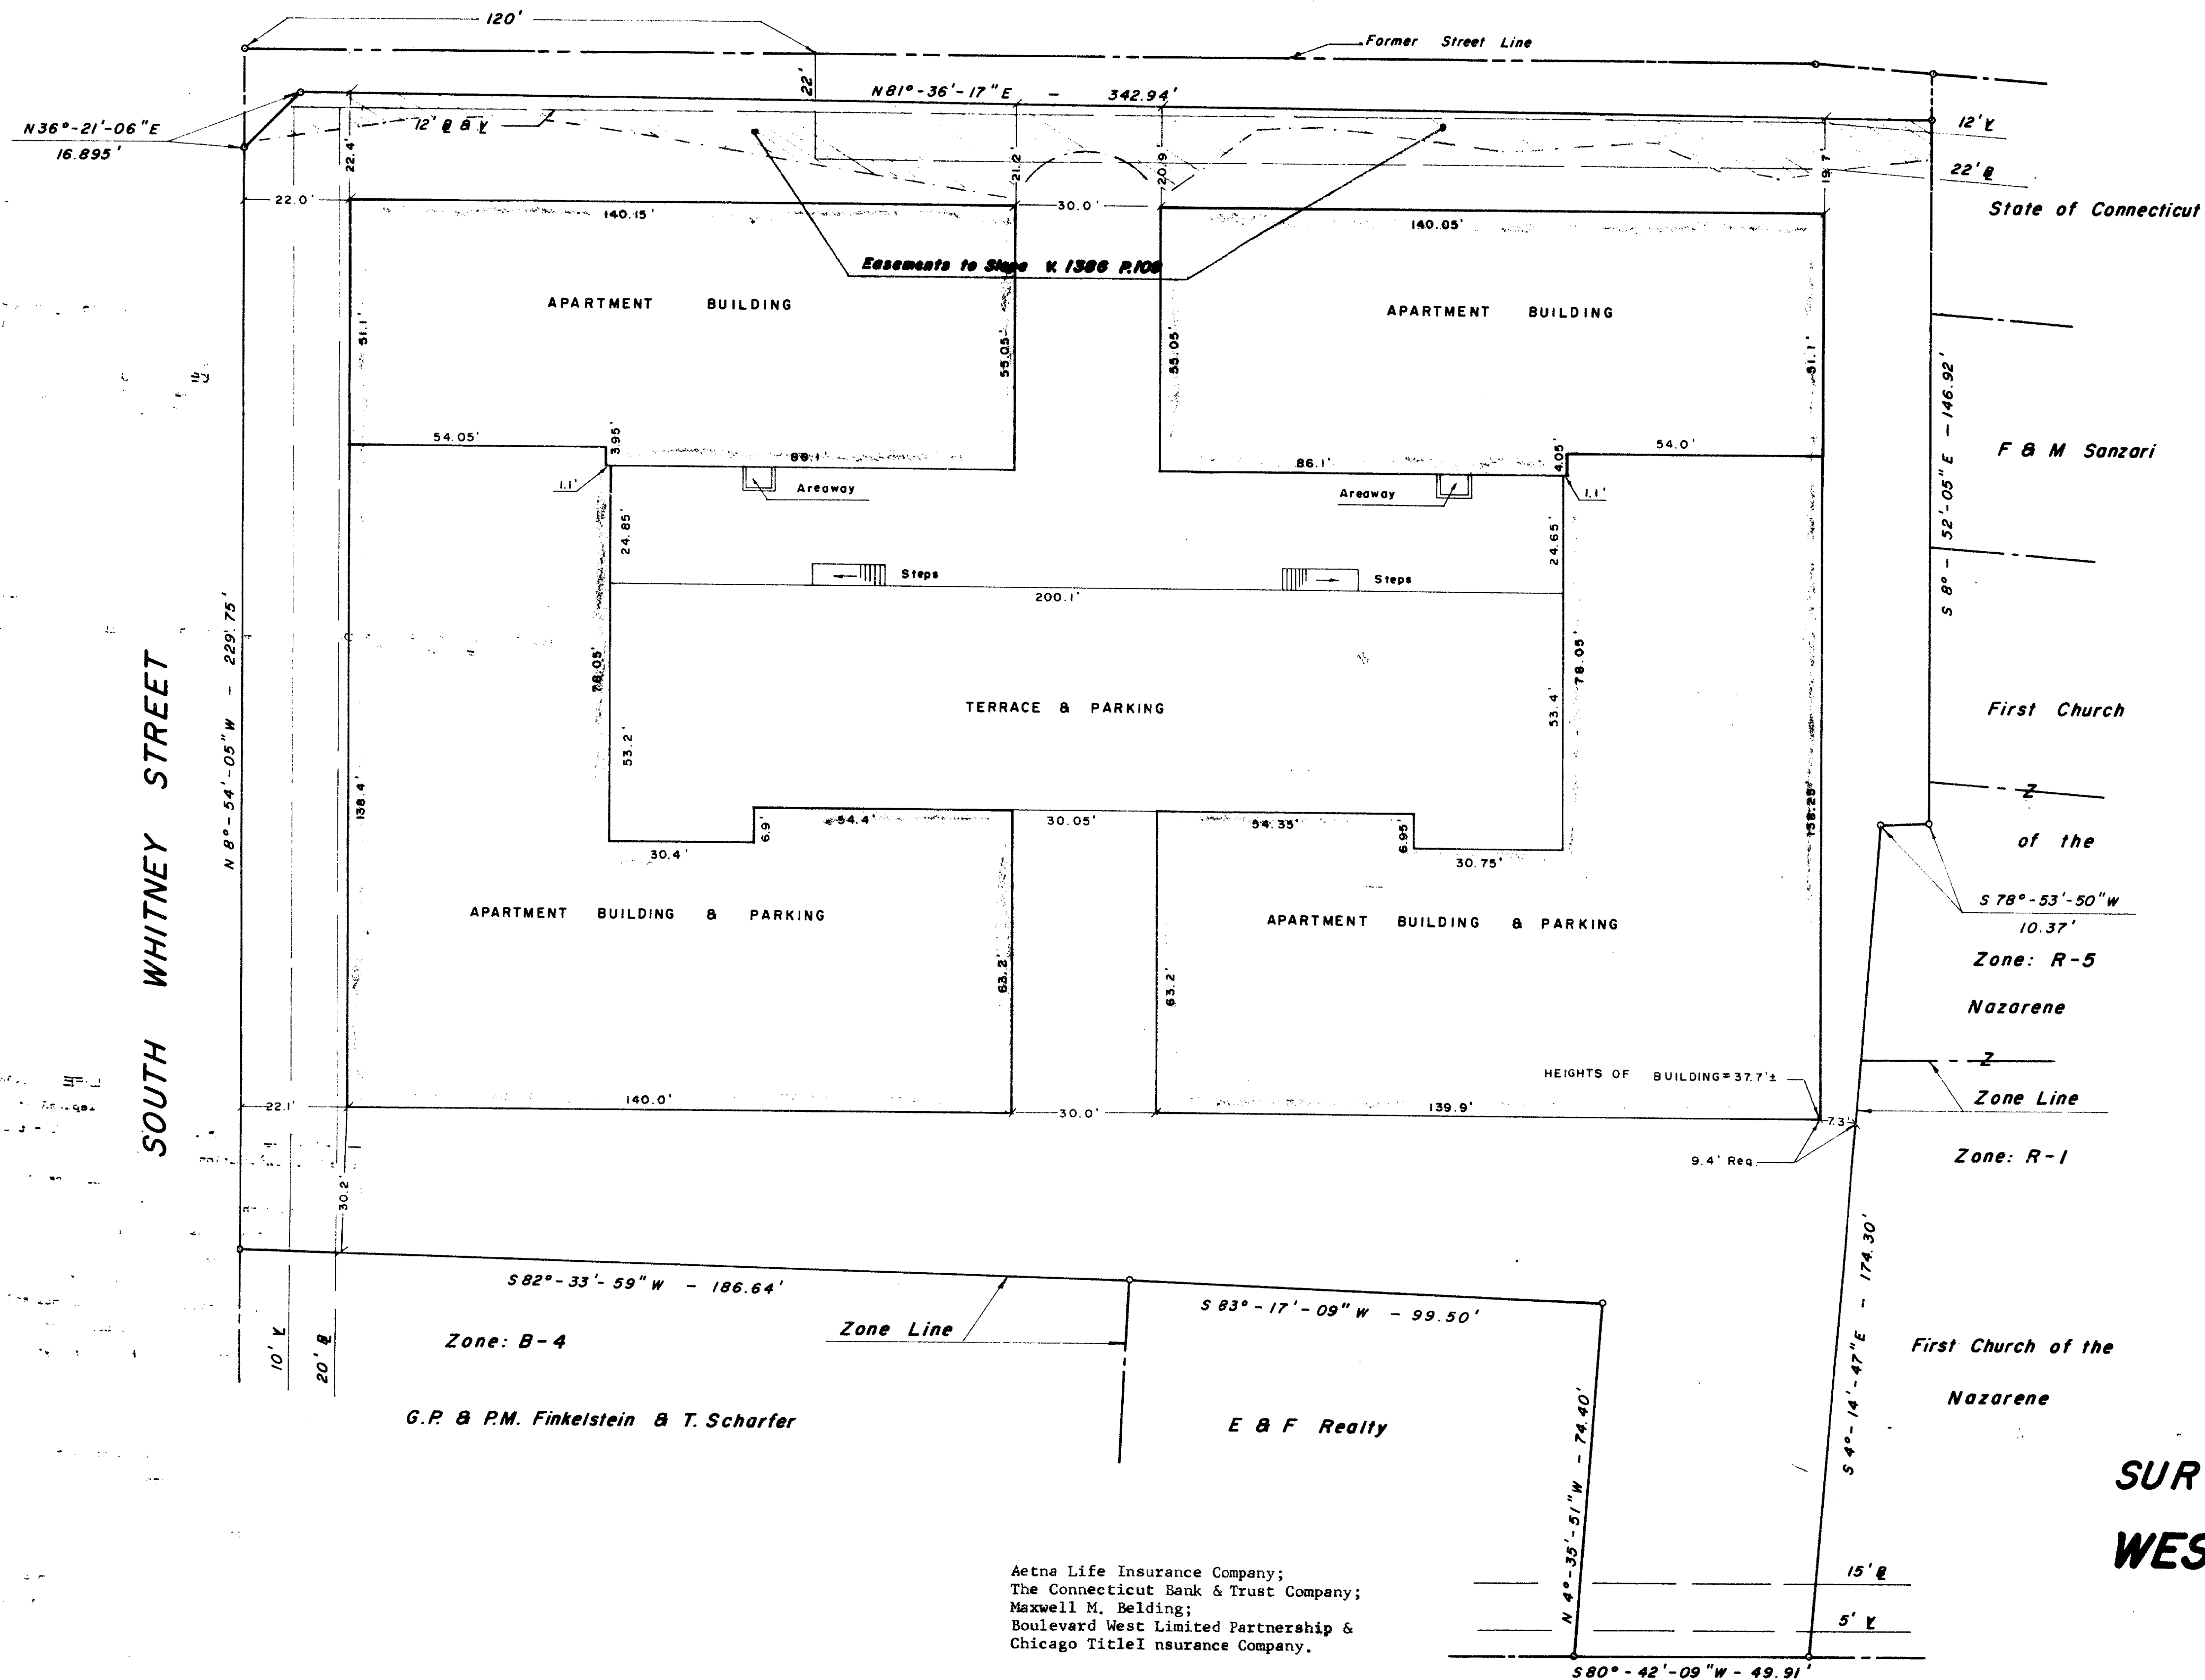


**SURVEY MAP
WEST BOULEVARD APARTMENTS**

HARTFORD, CONN.

Aetna Life Insurance Company;
The Connecticut Bank & Trust Company;
Maxwell M. Belding;
Boulevard West Limited Partnership &
Chicago Title Insurance Company.


[Signature]
Professional Engineer and Land Surveyor

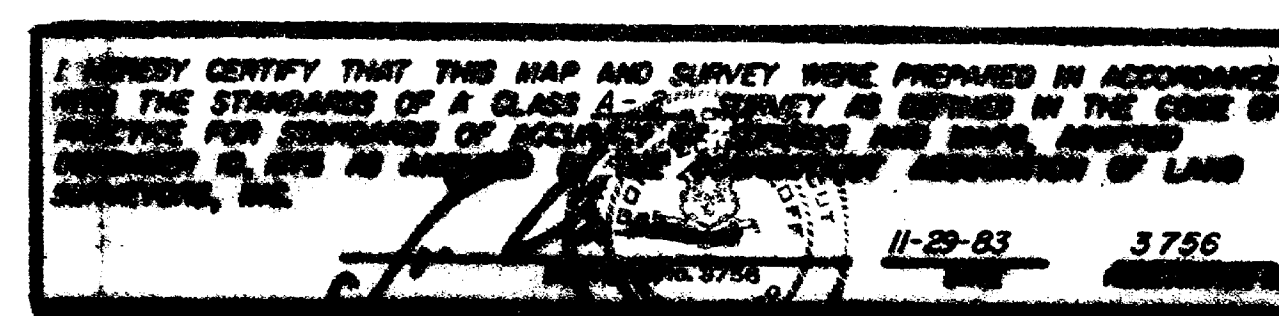

IGOR VECHESSLOFF
PROFESSIONAL ENGINEER & LAND SURVEYOR
51 LORRAINE STREET
HARTFORD, CONNECTICUT
SCALE 1" = 20'
DATE 11-29-83
DRAWING NO. 1105

RECEIVED BY
DEC 23 9 35 AM '83
TOWN ENGINEER
HARTFORD
VNL - PAGE

The portions of So. Whitney St., West Boulevard and Capitol Ave. shown on this plan are established public streets of the City of Hartford.
11/5/84
Date
[Signature]
City Engineer

1330

