
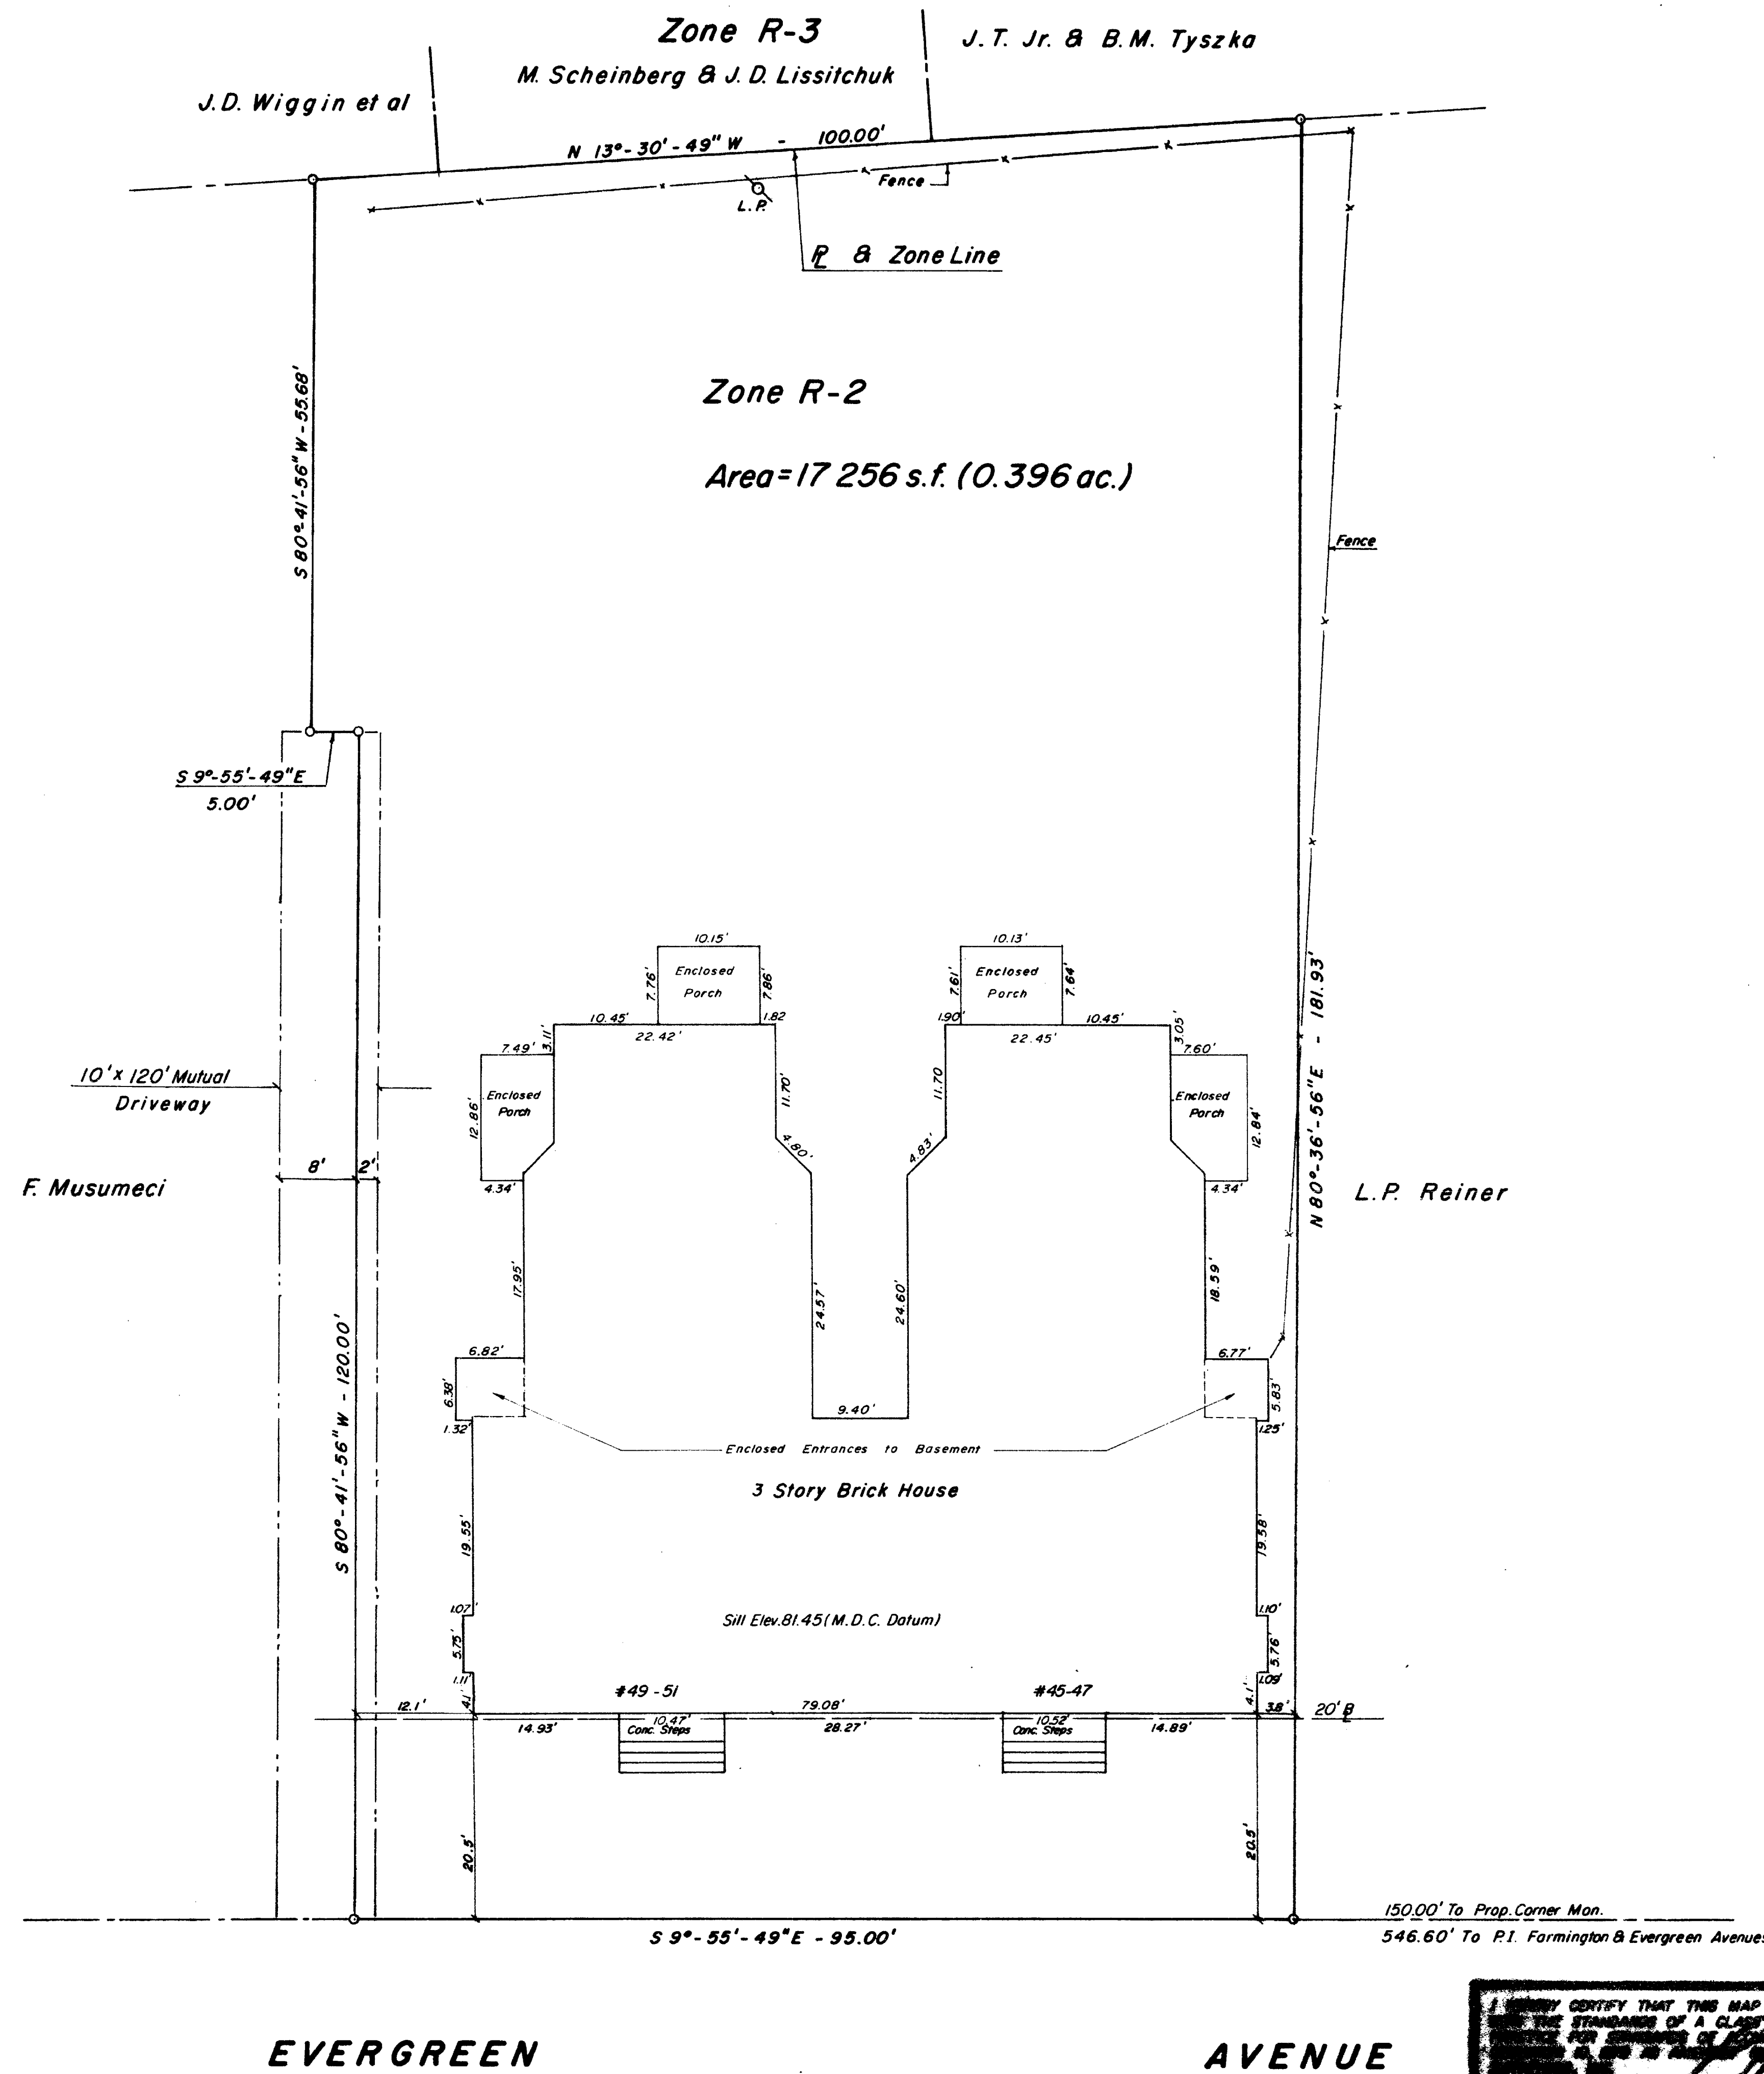


Change of Title II - 20-83
Add. Info. II-10-83

IGOR VECHESLOFF
PROFESSIONAL ENGINEER & LAND SURVEYOR
51 LORRAINE STREET
HARTFORD, CONNECTICUT

SCALE 1" = 10'
DATE 10-18-83
DRAWING NO. 1979

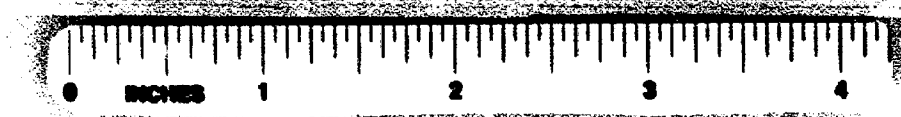

1332

123

1332

11041
RECEIVED
DEC 28 4 06 PM '83
TOWN ENGINEER
HARTFORD
VOL. PAGE