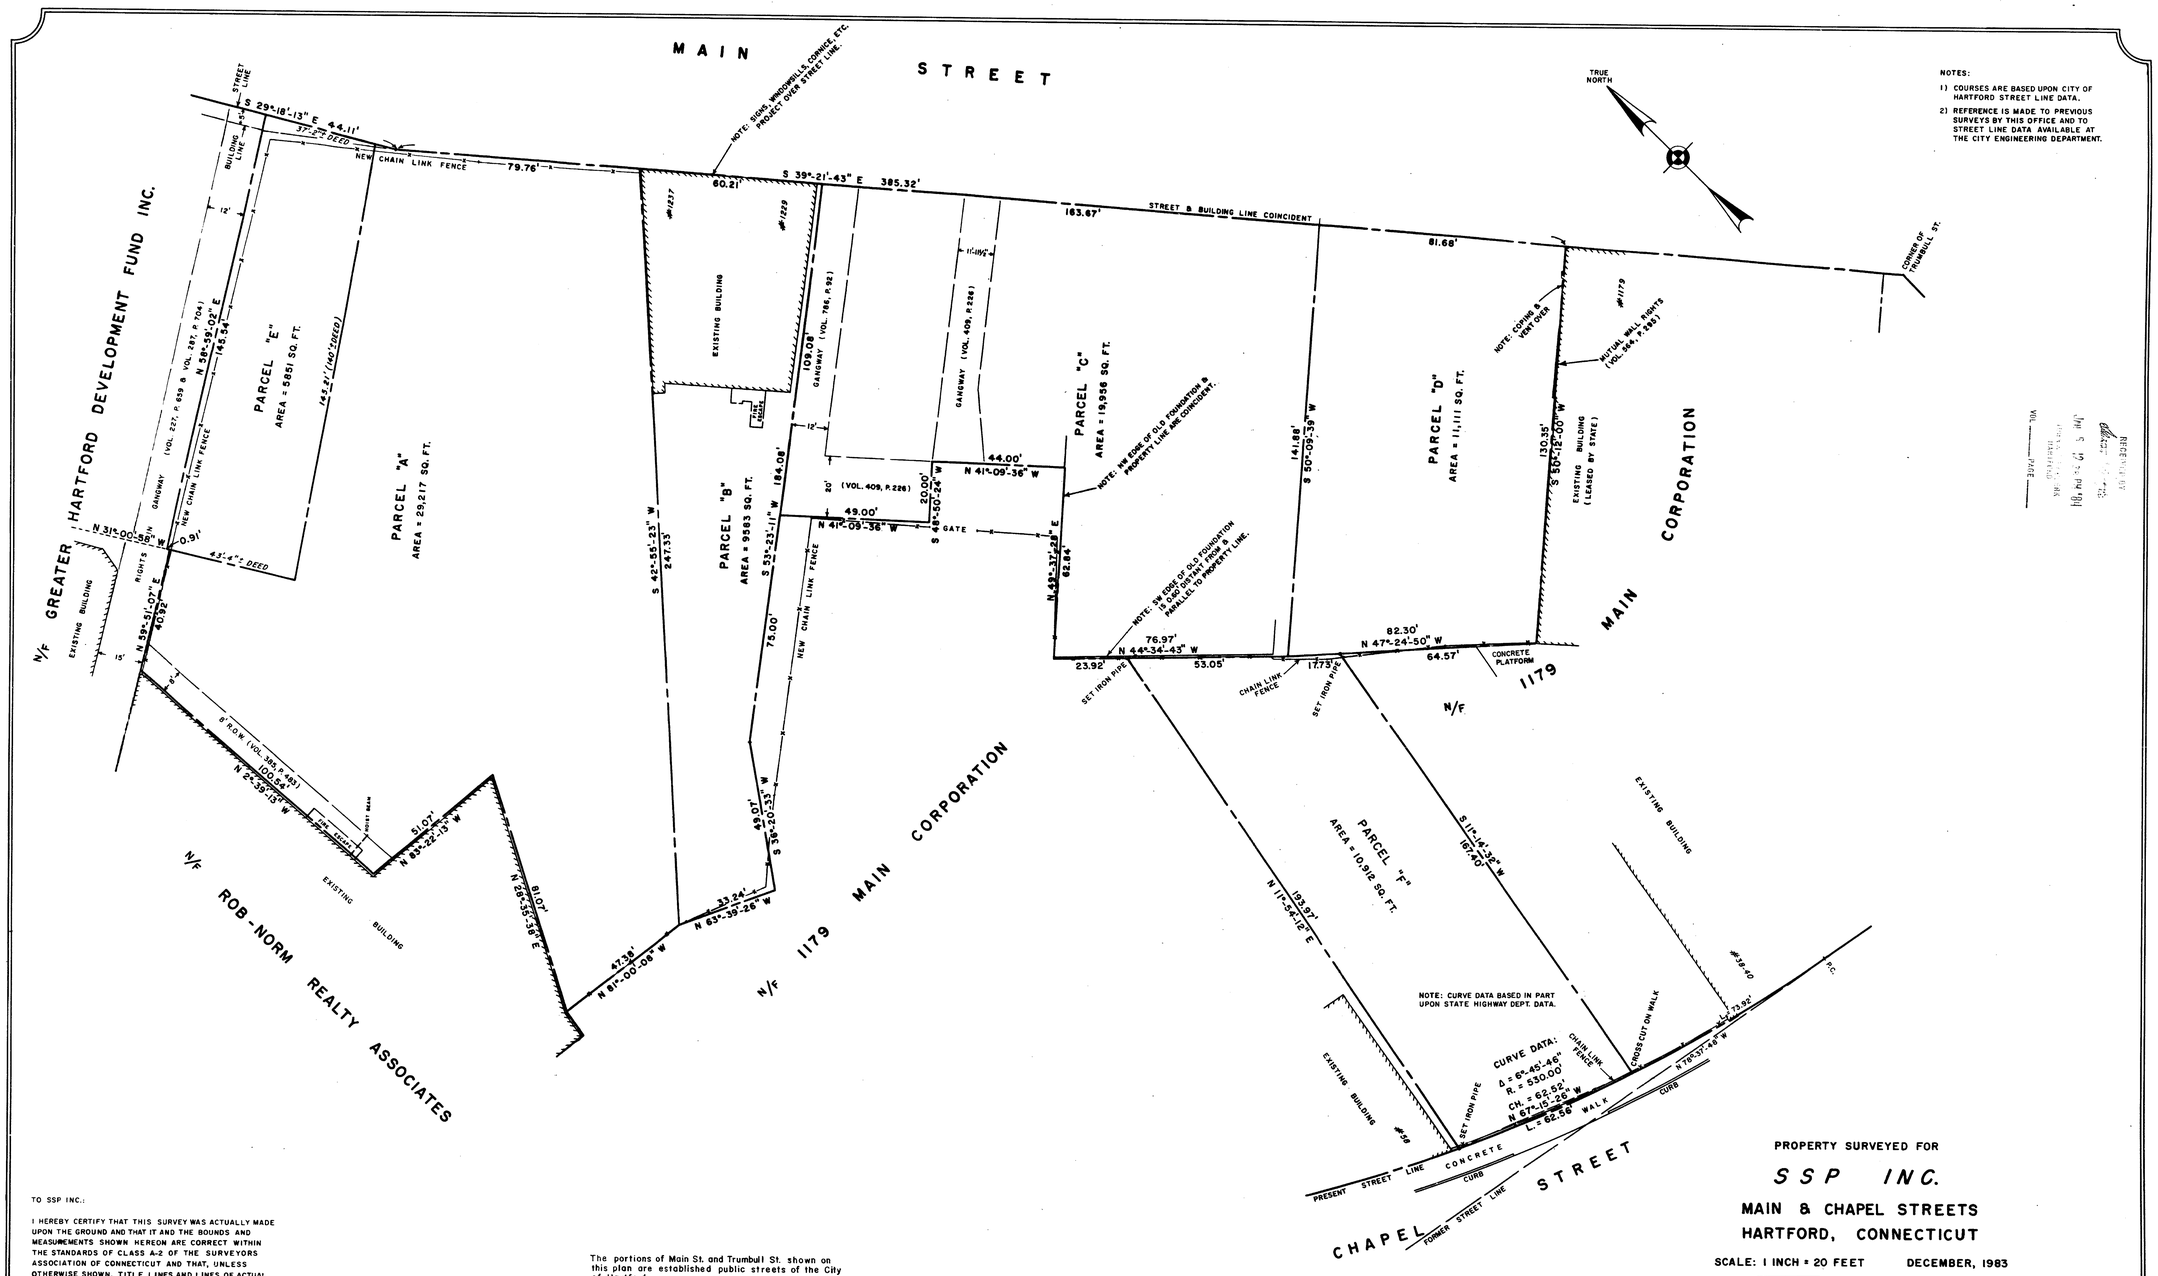

TO SSP INC.:

I HEREBY CERTIFY THAT THIS SURVEY WAS ACTUALLY MADE UPON THE GROUND AND THAT IT AND THE BOUNDS AND MEASUREMENTS SHOWN HEREON ARE CORRECT WITHIN THE STANDARDS OF CLASS A-2 OF THE SURVEYORS ASSOCIATION OF CONNECTICUT AND THAT, UNLESS OTHERWISE SHOWN, TITLE LINES AND LINES OF ACTUAL POSSESSION ARE THE SAME, BUILDINGS ARE LOCATED AS SHOWN AND DO NOT ENCROACH OVER OR UPON STREET, TITLE OR BUILDING LINES, THERE ARE NO VIOLATIONS OF ZONING REGULATIONS WITH REFERENCE TO THE LOCATION OF SAID BUILDINGS, AND THERE ARE NO EASEMENTS OR ENCROACHMENTS AFFECTING THIS PROPERTY APPARENT FROM A CAREFUL INSPECTION OF THE SAME.

DEC. 15, 1983 Malvin C. Steed Jr.

STATE OF CONNECTICUT — MALVIN C. STEED JR. — No. 5585 — LAND SURVEYOR

The portions of Main St. and Trumbull St. shown on this plan are established public streets of the City of Hartford.
The portion of Chapel St. is City maintained.

1/27/84 Date — George E. Hoffman City Engineer

PROPERTY SURVEYED FOR

SSP INC.

MAIN & CHAPEL STREETS
HARTFORD, CONNECTICUT

SCALE: 1 INCH = 20 FEET — DECEMBER, 1983

0 5 10 15 20

PREPARED BY:
PETERSEN & HOFFMAN — LAND SURVEYORS
SUCCESSORS TO SPENCER & WASHBURN, INC.
1169 MAIN ST., EAST HARTFORD, CONN. (06108)

R.B. 5112-60, 179-62 P.B. 43-47, 128

1335

1335-

0 INCHES 1 2 3 4