
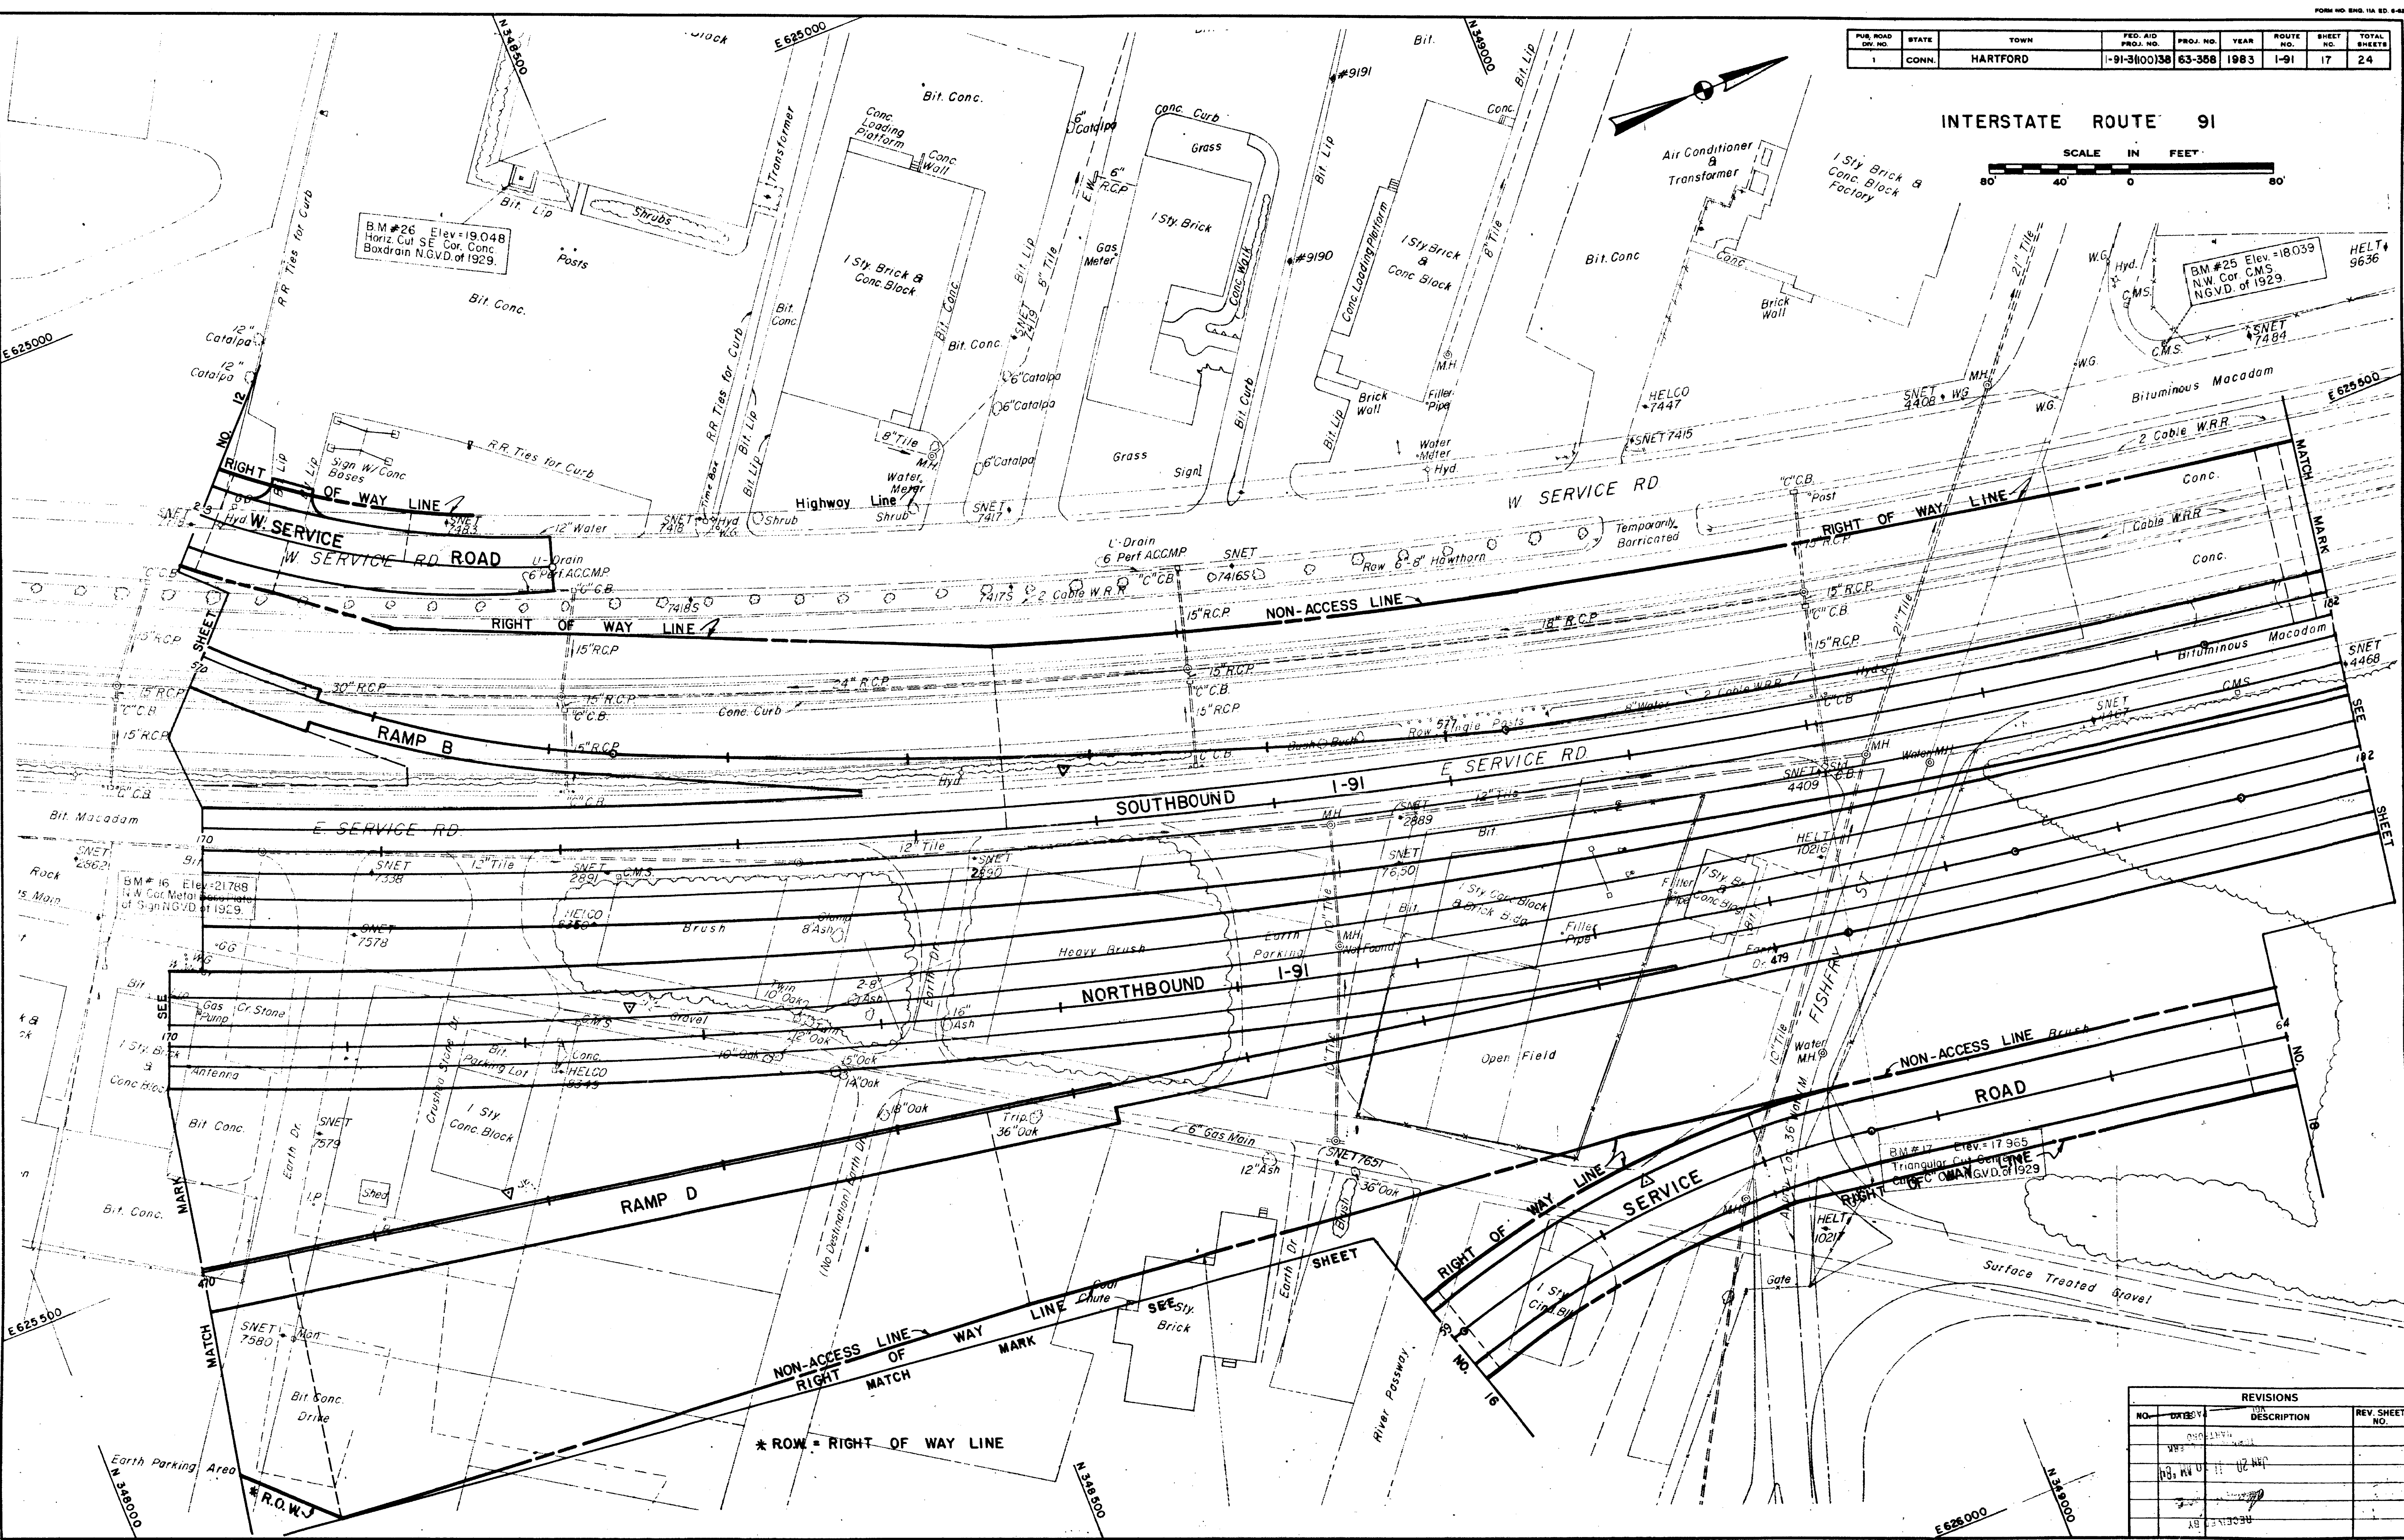


PUR. ROAD	STATE	TOWN	FED. AID	PROJ. NO.	YEAR	ROUTE	SHEET	TOTAL
1	CONN.	HARTFORD	1-91-3100138	63-358	1983	1-91	17	24

INTERSTATE ROUTE 91

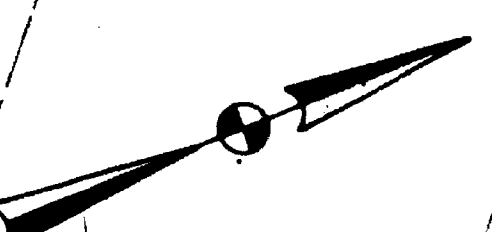

PLAN	NO.	DATE	CHECKED BY
Surveyed			
Plotted			
Designed			
Noted			
Top. Field Ch. Made			

1337-17

REVISIONS		
NO.	DATE	DESCRIPTION

135 #137

