


RECEIVED BY  
*[Signature]*  
Mar 14 12 17 PM '84  
TOWN CLERK  
HARTFORD  
VOL. \_\_\_\_\_ PAGE \_\_\_\_\_

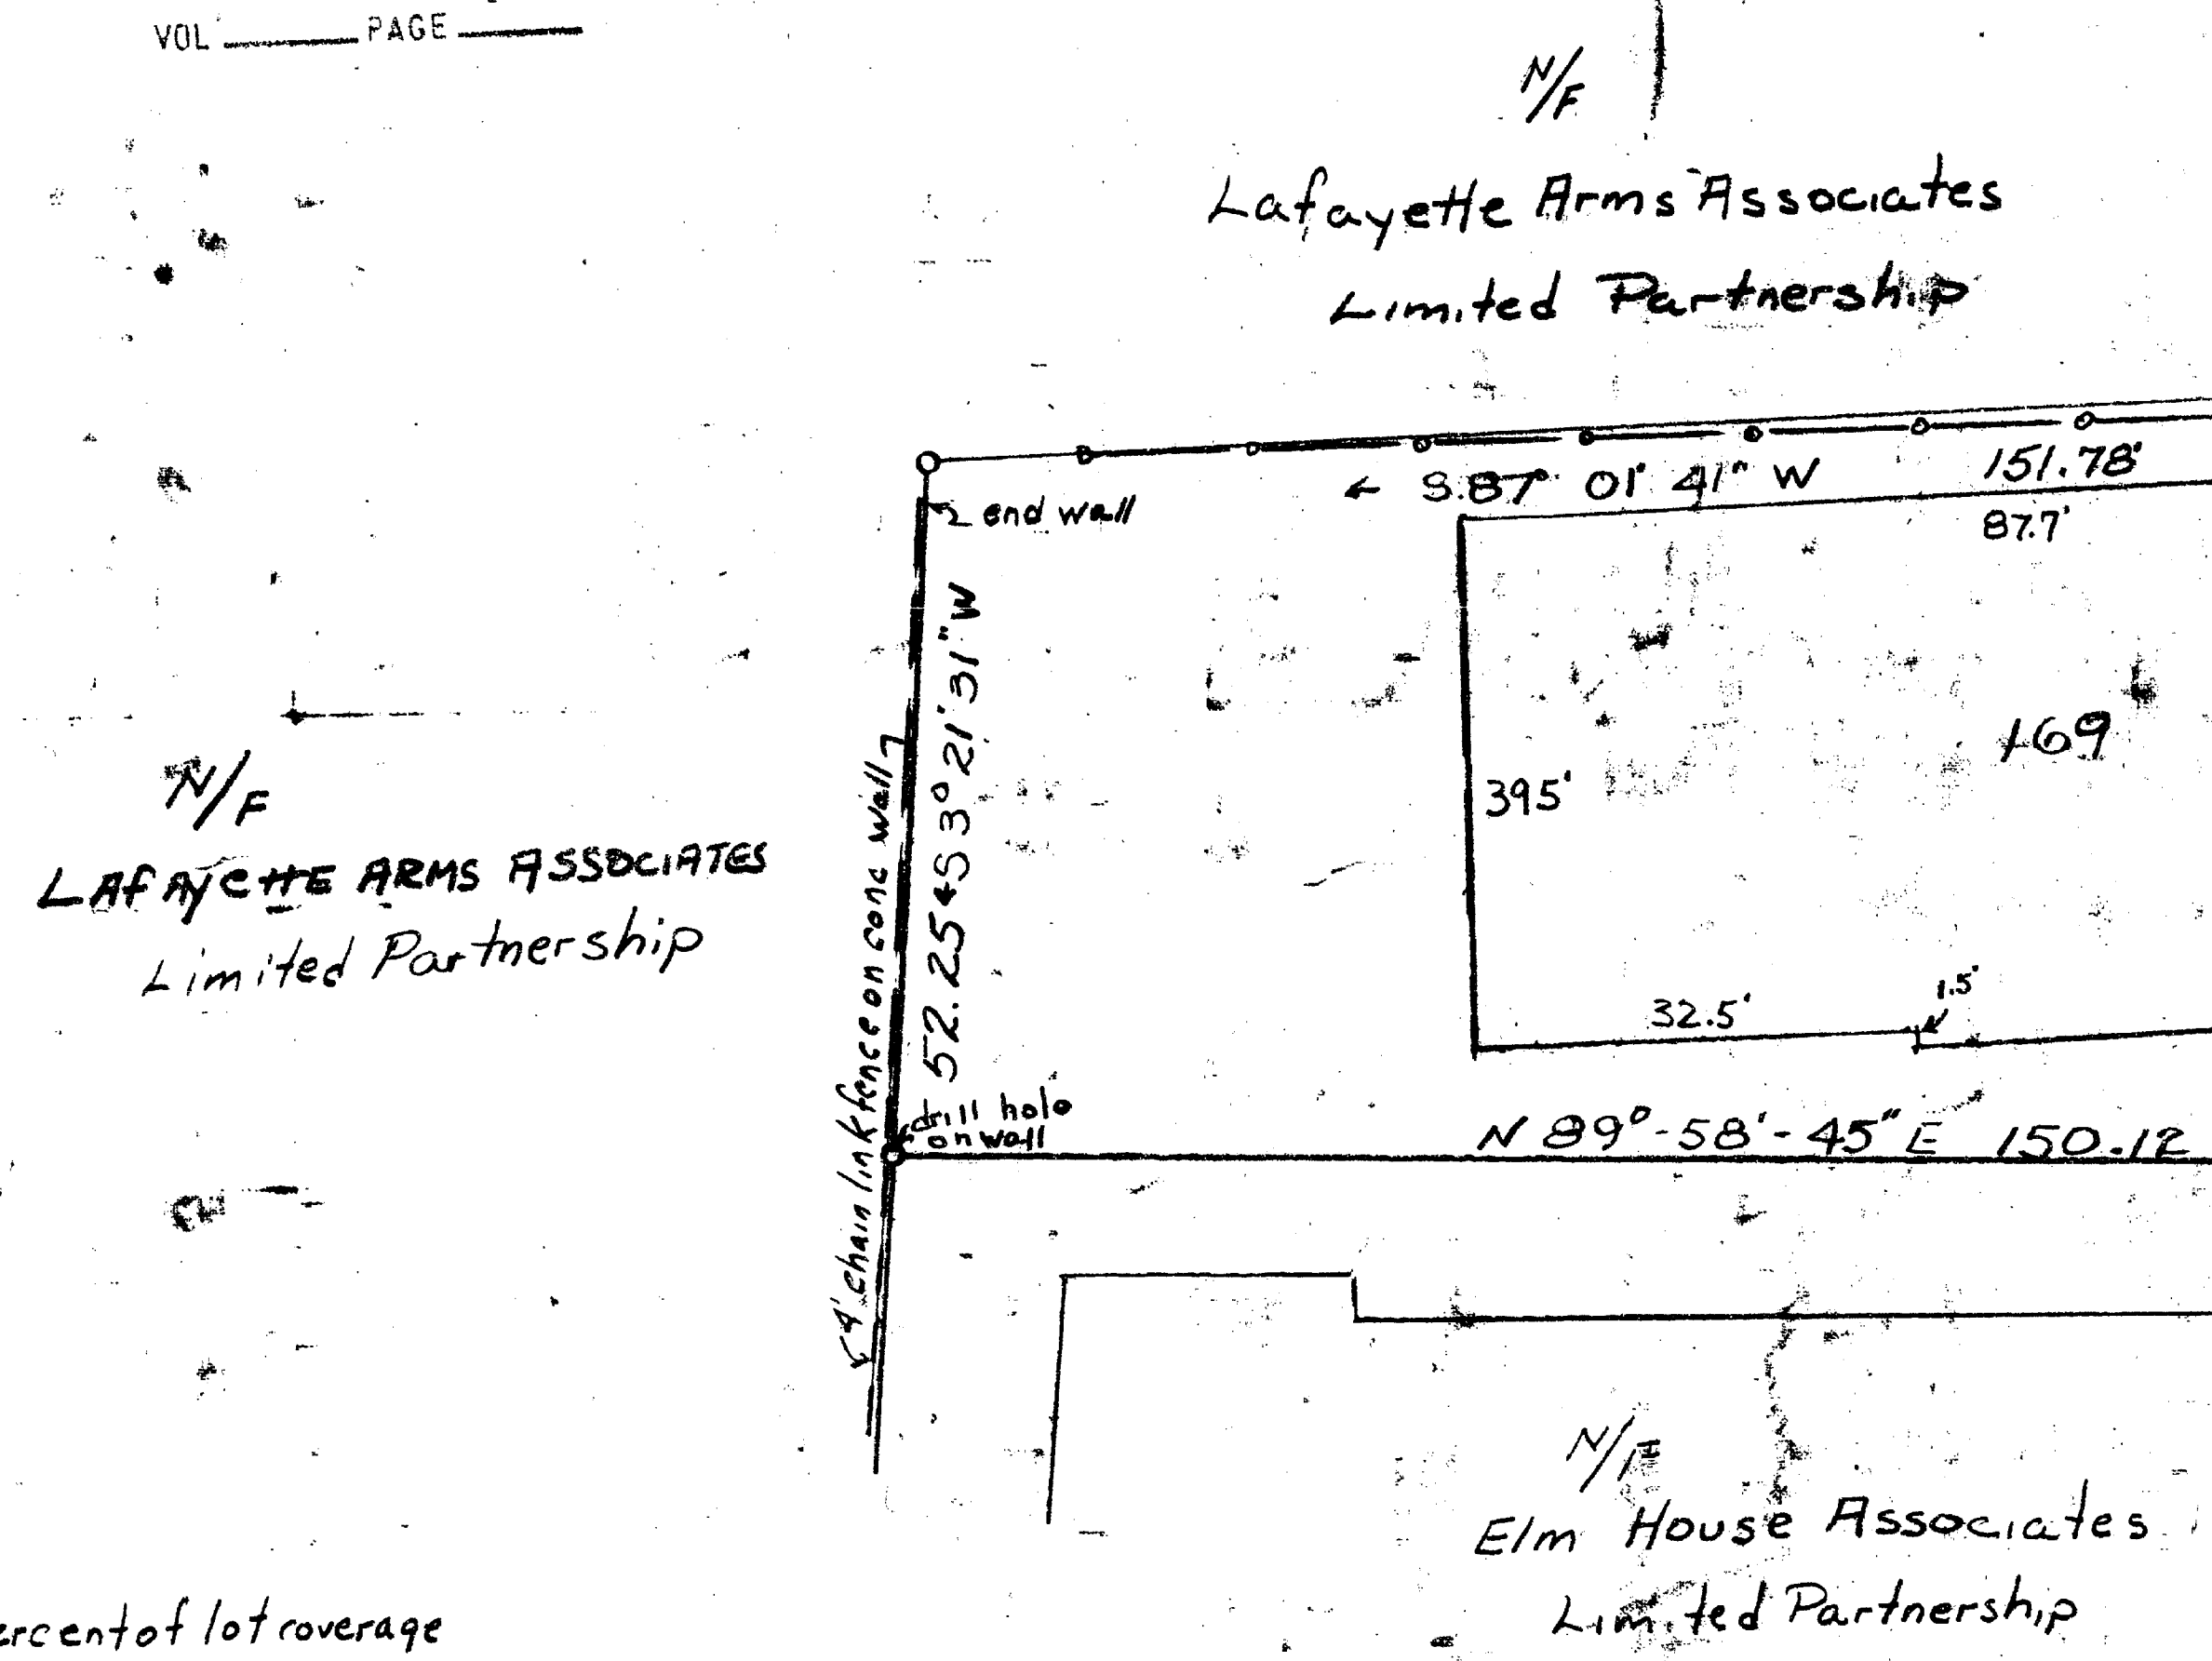

The portion of Seymour St. shown on this plan is an established public street of the City of Hartford.  
3/20/84 Date *George C. Neppner* City Engineer

Minimum percent of lot coverage for building & rear yard & side yard from conforming

|   |   |   |                          |
|---|---|---|--------------------------|
| PROPERTY OF<br>169 Seymour Associates Limited Partnership<br>169 Seymour Street<br>TOWN OF Hartford Connecticut | I. HEREBY CERTIFY To Bank of Hartford, Commonwealth Land Title Insurance Company<br>169 Seymour Associates Limited Partnership<br>THAT THIS MAP & SURVEY WERE PREPARED IN ACCORDANCE WITH THE STANDARDS OF CLASS B2 SURVEY AS DEFINED IN THE CODE OF PRACTICE FOR STANDARDS AND ACCURACY OF SURVEY & MAPS ADOPTED DECEMBER 10, 1975 AS AMENDED BY THE CONN. ASSOCIATION OF LAND SURVEYORS, INC. No Zoning Violations | ALCA SURVEY ASSOCIATES<br>CARL H. JAEGER L.S. 7763<br>WETHERSFIELD, CONN.<br><i>Carl H. Jaeger</i><br>SCALE: 1" = 20' SHEET 1 OF 1<br>DATE: 2-21-84 | <br>PLAN SIZE: 12" x 18" |
|   |   |   |                          |

144

1348

