EASH FILE CORP. IRVINE, CA EFH 34

1348

1348-2

29267

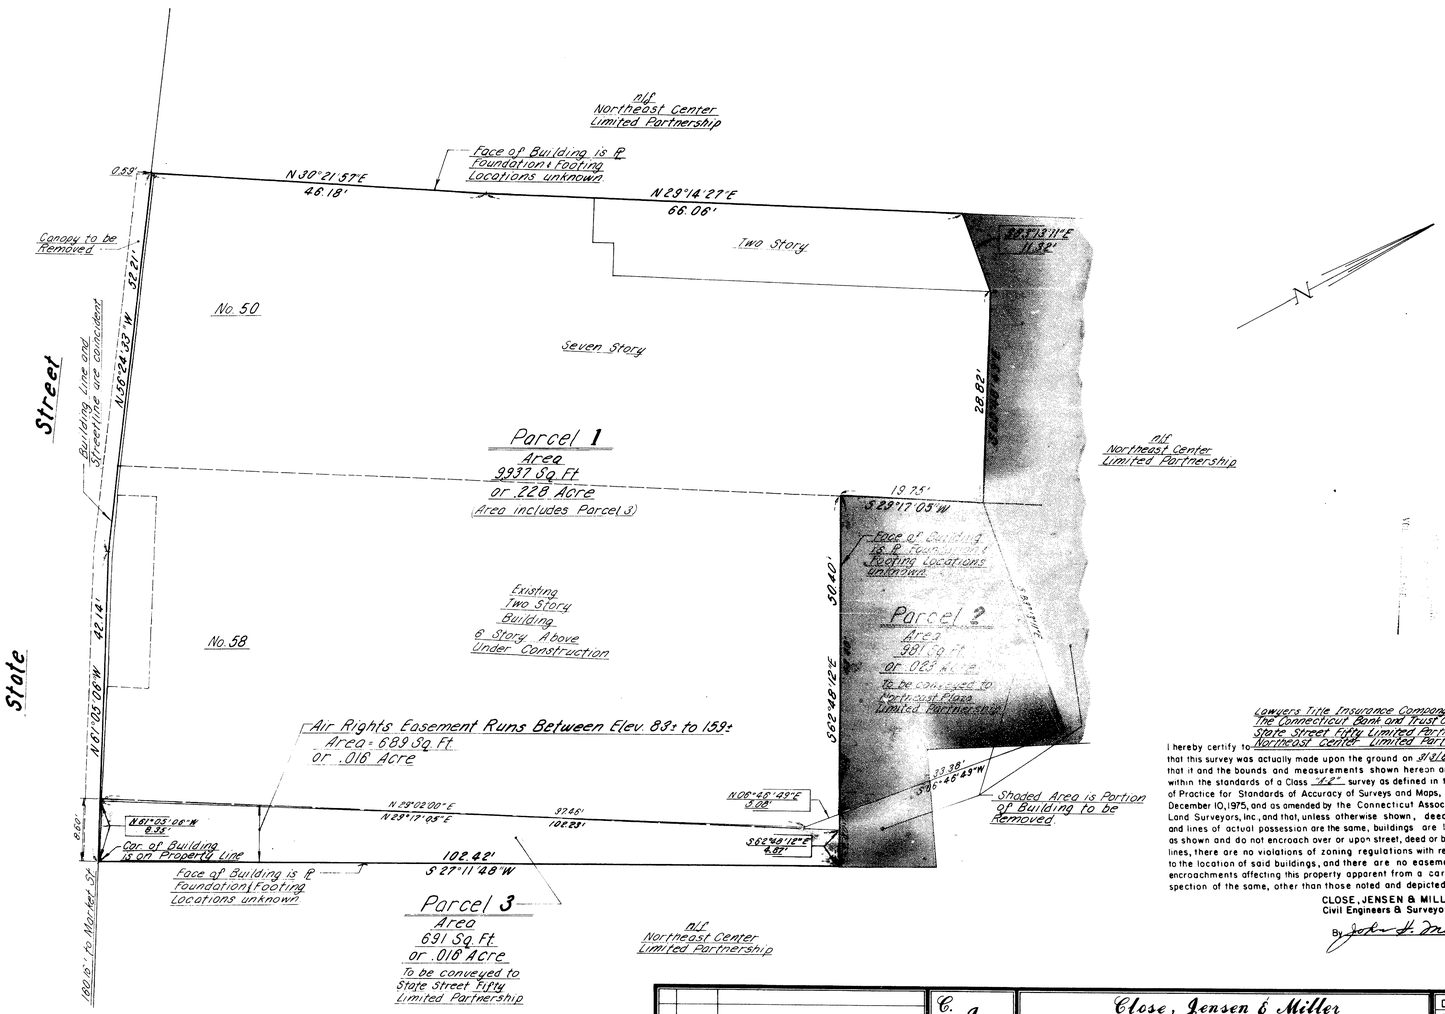

Lawyers Title Insurance Company,
The Connecticut Bank and Trust Company, N.A.,
State Street Fifty Limited Partnership and
Northeast Center Limited Partnership

I hereby certify to that this survey was actually made upon the ground on 3/1/84 and that it and the bounds and measurements shown hereon are correct within the standards of a Class A-2 survey as defined in the Code of Practice for Standards of Accuracy of Surveys and Maps, adopted December 10, 1975, and as amended by the Connecticut Association of Land Surveyors, Inc., and that, unless otherwise shown, deed lines and lines of actual possession are the same, buildings are located as shown and do not encroach over or upon street, deed or building lines, there are no violations of zoning regulations with reference to the location of said buildings, and there are no easements or encroachments affecting this property apparent from a careful inspection of the same, other than those noted and depicted hereon.

CLOSE, JENSEN & MILLER
Civil Engineers & Surveyors

By John H. Miller

The portion of State St. shown on this plan is an established public street of the City of Hartford.

4/9/84 — Date

George C. Hanmer — City Engineer

Note Elevations shown are on M.D.C. Datum.

No.	Date	Description
		Revisions

STATE OF CONNECTICUT — JOHN H. MILLER — No. 4142 — REGISTERED LAND SURVEYOR

C. J. M.

Close, Jensen & Miller
Consulting Engineers, Land Planners & Surveyors
449 Silas Deane Highway Wethersfield, Connecticut 06109

Property Of
State Street Fifty
Limited Partnership
50-58 State Street
Hartford, Connecticut

Designed	
Drawn	K.D.
Checked	J.H.M.
Scale	1" = 10'
Date	March 28, 1984
Sheet No.	One
Of	One
Job No.	2389
File No.	

1348 148

0 INCHES 1 2 3 4