


1353

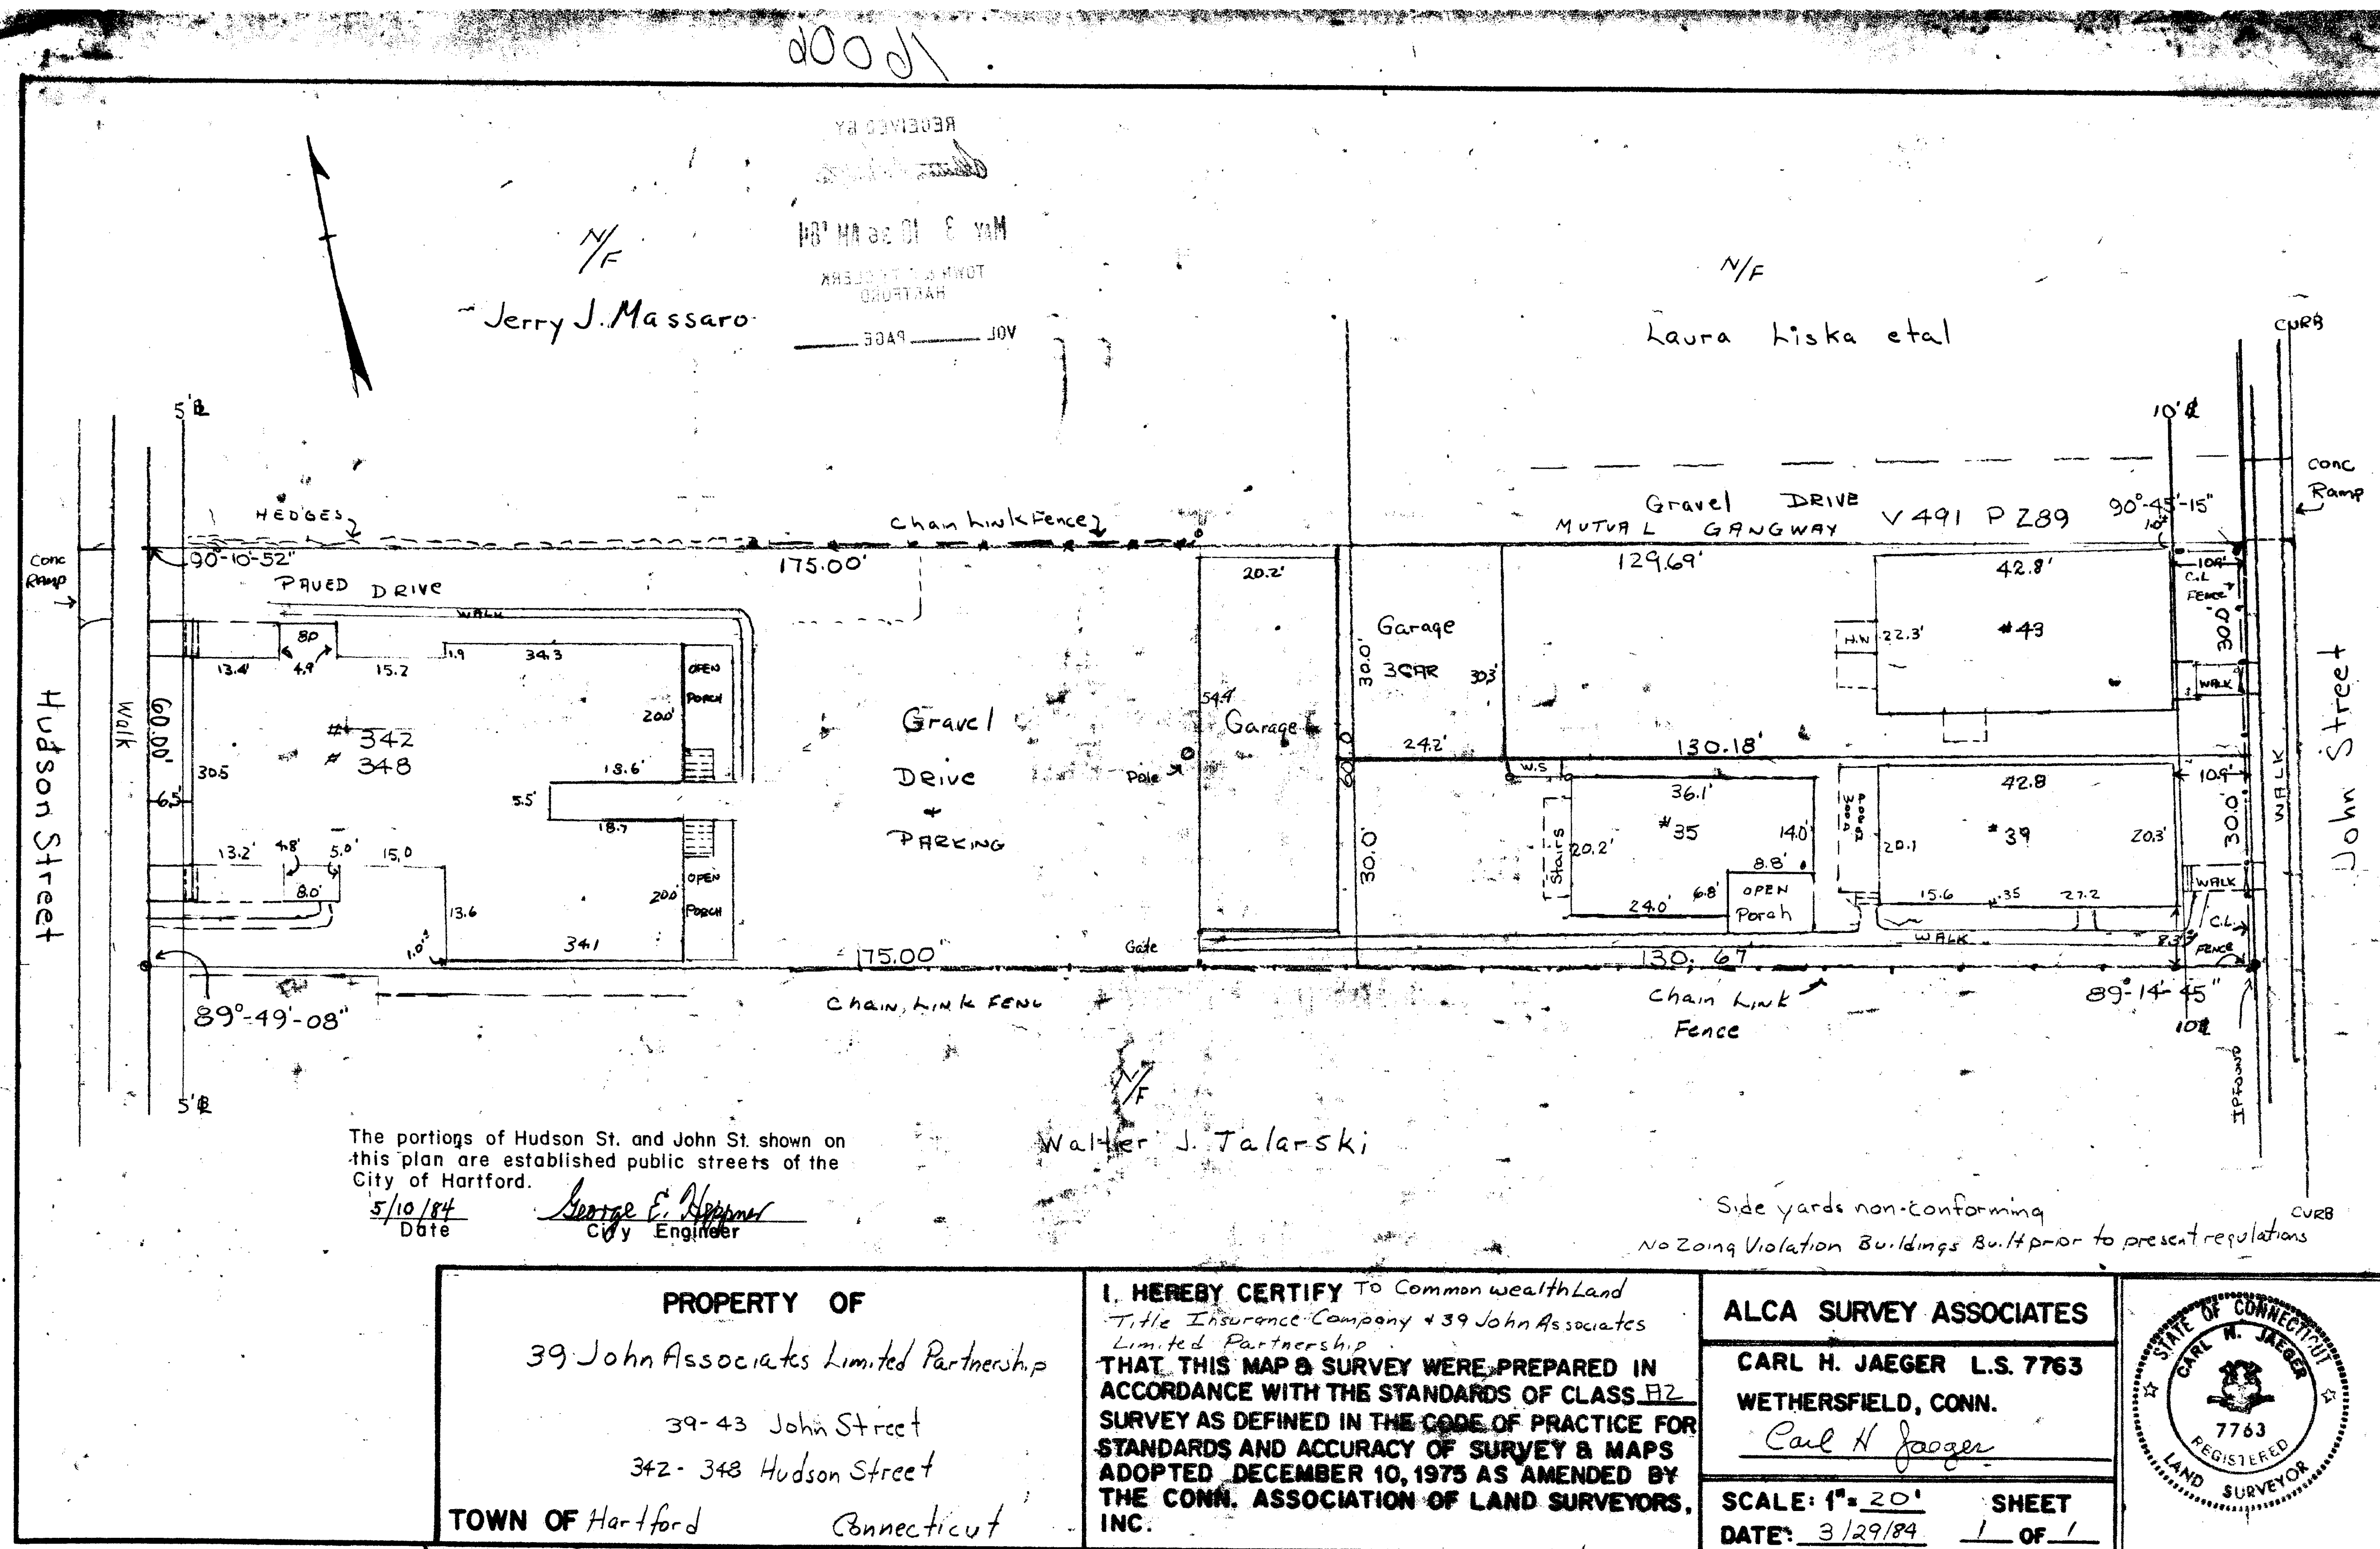

PLAN SIZE: 12" x 18"

