


1354

1 3 5 4 - 2

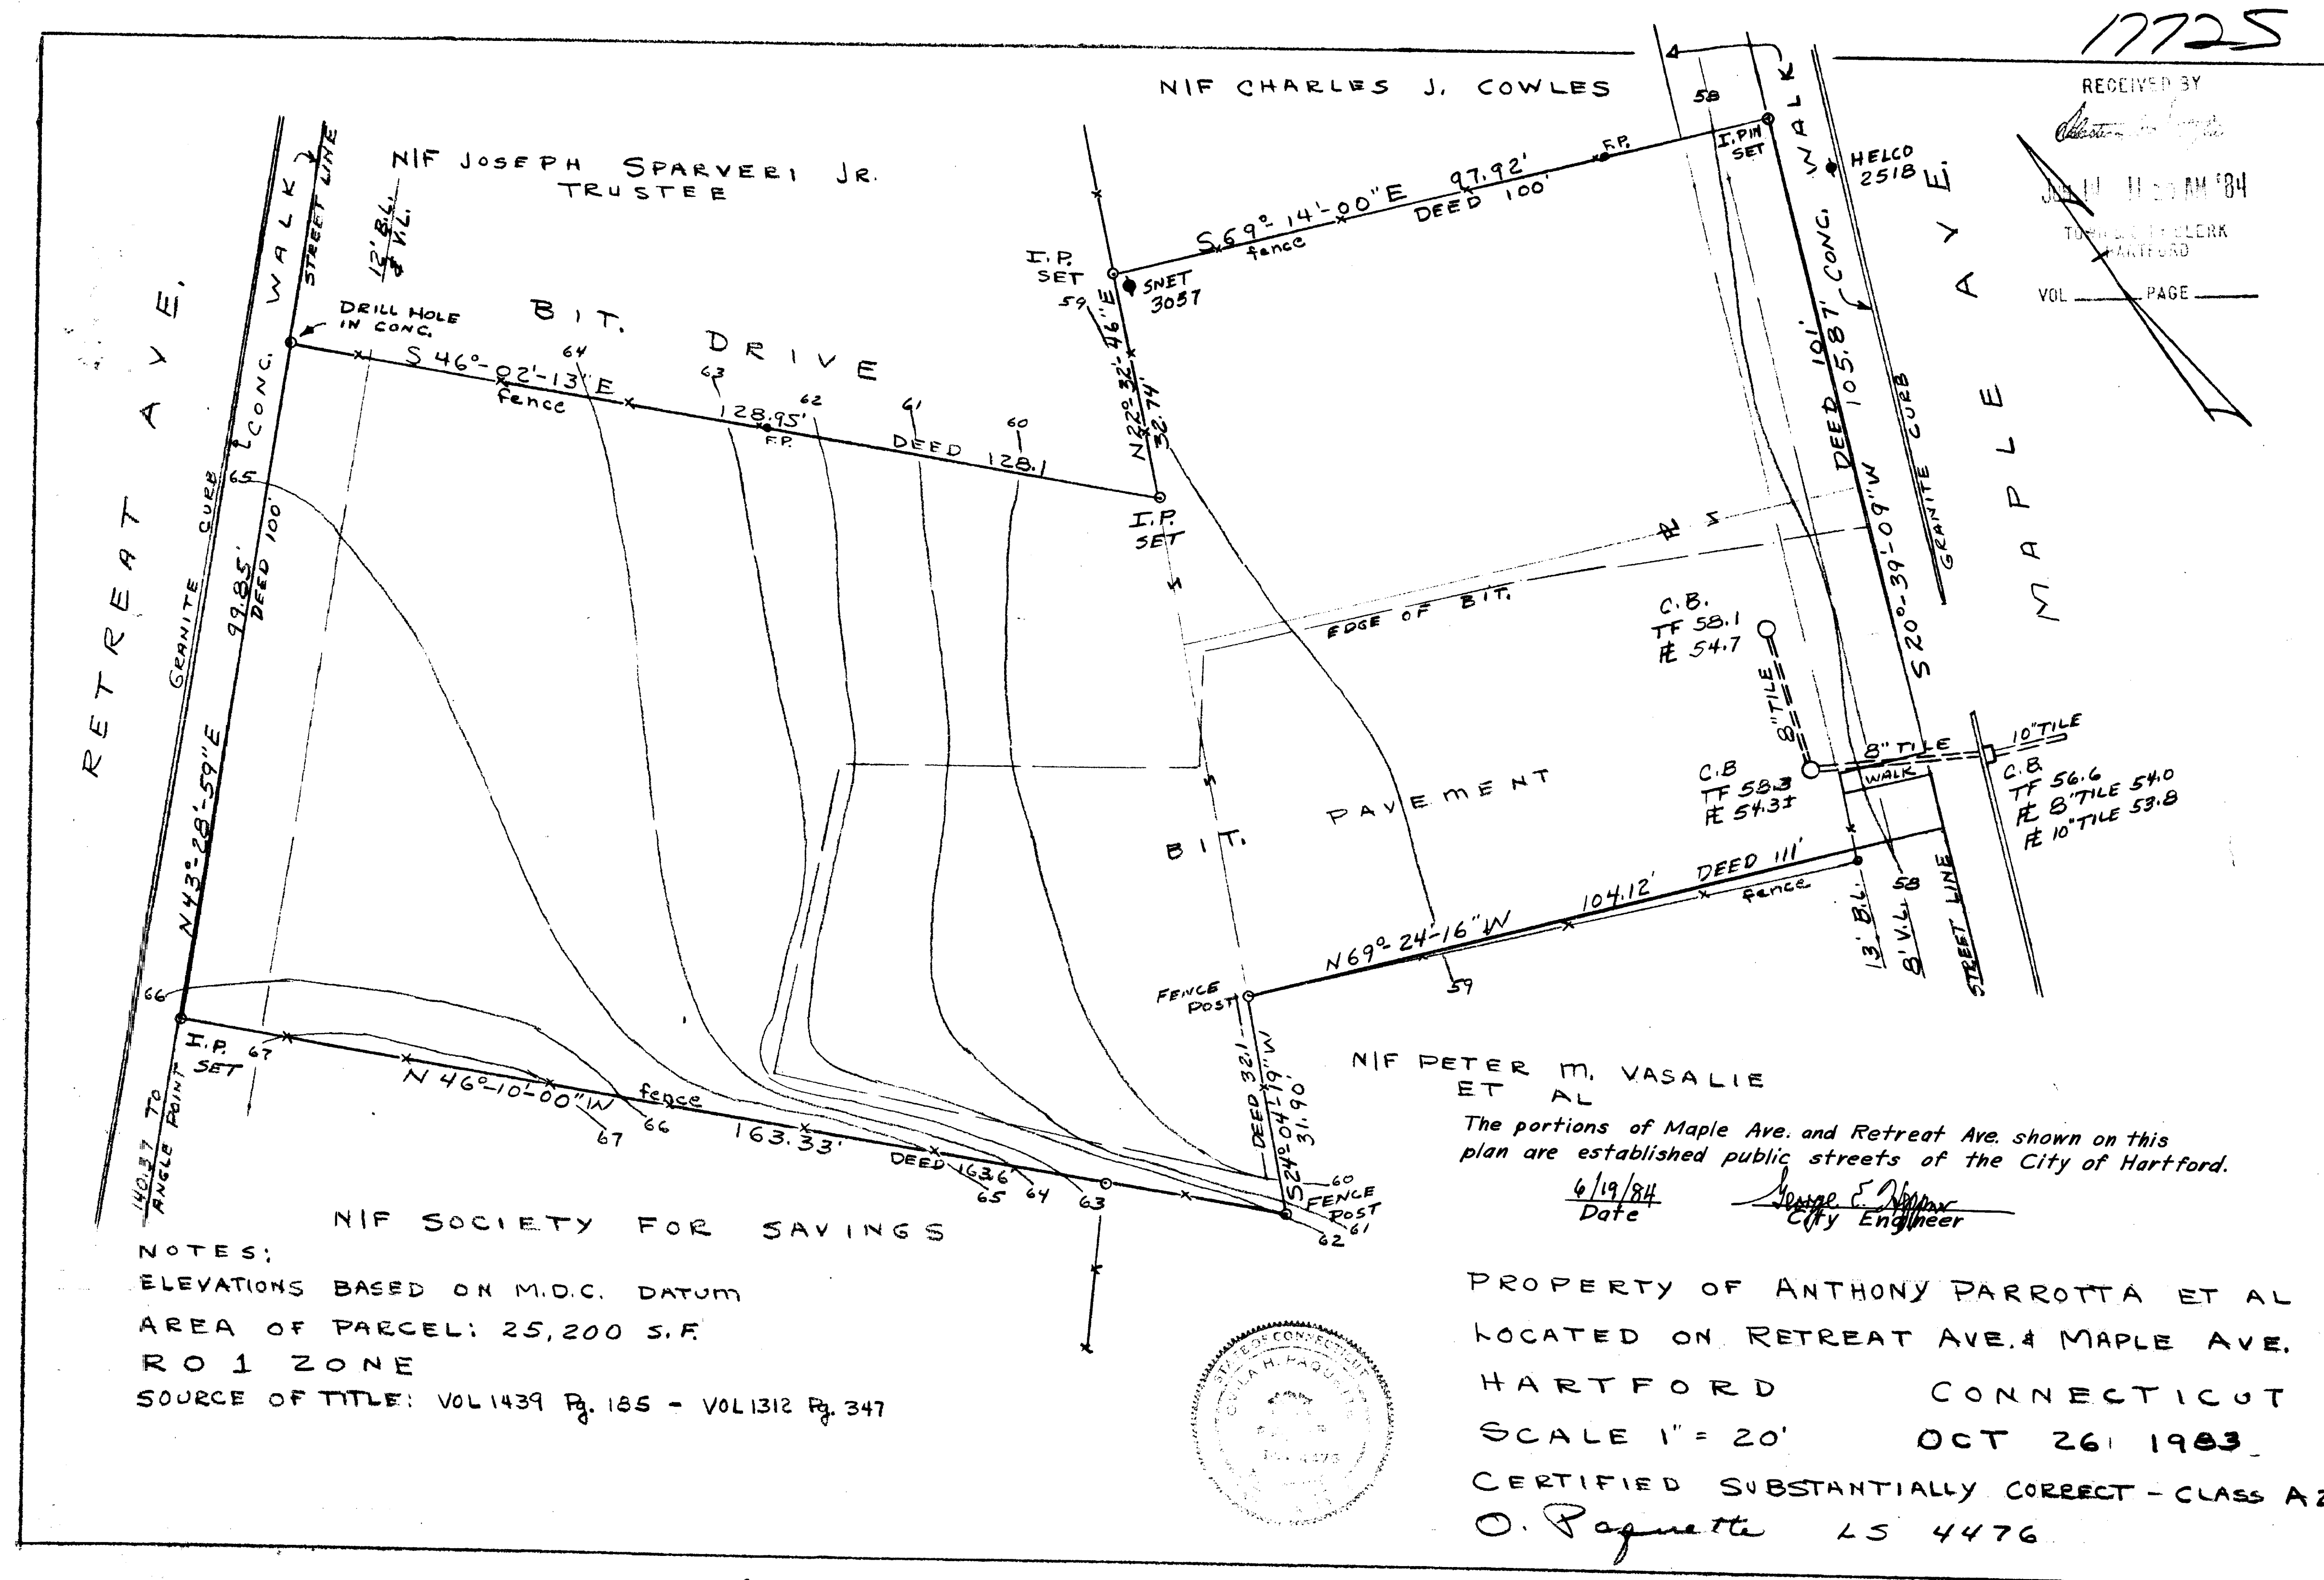

1354