


1955

1355-1

17747  
RECEIVED BY  
JUN 14 4 14 PM '84  
TOWN CLERK  
HARTFORD  
VOL PAGE

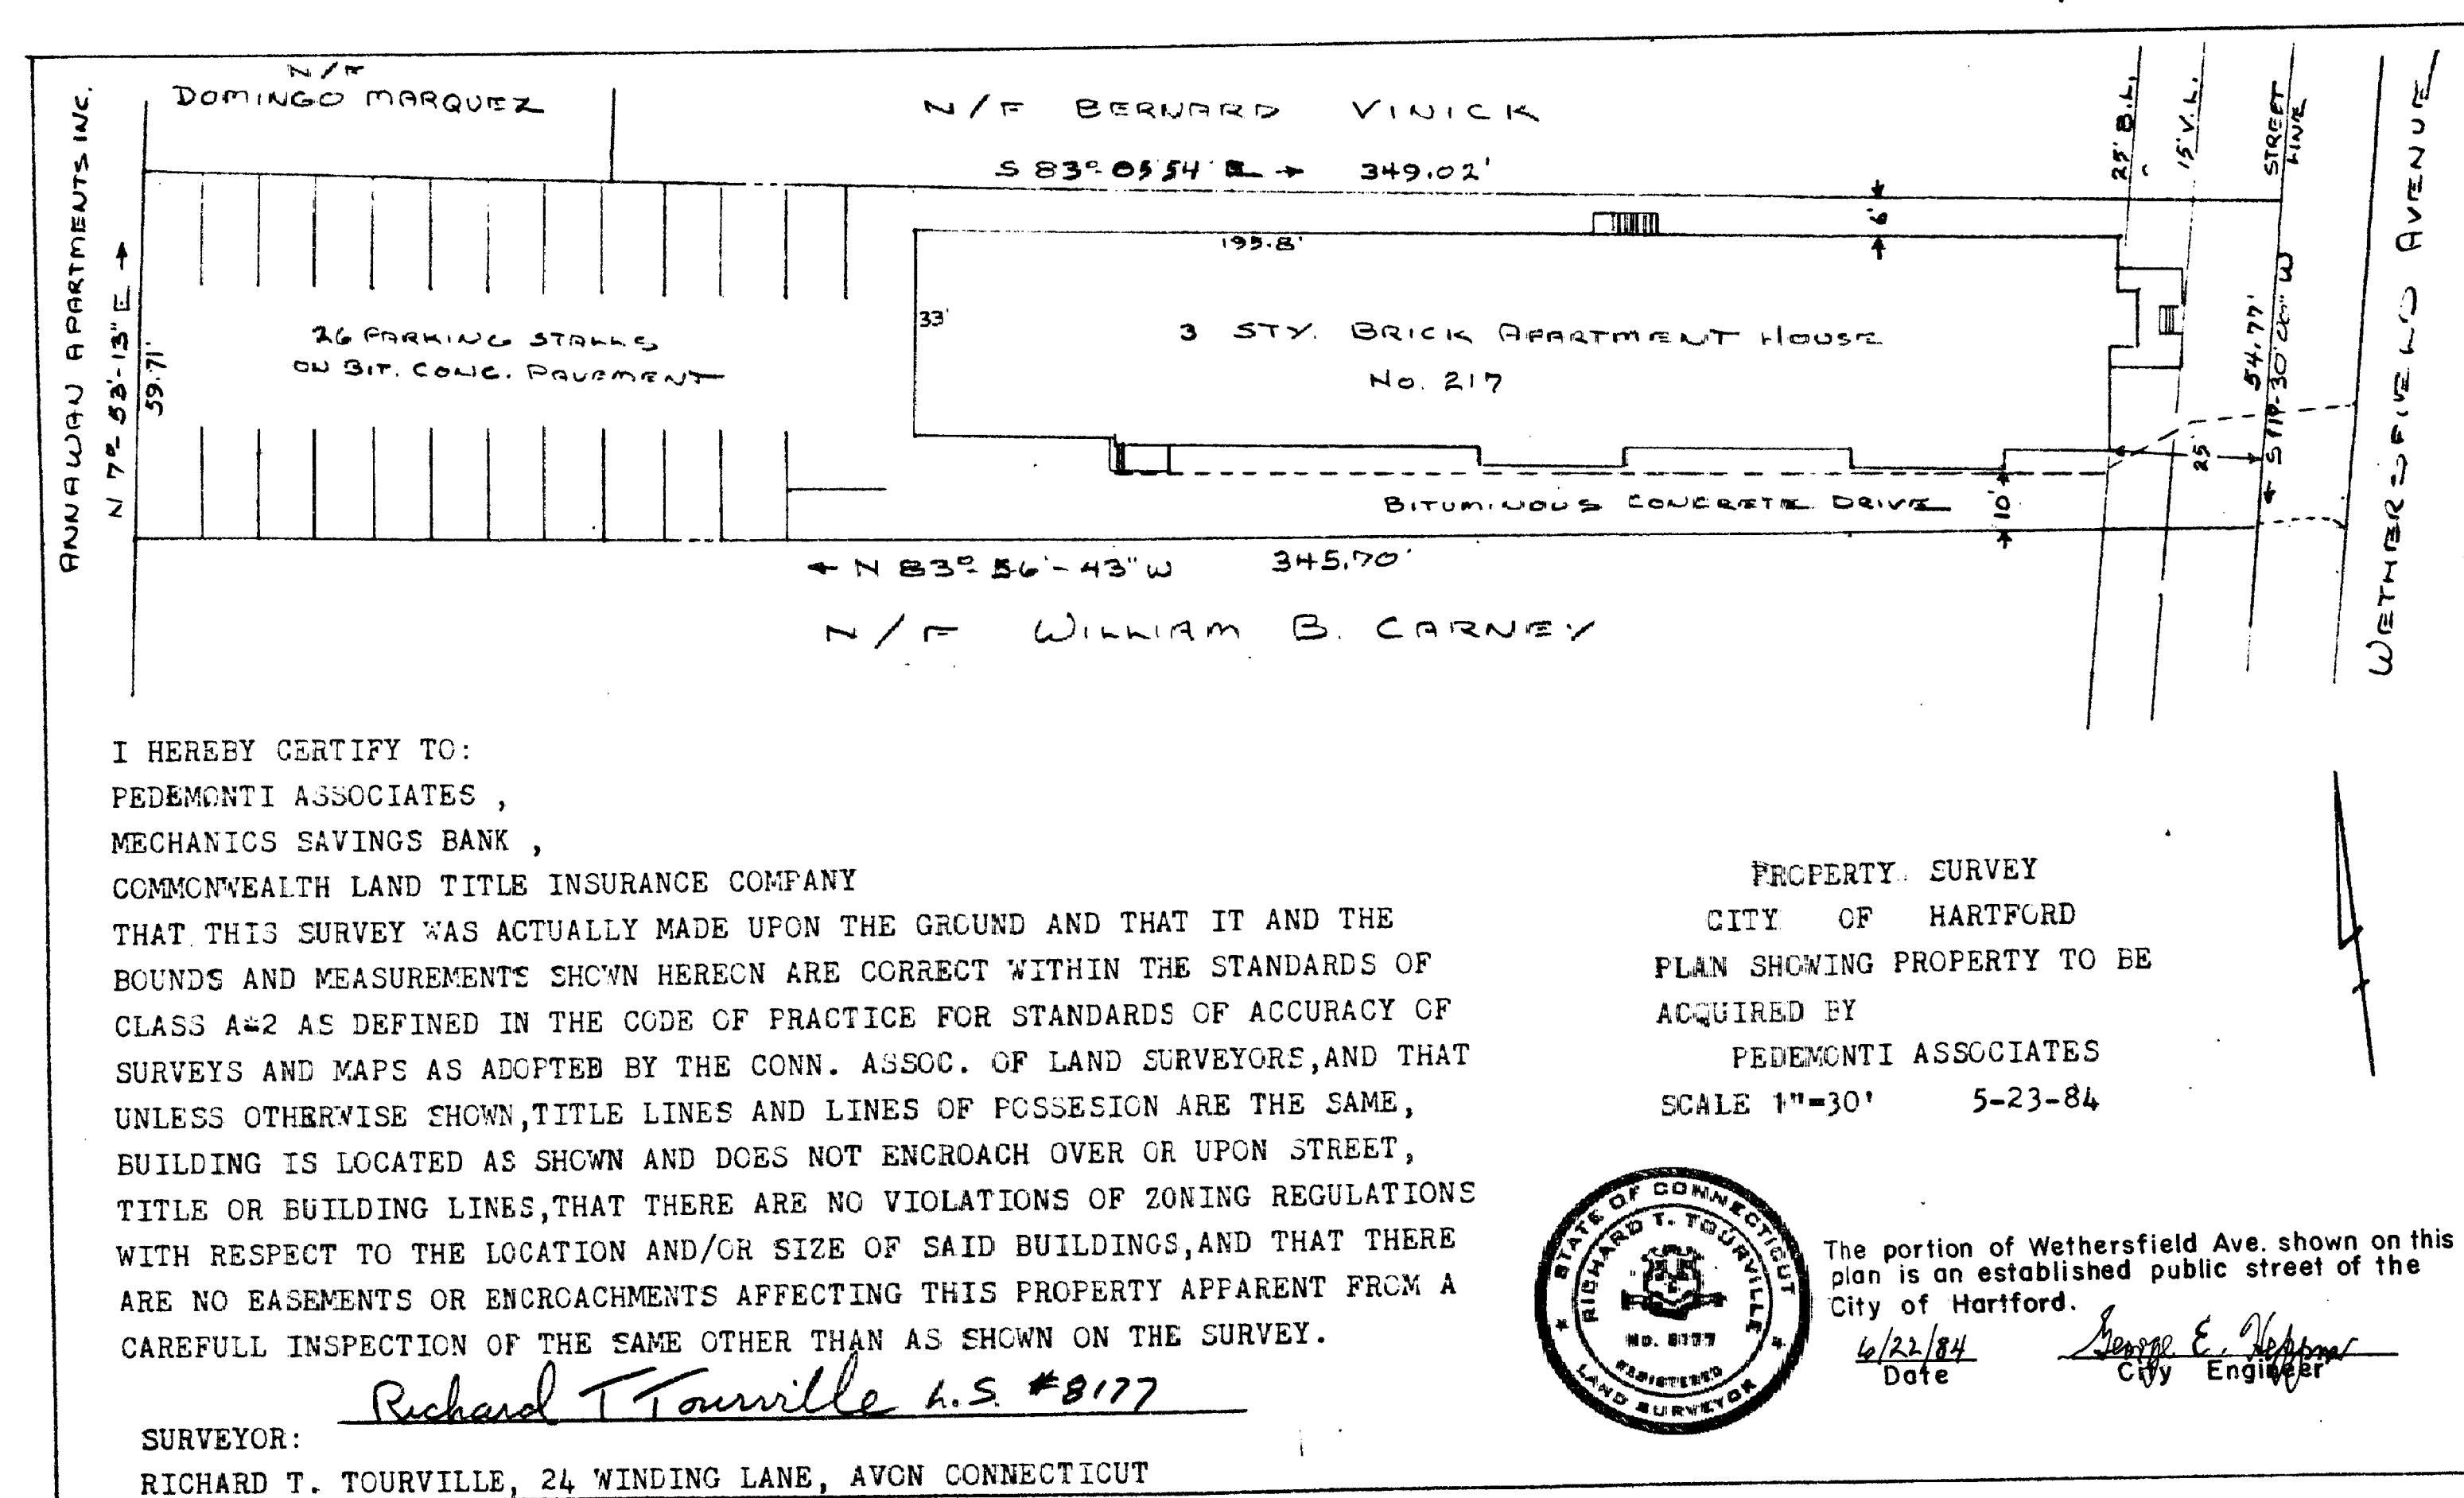

1355 17

