


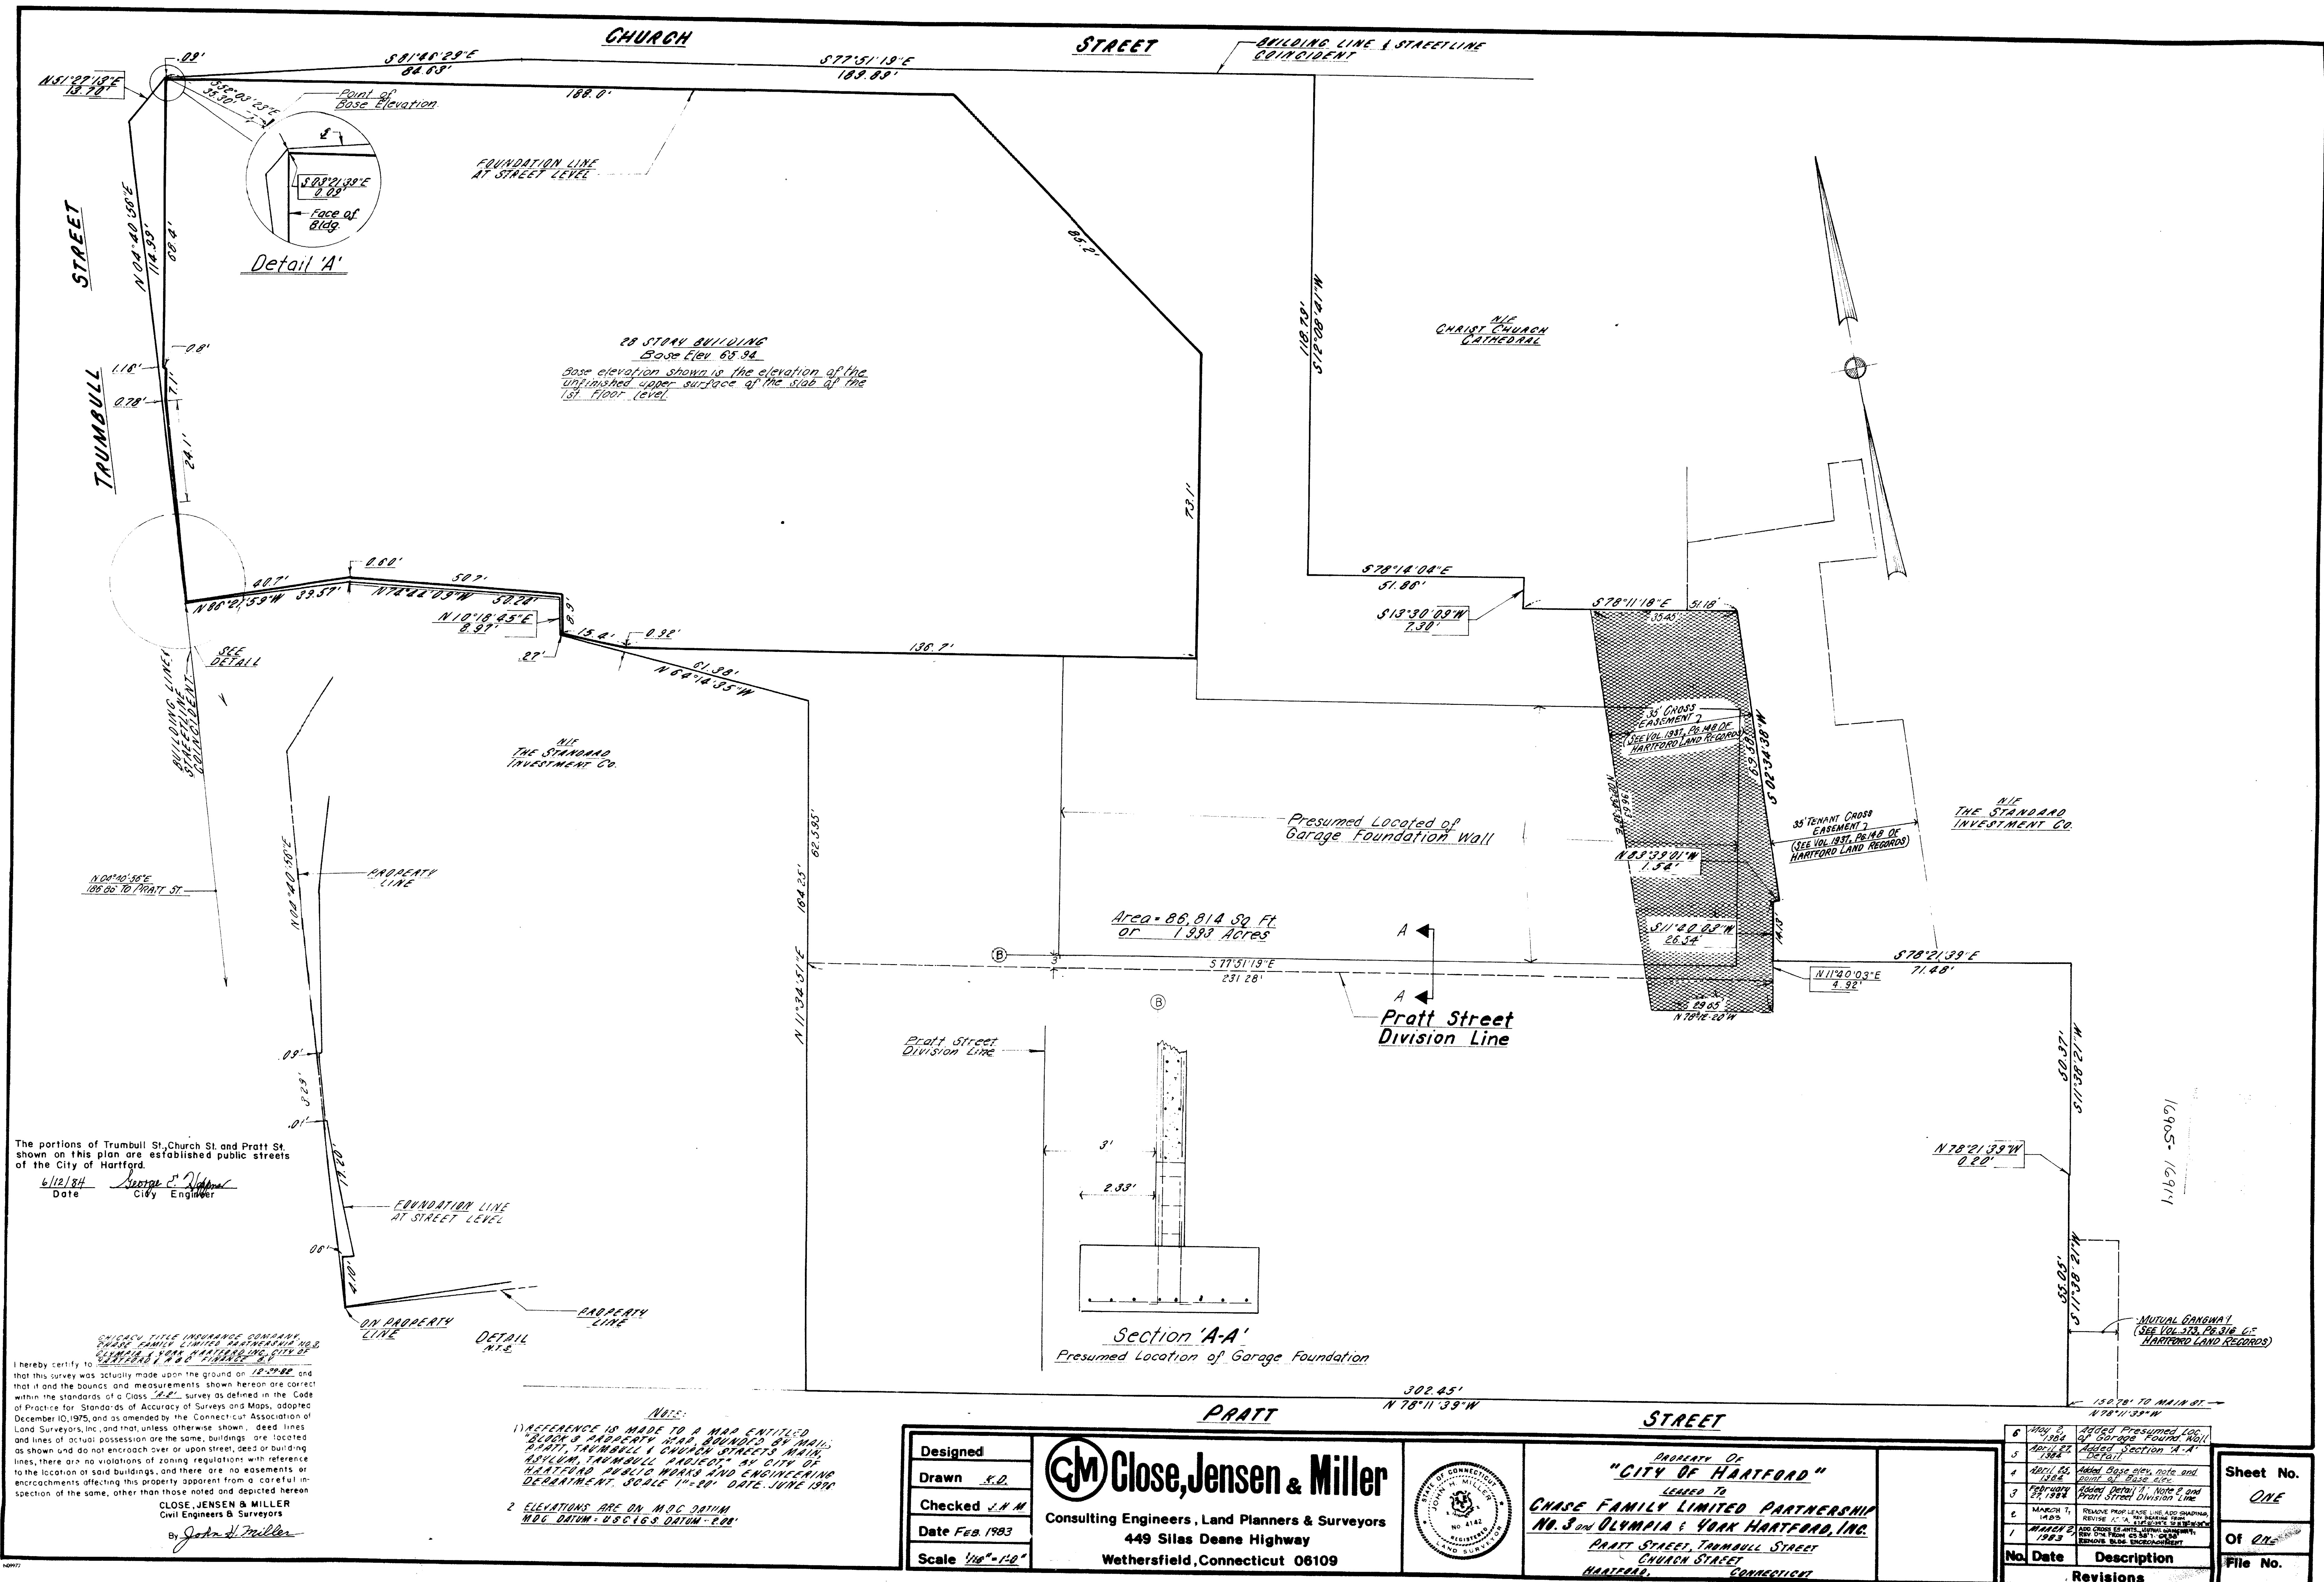

1358

