


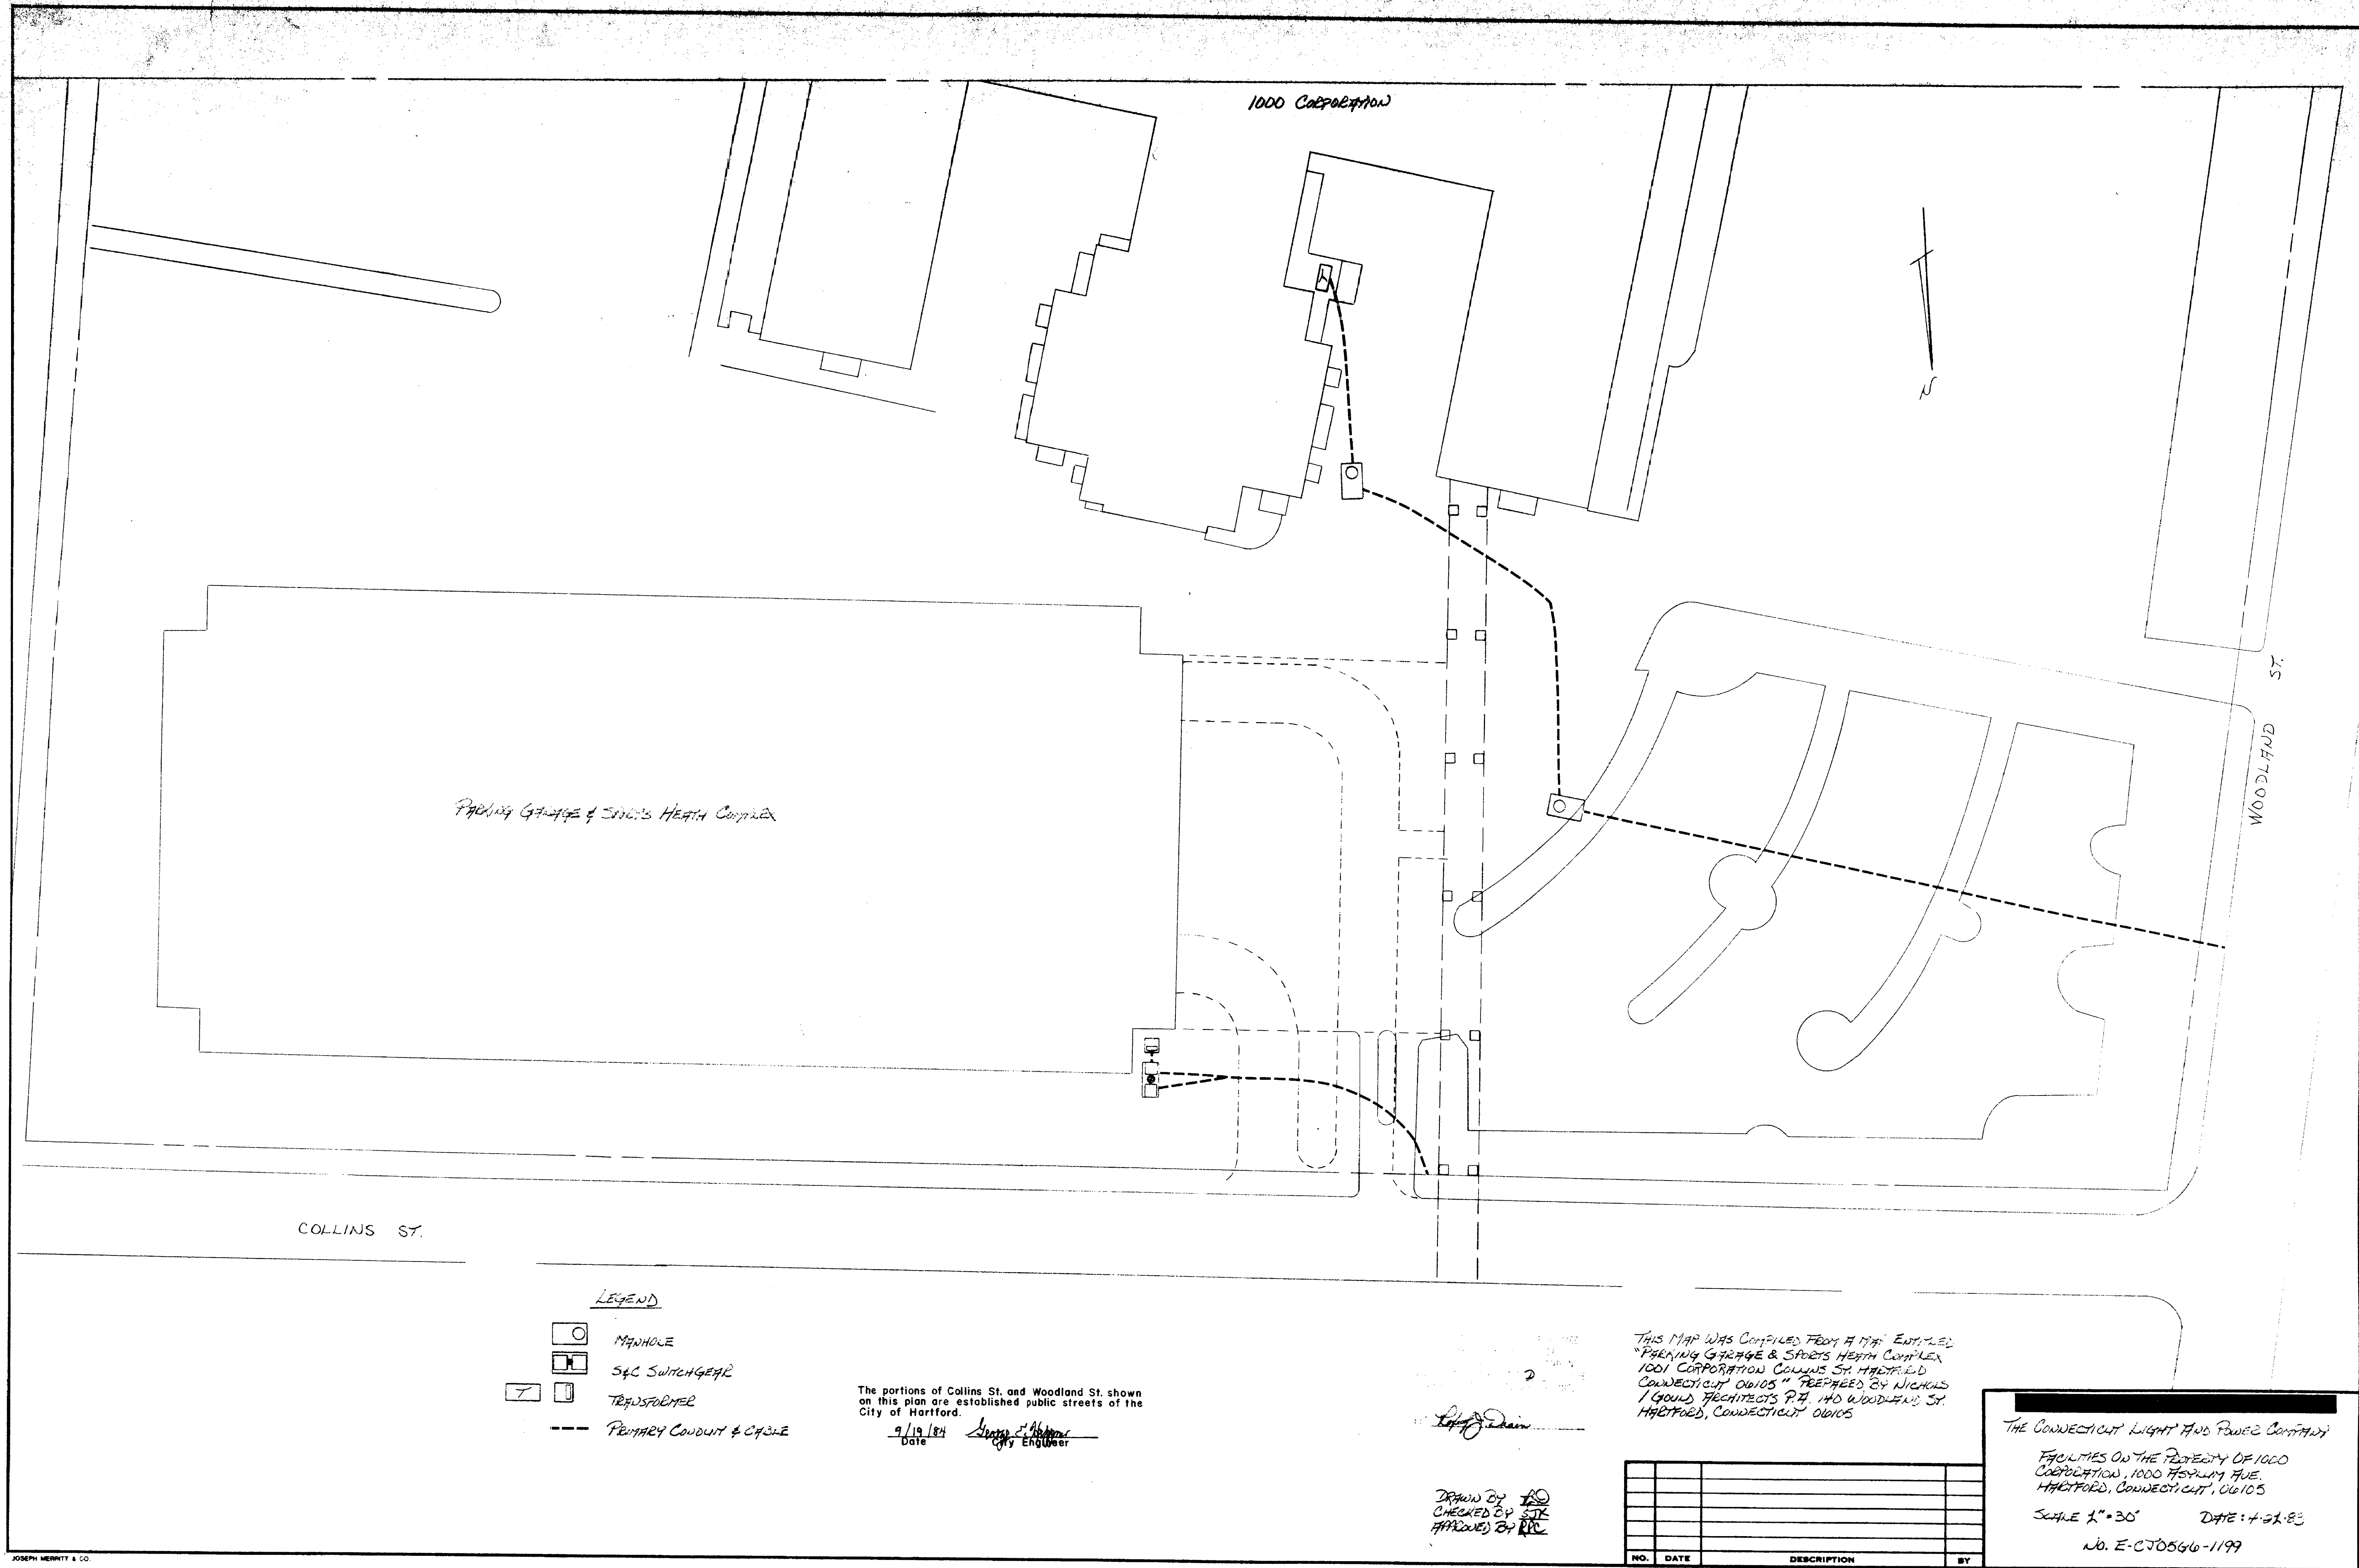

SEP 17 2 19 PM '84
TOWN OF HARTFORD
VBL PAGE