


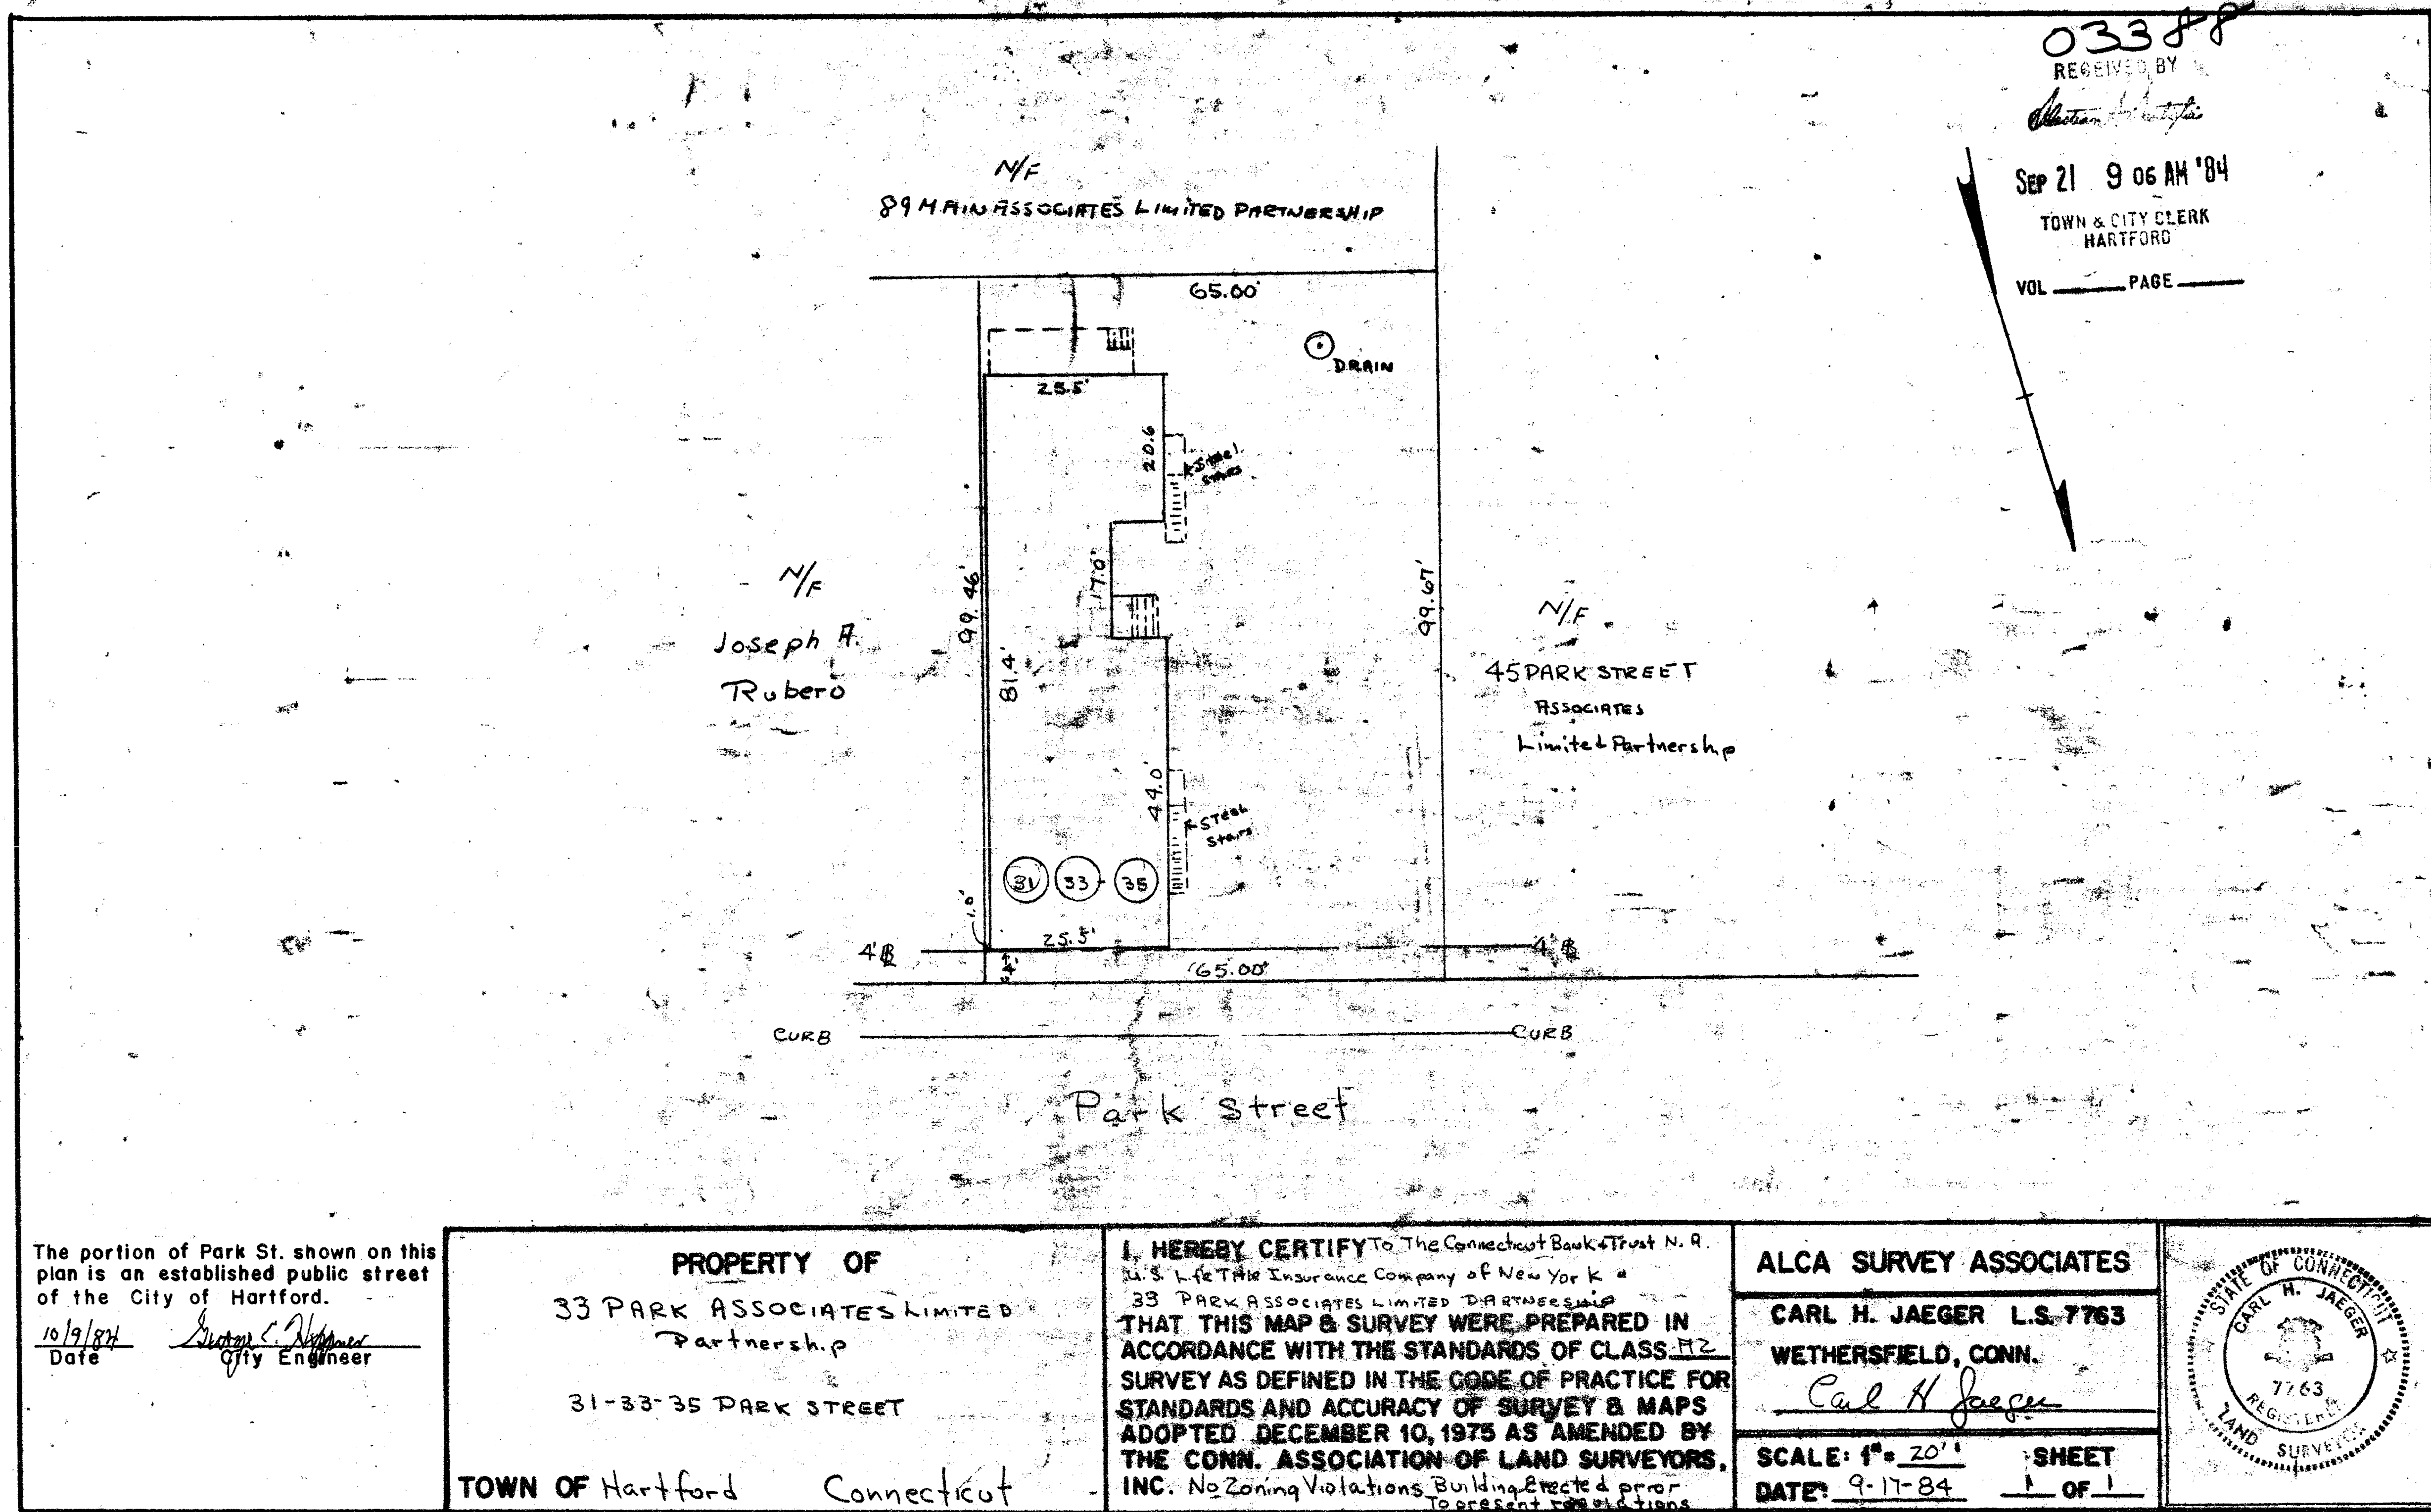

1373

30

