


EAST FILE CORP. IRVING, CA
1374

1374-2

525

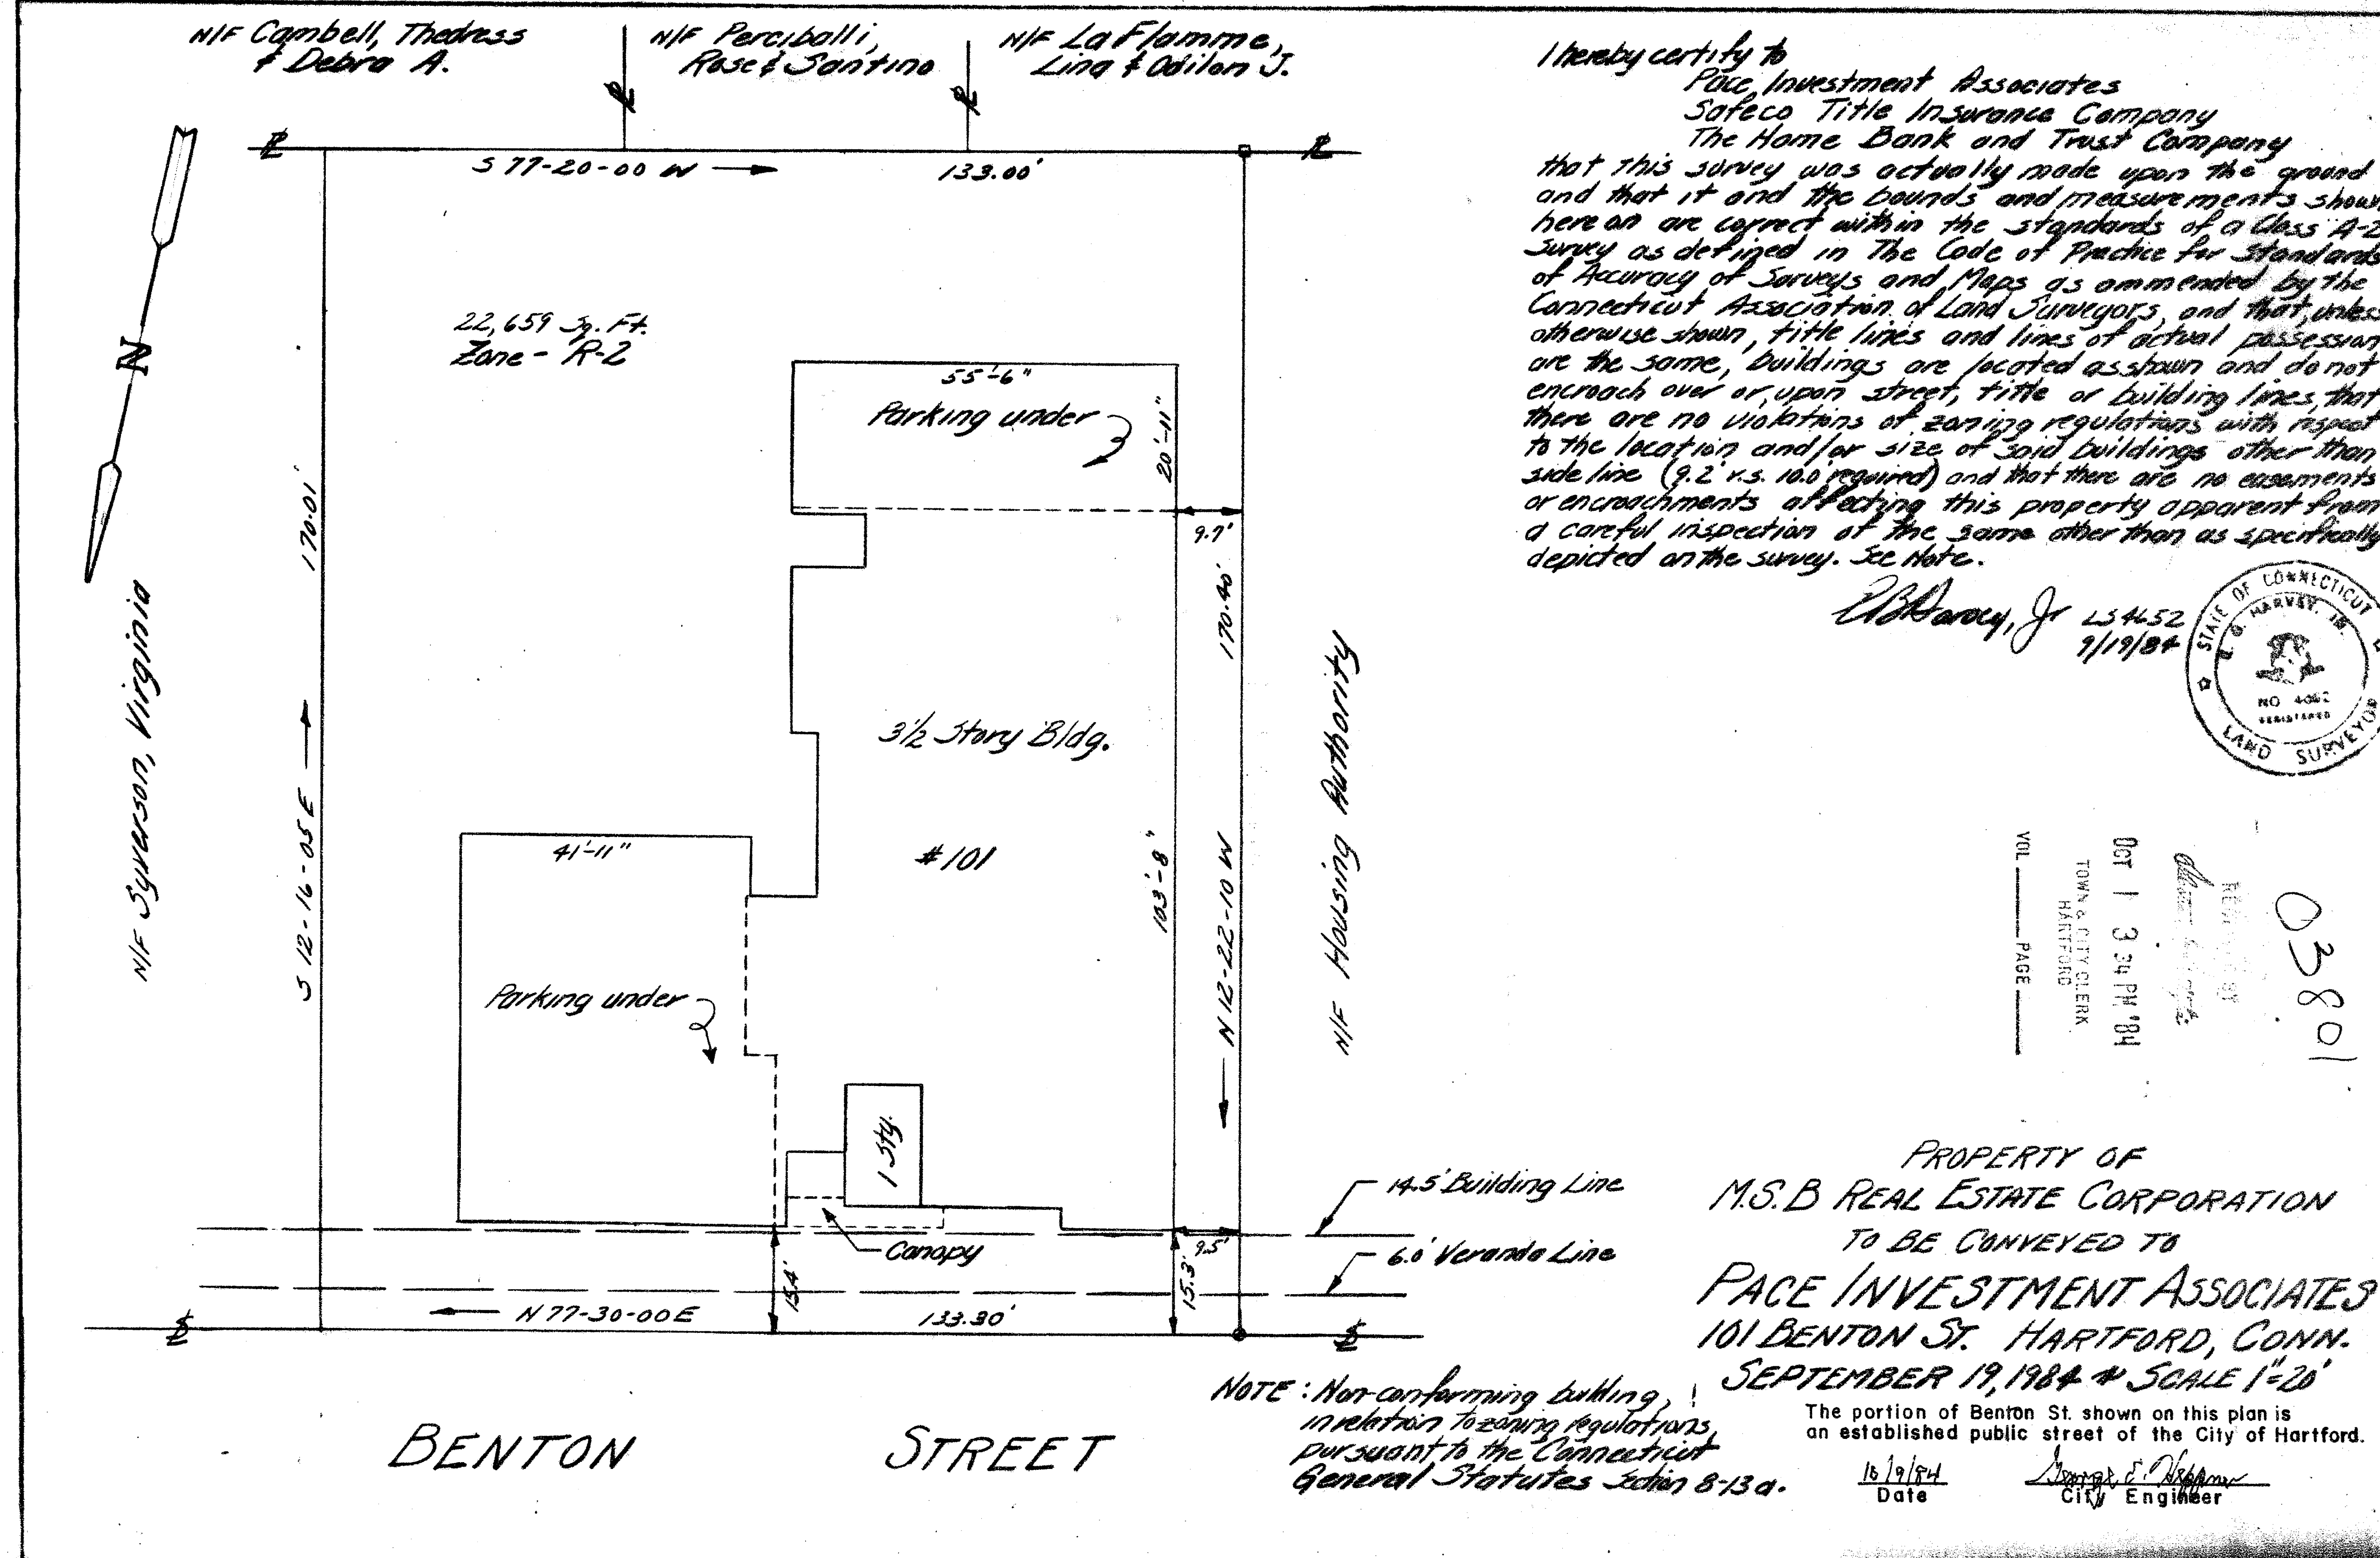

1374

34

