


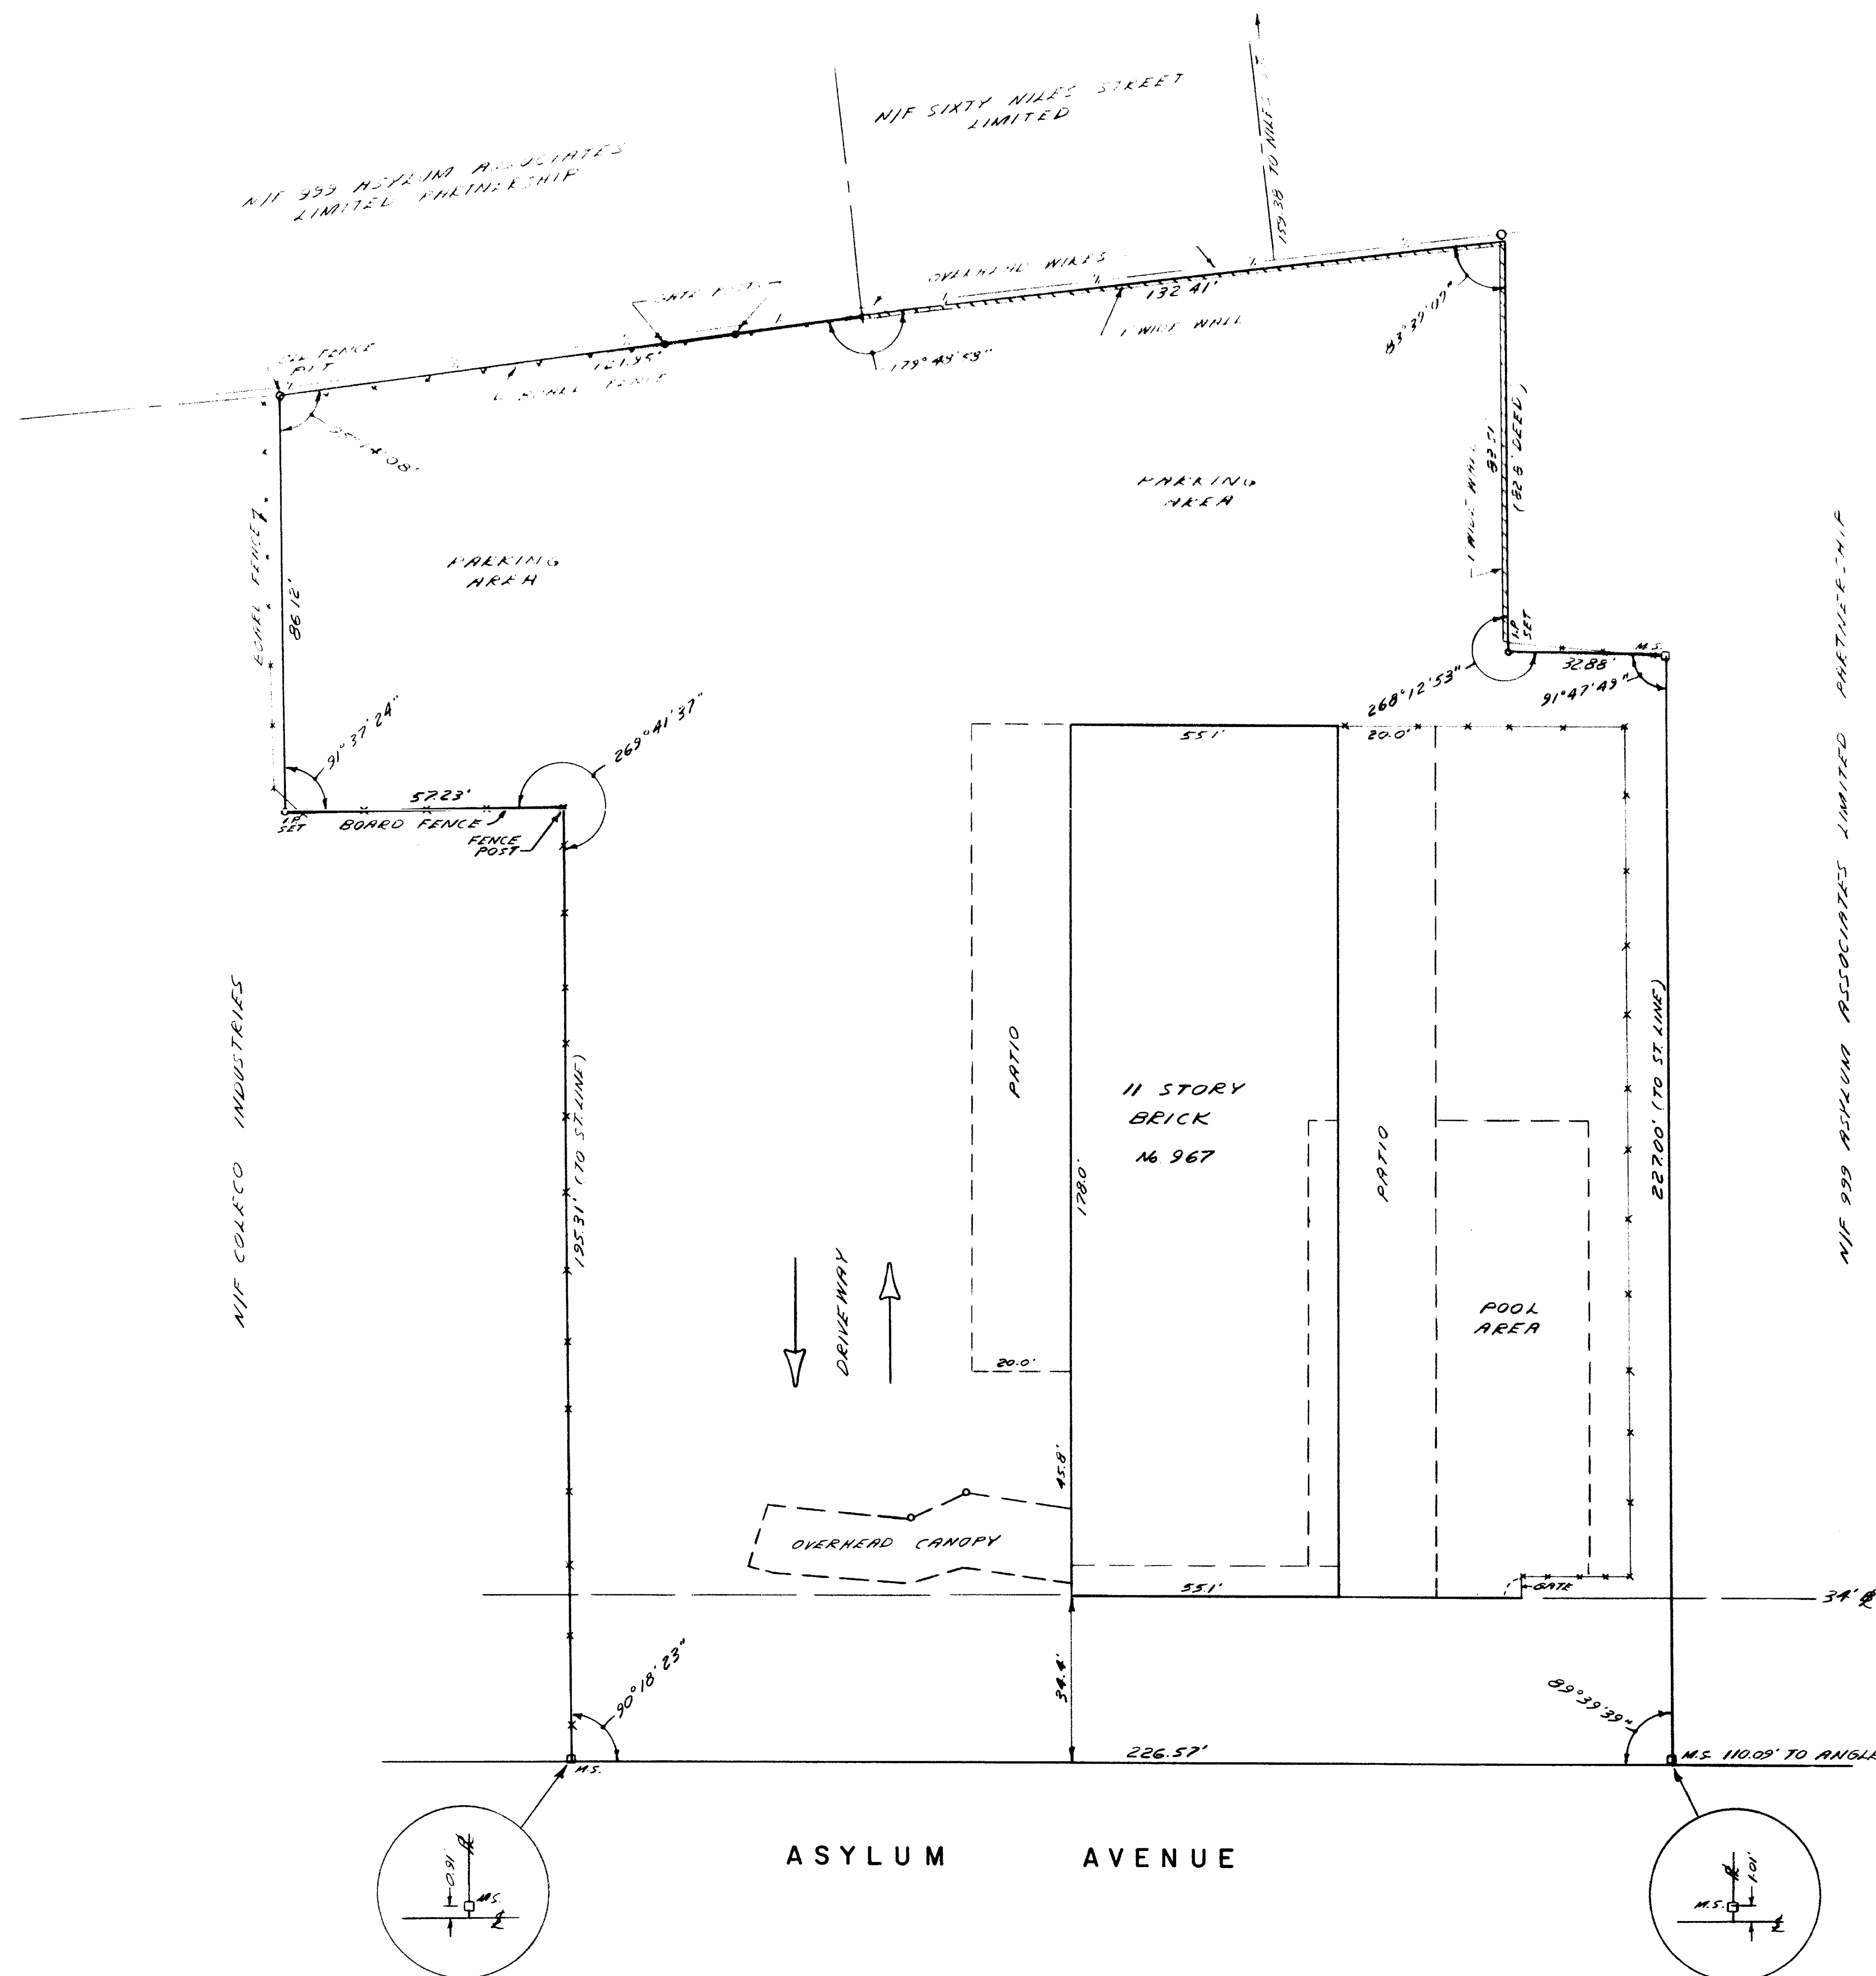





DRIVEWAY

OVERHEAD CANOPY

11 STORY
BRICK

PATIO

PATIO

POOL AREA

ASYLUM AVENUE

The portion of Asylum Ave. shown on this plan is an established public street of the City of Hartford.

10/1/84 Date
Surveyor's Name
City Engineer

- NOTES:
1. ZONE 20-1
 2. LOT AREA 1.62 ACRES
 3. MAP REF.

I HEREBY CERTIFY THAT THIS MAP AND SURVEY WERE PREPARED IN ACCORDANCE WITH THE STANDARDS OF A CLASS A-2 SURVEY AS DEFINED IN THE CODE OF PRACTICE FOR STANDARDS OF ACCURACY OF SURVEYS AND MAPS, ADOPTED DECEMBER 10, 1975 AS AMENDED BY THE CONNECTICUT ASSOCIATION OF LAND SURVEYORS, INC.

Surveyor's Name
DATE
REGISTRATION NO.

LAWYERS TITLE INSURANCE CO. #
I HEREBY CERTIFY TO CONNECTICUT NATIONAL BANK THAT THIS SURVEY WAS ACTUALLY MADE UPON THE GROUND ON 4/1/84 AND THAT IT AND THE BOUNDS AND MEASUREMENTS SHOWN HEREON ARE CORRECT WITHIN THE STANDARDS OF CLASS A-2 AS DEFINED IN THE CODE OF PRACTICE FOR STANDARDS OF ACCURACY ADOPTED BY THE CONN ASSOCIATION OF LAND SURVEYORS AND THAT UNLESS OTHERWISE SHOWN, TITLE LINES AND LINES OF ACTUAL POSSESSION ARE THE SAME. BUILDINGS ARE LOCATED AS SHOWN AND DO NOT ENCROACH OVER OR UPON STREET, TITLE OR BUILDING LINES. THERE ARE NO VIOLATIONS OF ZONING REGULATIONS WITH REFERENCE TO THE LOCATION OF SAID BUILDINGS. AND THERE ARE NO EASEMENTS OR ENCROACHMENTS AFFECTING THIS PROPERTY APPARENT FROM A CAREFUL INSPECTION OF THE SAME.

HALLISEY & HERBERT CIVIL ENGINEERS & LAND SURVEYORS 1850 SILAS DEANE HIGHWAY, ROCKY HILL, CONNECTICUT		DRAWN: JD CHECKED: KH DATE: 4 APR. 84 SCALE: 1" = 20' SHEET: 1 OF 1
PROPERTY SURVEYED FOR EDUCATIONAL APARTMENTS CORPORATION 967 ASYLUM AVENUE HARTFORD, CONNECTICUT		SEAL OF THE STATE OF CONNECTICUT LAND SURVEYORS NO. 8408 REGISTERED
JOB NO. 743	REVISIONS	

1377