


1381

1381-1

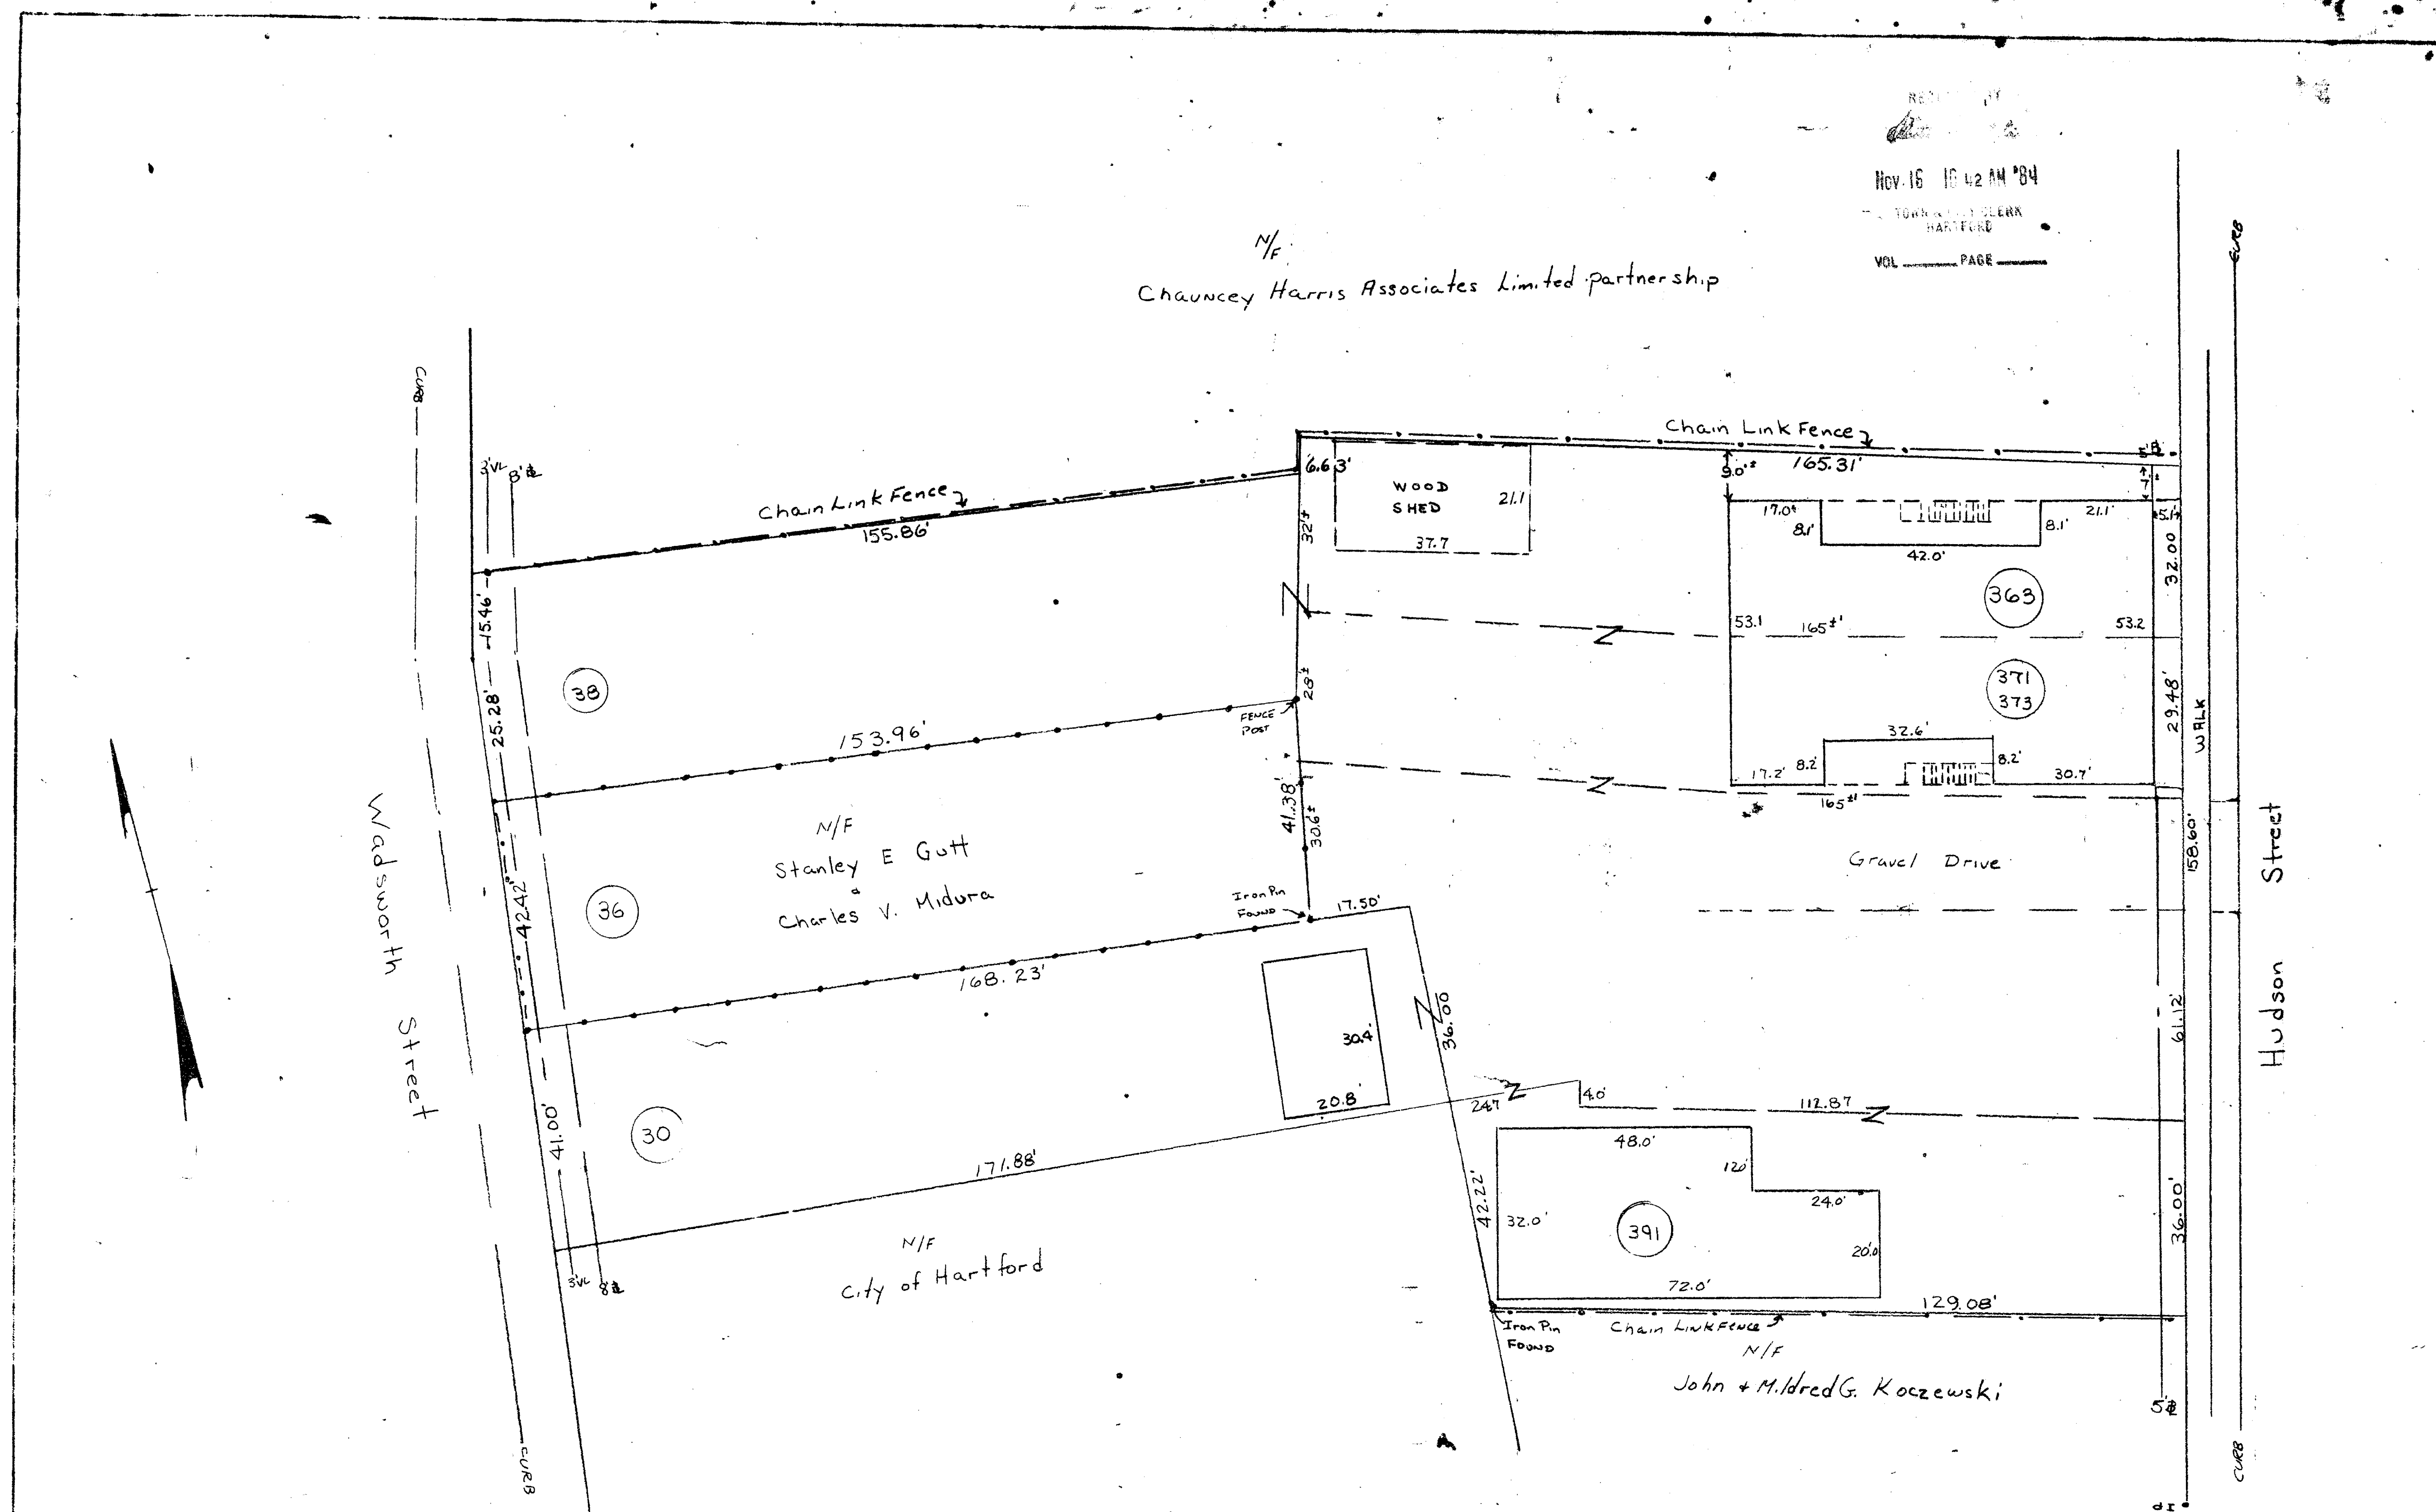


The portions of Wadsworth St. and Hudson St. shown on this plan are established public streets of the City of Hartford

11/21/84 Date
City Engineer

PROPERTY OF
363 Hudson Associates Limited Partnership
363, 371, 373, 391 HUDSON STREET
30, 38 Wadsworth Street
TOWN OF Hartford Connecticut

I HEREBY CERTIFY US LIFE Title Insurance Company of New York + 363 Hudson Associates Limited Partnership
THAT THIS MAP & SURVEY WERE PREPARED IN ACCORDANCE WITH THE STANDARDS OF CLASS B2 SURVEY AS DEFINED IN THE CODE OF PRACTICE FOR STANDARDS AND ACCURACY OF SURVEY & MAPS ADOPTED DECEMBER 10, 1975 AS AMENDED BY THE CONN. ASSOCIATION OF LAND SURVEYORS, INC. No Zoning Violations

ALCA SURVEY ASSOCIATES
CARL H. JAEGER L.S. 7763
WETHERSFIELD, CONN.
Carl H. Jaeger
SCALE: 1" = 20' SHEET
DATE: 11/10/84 OF 1

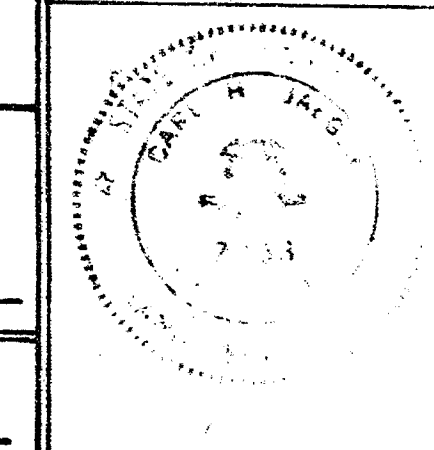

PLAN SIZE 18" x 24"

