

1384	EPN 34
------	--------

06756


RECEIVED BY
[Signature]
Dec 10 11 49 AM '84
TOWN & CITY CLERK
HARTFORD
VOL _____ PAGE _____

TO LAWYERS TITLE INSURANCE COMPANY
HOME BANK AND TRUST COMPANY
ASHMEAD-COLT HOUSE LIMITED PARTNERSHIP
I hereby certify that this survey and the bounds and
measurements shown hereon are substantially correct
that the lines shown hereon and the lines of actual
possession are the same that the only easements
as shown and do not represent any other easements
or building lines, except as shown on this plan. There
are no violations of zoning, or private restrictions
or other rules and regulations in respect to the
location of said building, and that there are no
assessments or encroachments affecting this property
than those shown and corrected hereon of the same date
ACCORDANCE WITH CLASS A-2 STANDARDS. PREPARED BY

Alfred E. Smith
Date 12/1/84
City Engineer

65 WETHERSFIELD AVENUE
HARTFORD, CONNECTICUT
SCALE 1 INCH = 20 FEET
OCT. 1984
ADDITIONS NOV. 1984

PETERSEN & HOFFMAN
LAND SURVEYORS

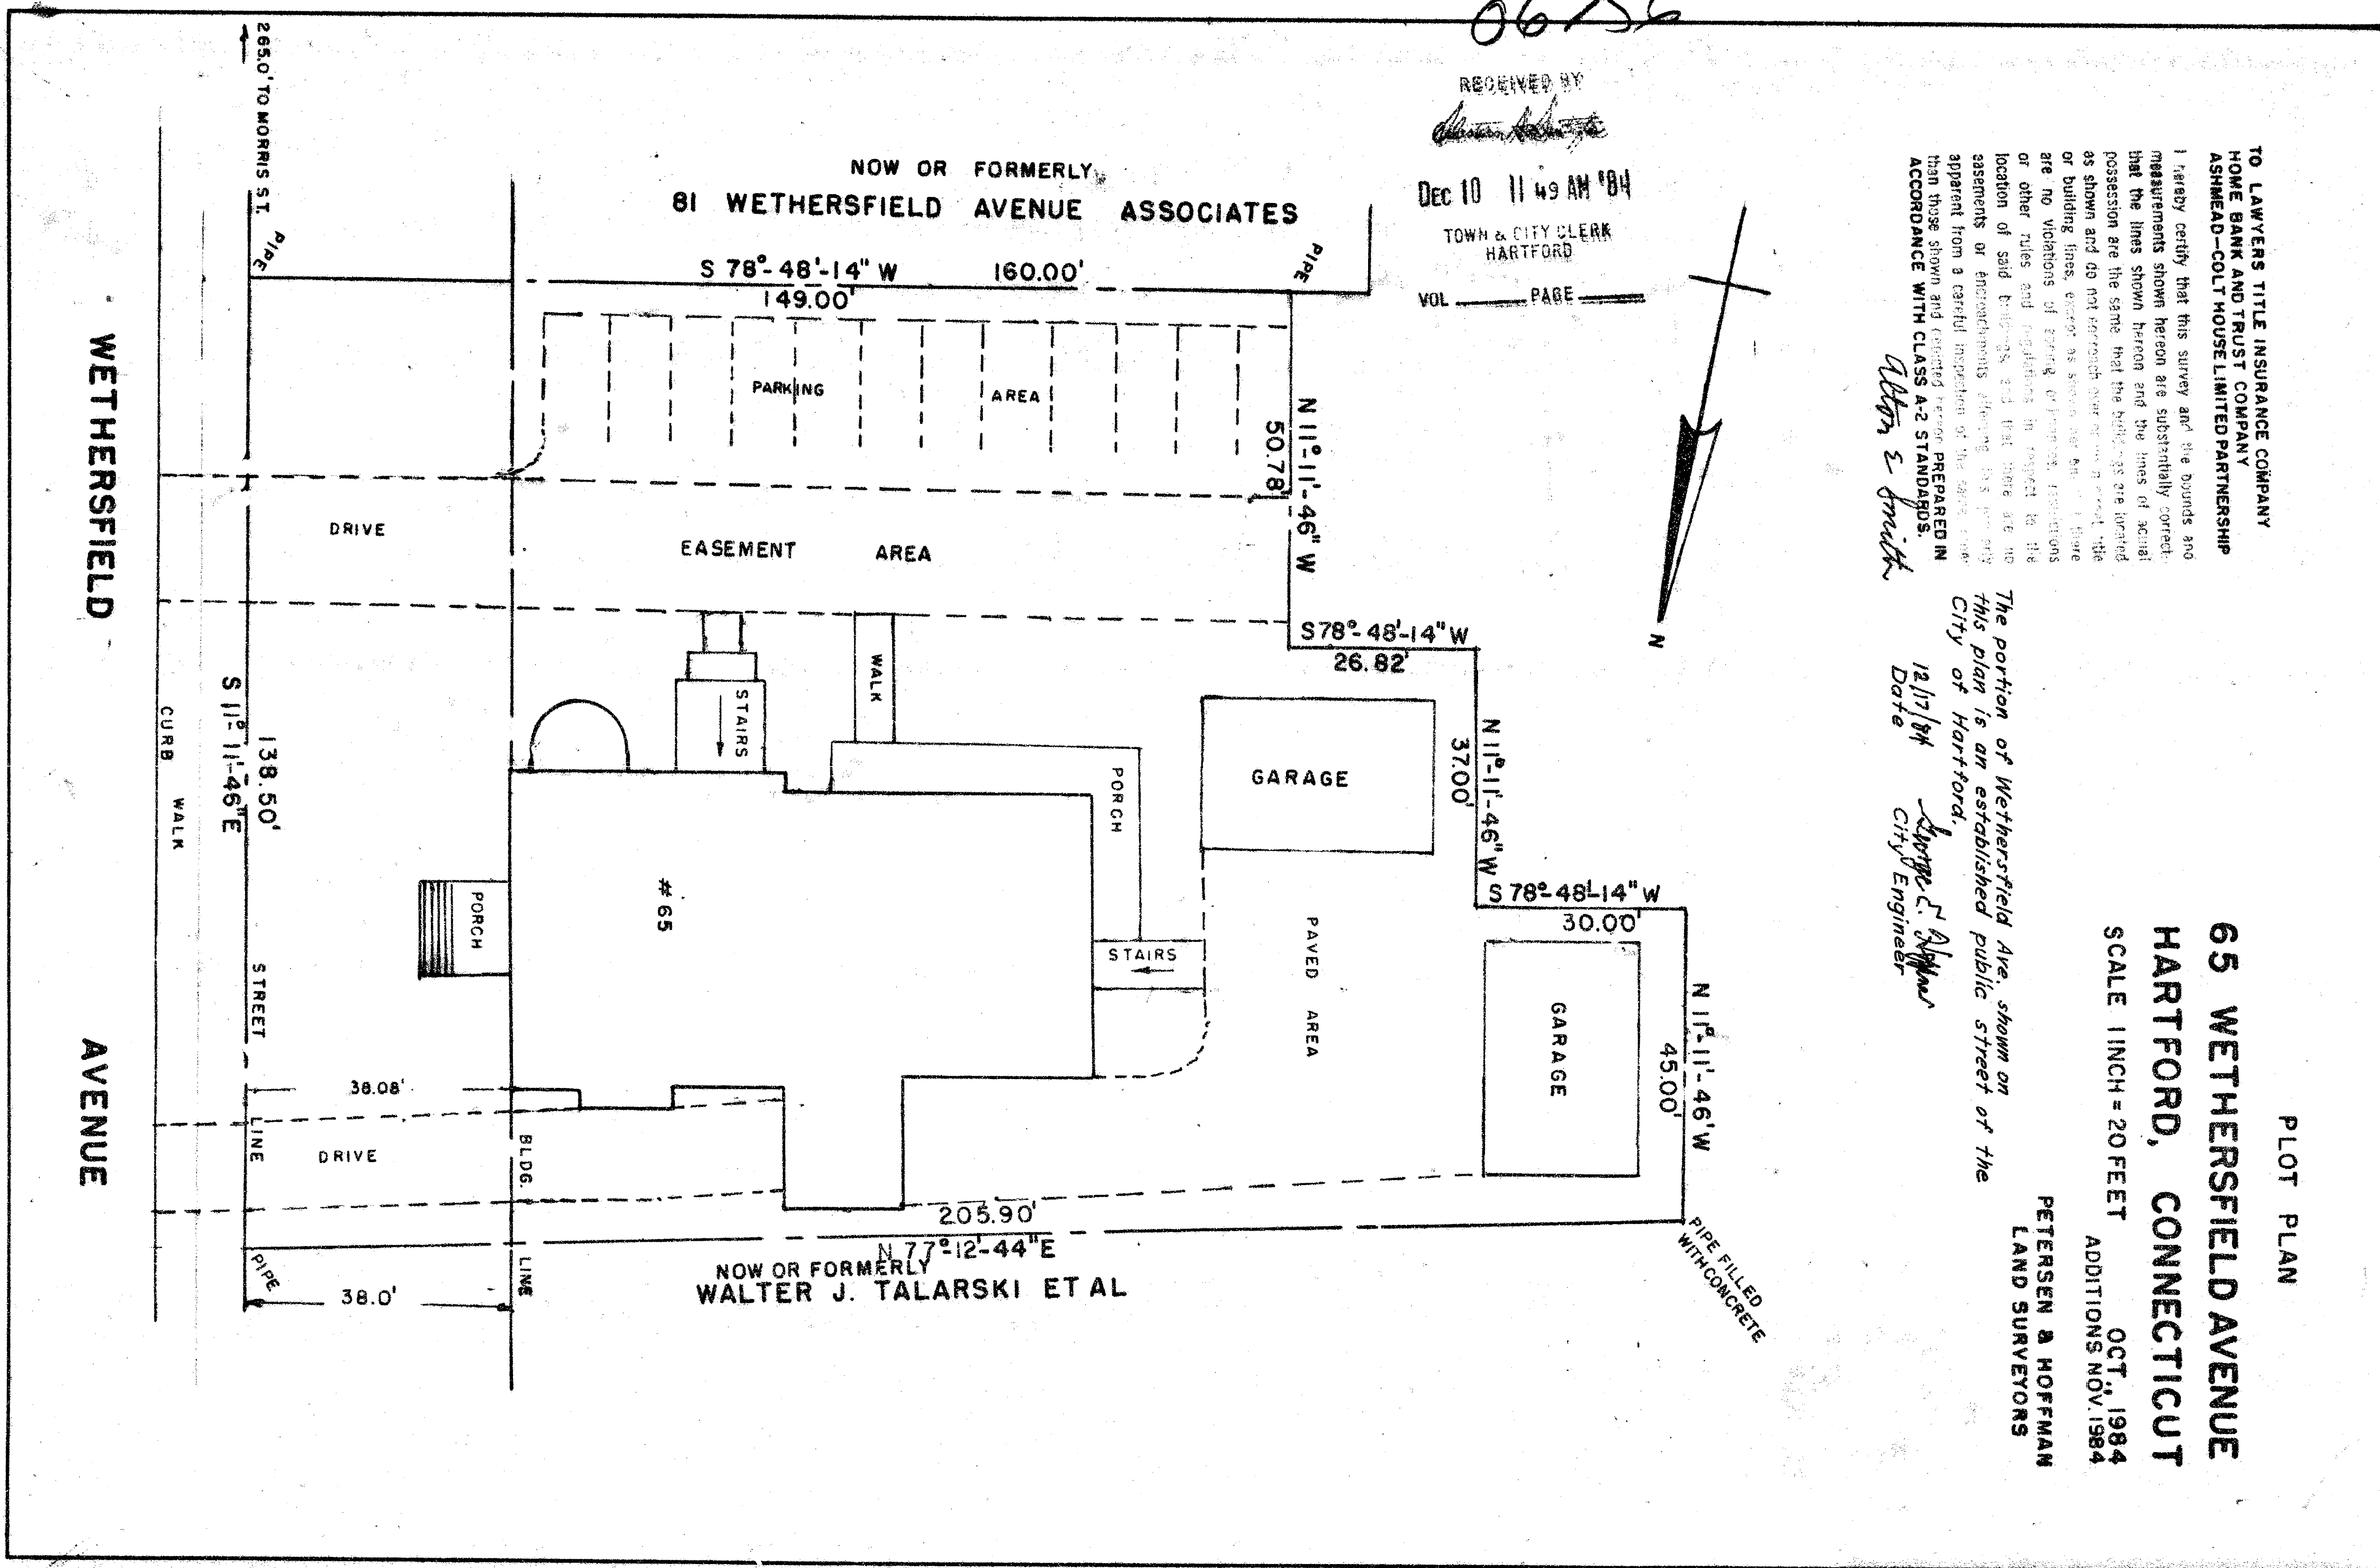

47

1384