


1384-1

Mr. Lithuanian Roman Catholic
Church of the Most Holy Family

RECEIVED BY
Dec 7 3 22 PM '84
TOWN & CITY CLERK
HARTFORD
VOL. PAGE

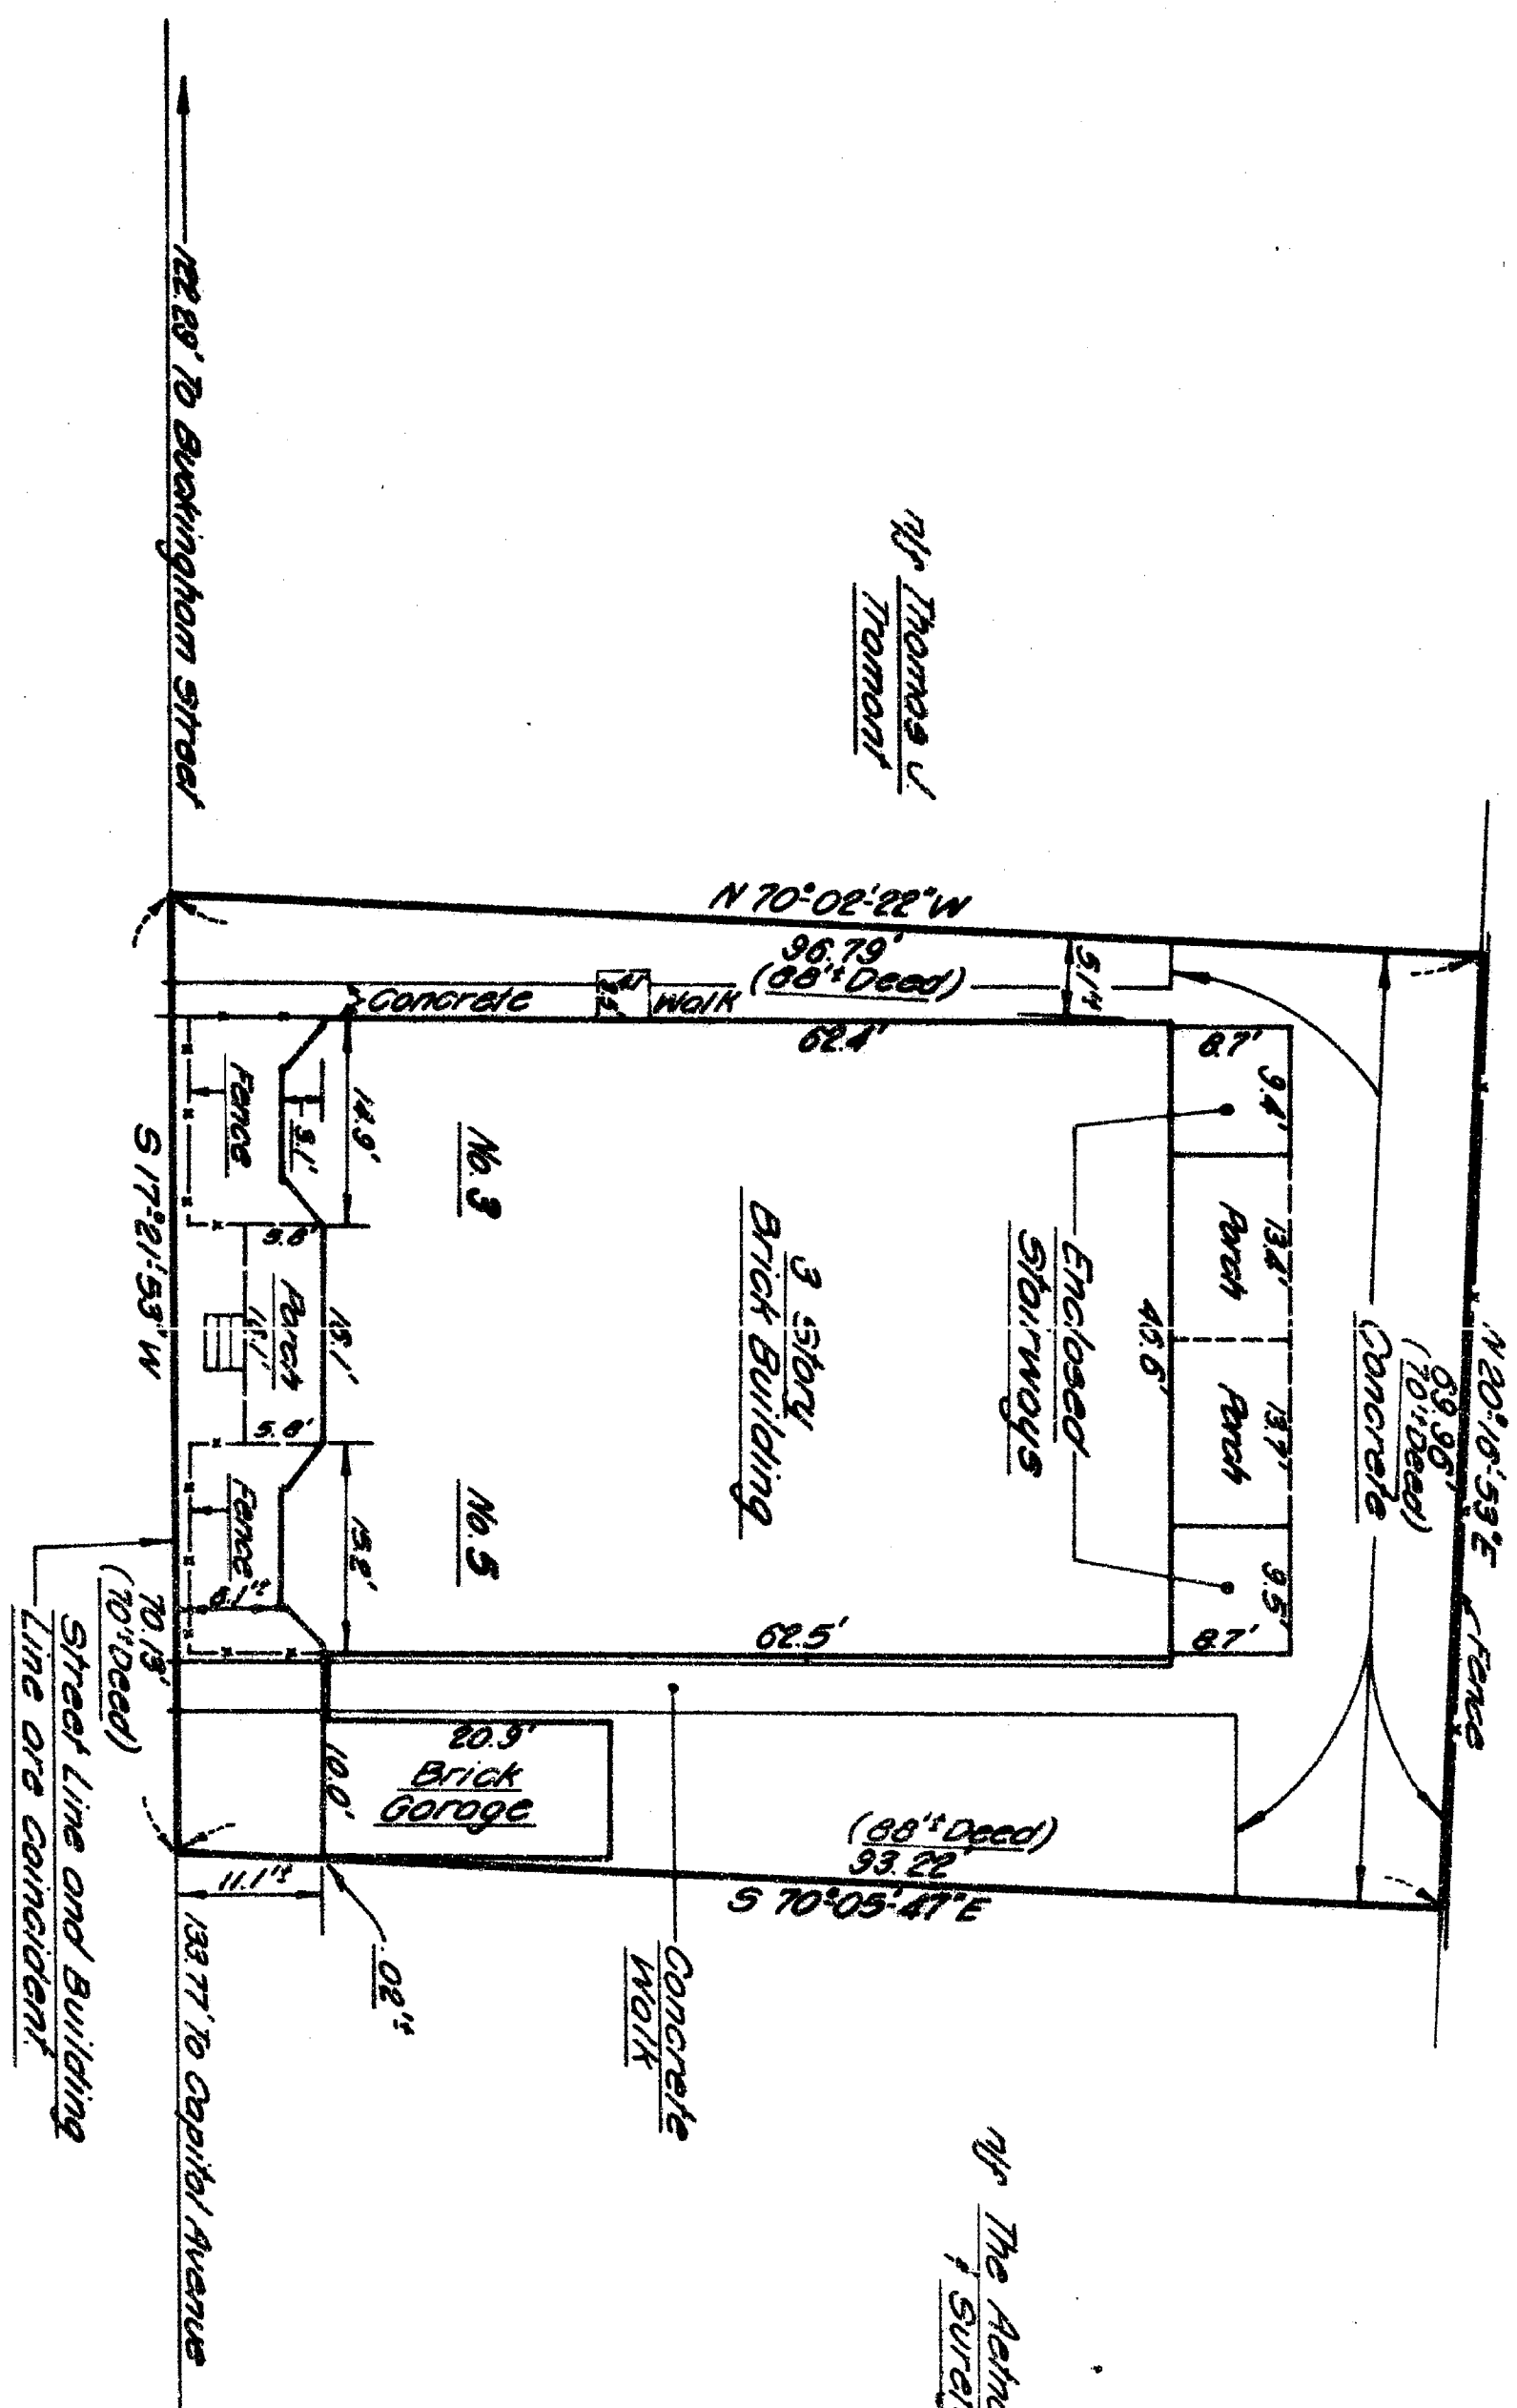


Whitman Court

Thomas J. Tramont,
Surveyor, Title Insurance Company,
I hereby certify to
that this survey was actually made upon the ground on 11/28/84, and
that it and the bounds and measurements shown hereon are correct
within the standards of a Class A.S. survey as defined in the Code
of Practice for Standards of Accuracy of Surveys and Maps, adopted
December 10, 1973, and as amended by the Connecticut Association of
Land Surveyors, Inc., and that, unless otherwise shown, deed lines
as shown and do not encroach over or upon street, dead or building
lines, there are no violations of zoning regulations with reference
to the location of said buildings, and there are no assessments or
encroachments affecting this property apparent from a careful in-
spection of the same, other than those noted and depicted hereon.

CLOSE, JENSEN & MILLER
Civil Engineers & Surveyors

Property is located in an R-1 zone.
Building covers 44% of lot.
Lot Area - 6891.37 sq. ft. or .15 Ac.
Side and Rear Yards, Percentages
Building coverage when conforming
Building built prior to zoning.

No.	Date	Description
1	11/28/84	Change Ord. Amend. Tract. Plan Title

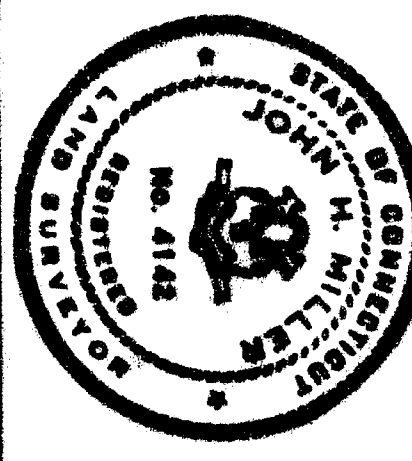

Close, Jensen & Miller
Consulting Engineers, Land Planners & Surveyors
449 Silas Deane Highway, Wethersfield, Connecticut 06109

Designed	Drawn	Checked	Scale	Date
R.S.A.	R.S.A.	V.H.M.	1"=20'	Nov. 1984
Sheet No.	One	or One	Job No.	3819
File No.				

Property of
Thomas J. Tramont
3-5 Whitman Court
Hartford, Connecticut

1384

