

1385

1385-2

07022

RECEIVED BY

DEC 17 9 53 AM '84

TOWN & CITY CLERK
HARTFORD

VOL _____ PAGE _____

N/F
363 Hudson Associates
Limited PartnershipN/F
363 Hudson Associates
Limited PartnershipN/F
363 Hudson Associates
Limited PartnershipThe portion of Wadsworth St. shown on
this plan is an established public street
of the City of Hartford12/20/84
Date
City Engineer

PROPERTY OF

36 WADSWORTH ASSOCIATES LIMITED
PARTNERSHIP

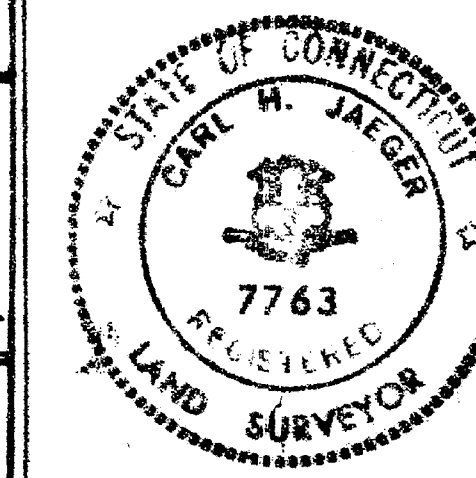
36 WADSWORTH STREET

TOWN OF Hartford Connecticut

I HEREBY CERTIFY TO 36 WADSWORTH
ASSOCIATES LIMITED PARTNERSHIP A
Commonwealth Land Title Insurance Company
THAT THIS MAP & SURVEY WERE PREPARED IN
ACCORDANCE WITH THE STANDARDS OF CLASS A2
SURVEY AS DEFINED IN THE CODE OF PRACTICE FOR
STANDARDS AND ACCURACY OF SURVEY & MAPS
ADOPTED DECEMBER 10, 1975 AS AMENDED BY
THE CONN. ASSOCIATION OF LAND SURVEYORS.
INC. No Zoning Violations House

erected prior to present regulations
LEFT SIDE YARD NON-CONFORMING

ALCA SURVEY ASSOCIATES

CARL H. JAEGER L.S. 7763
WETHERSFIELD, CONN.SCALE: 1" = 20' SHEET
DATE: 12-11-84 1 OF 1

PLAN SIZE: 12" x 18"

