


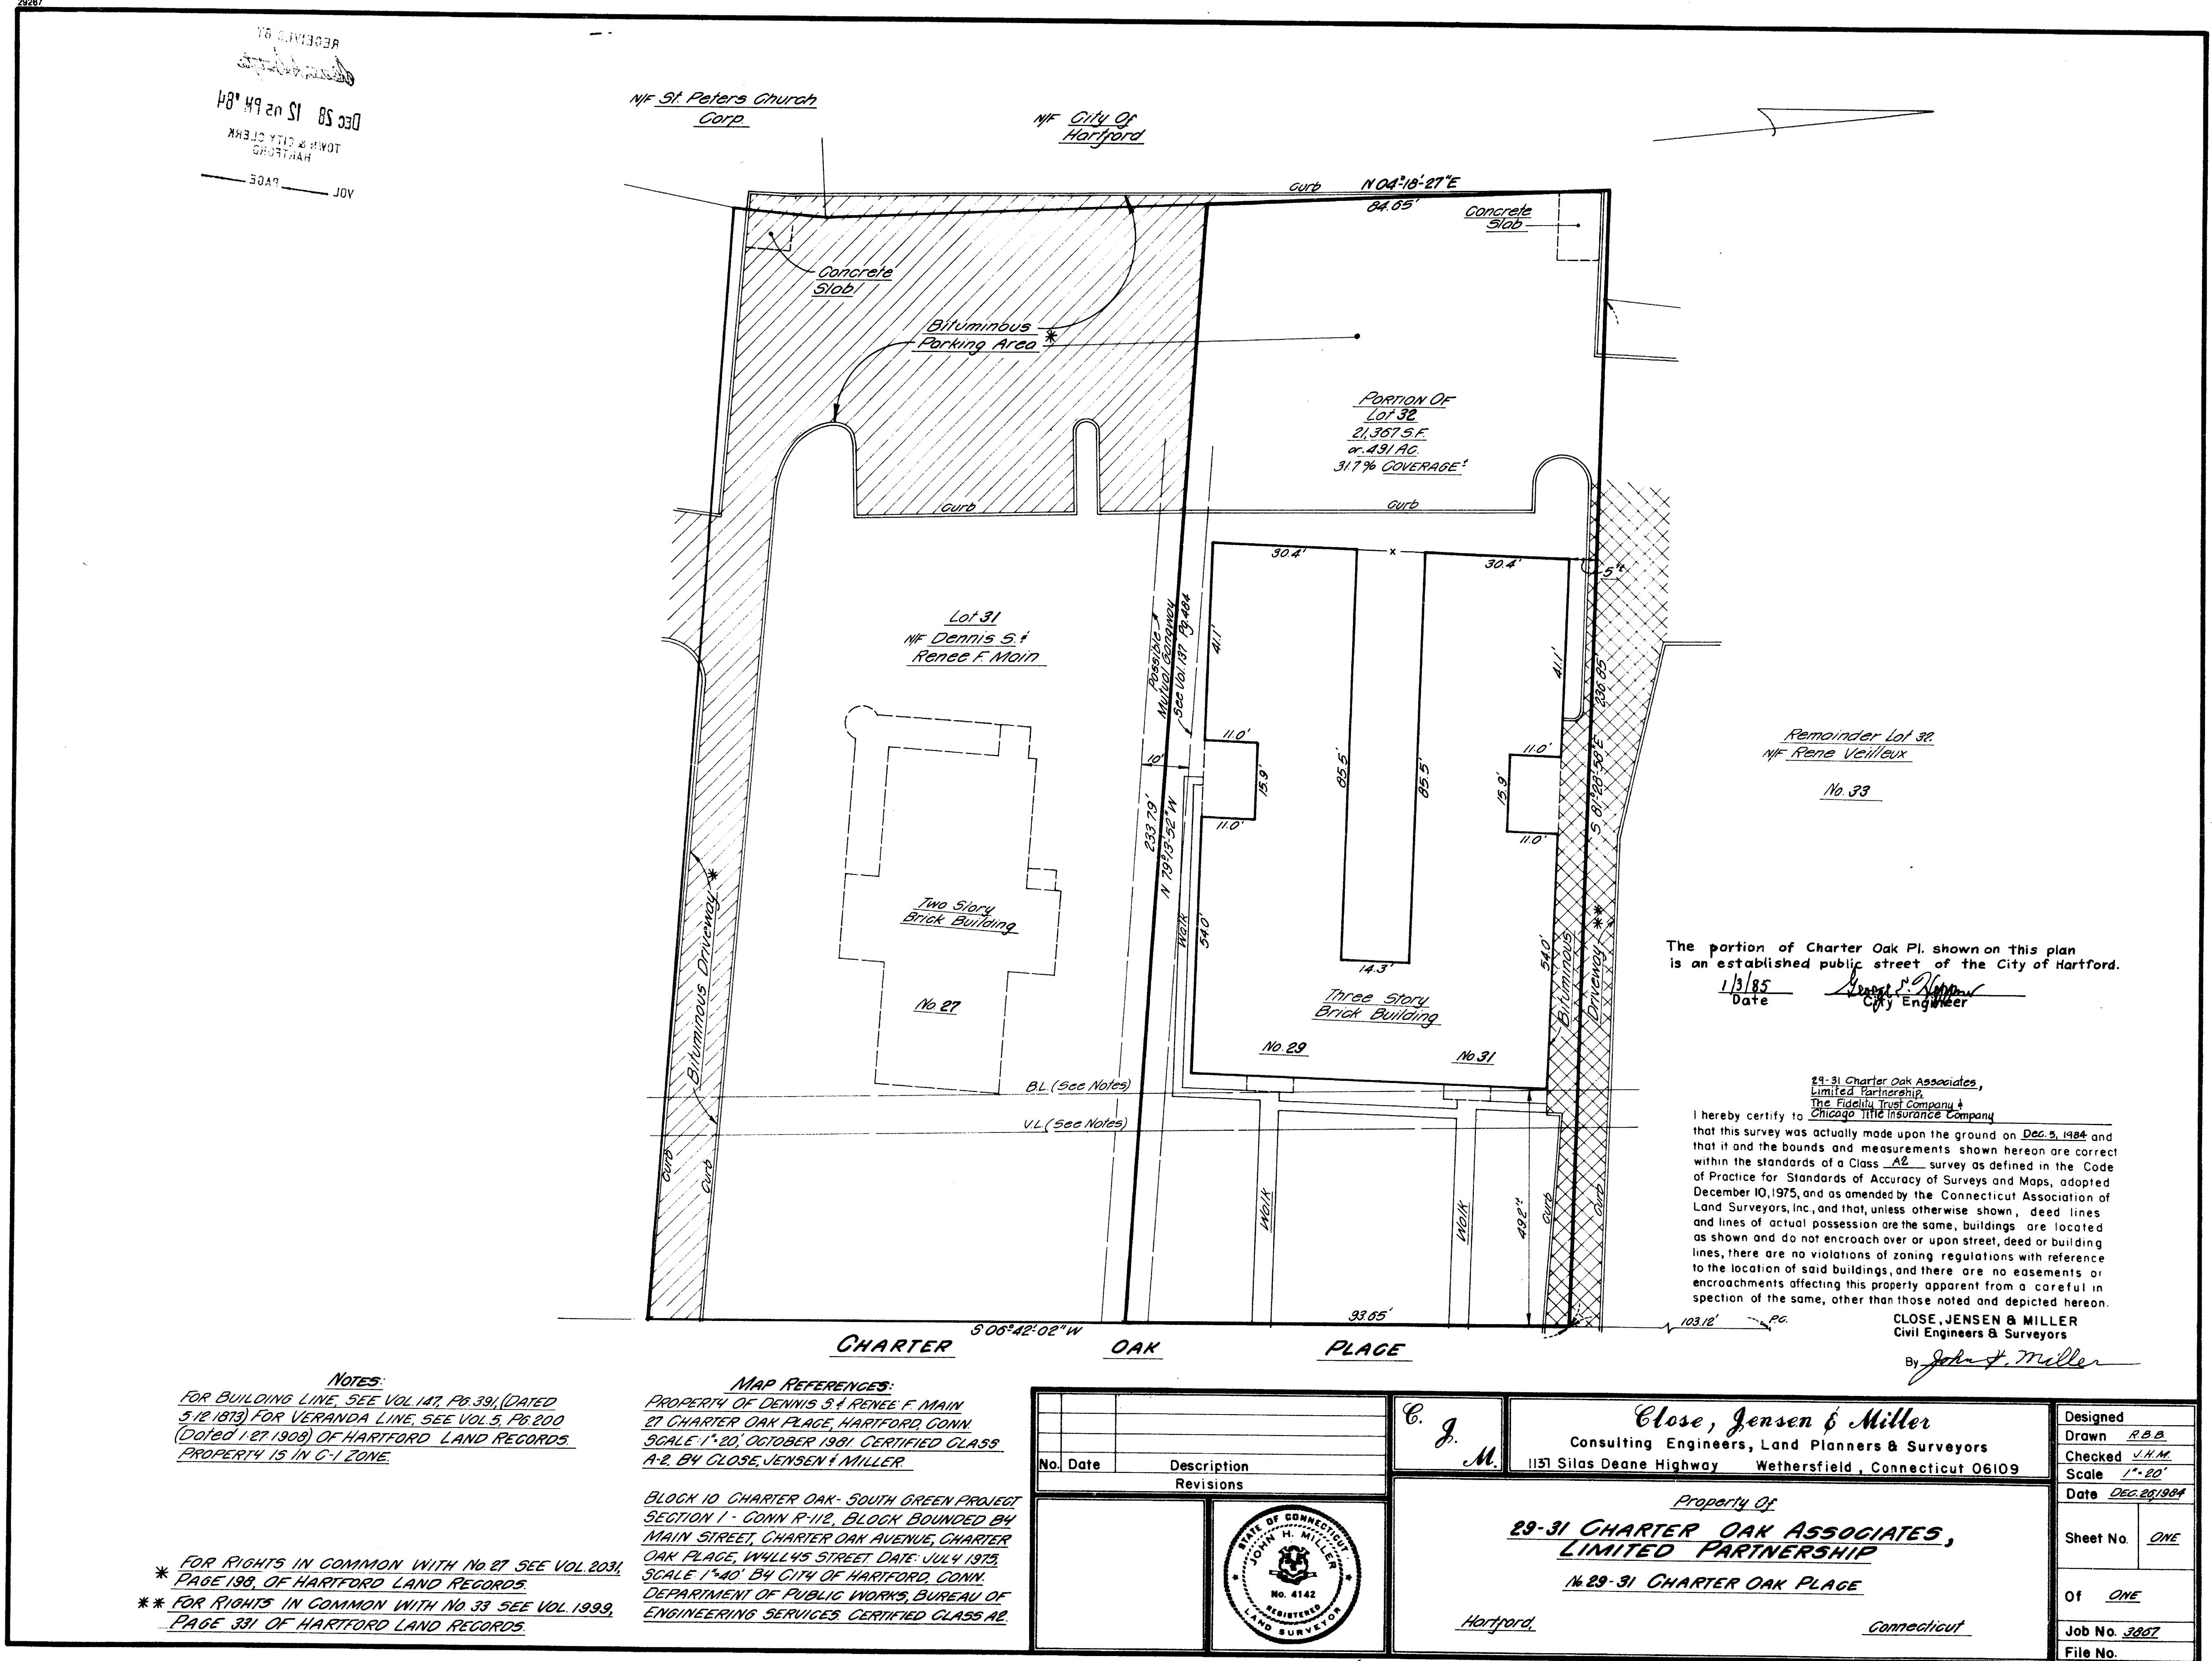

61 1390

