


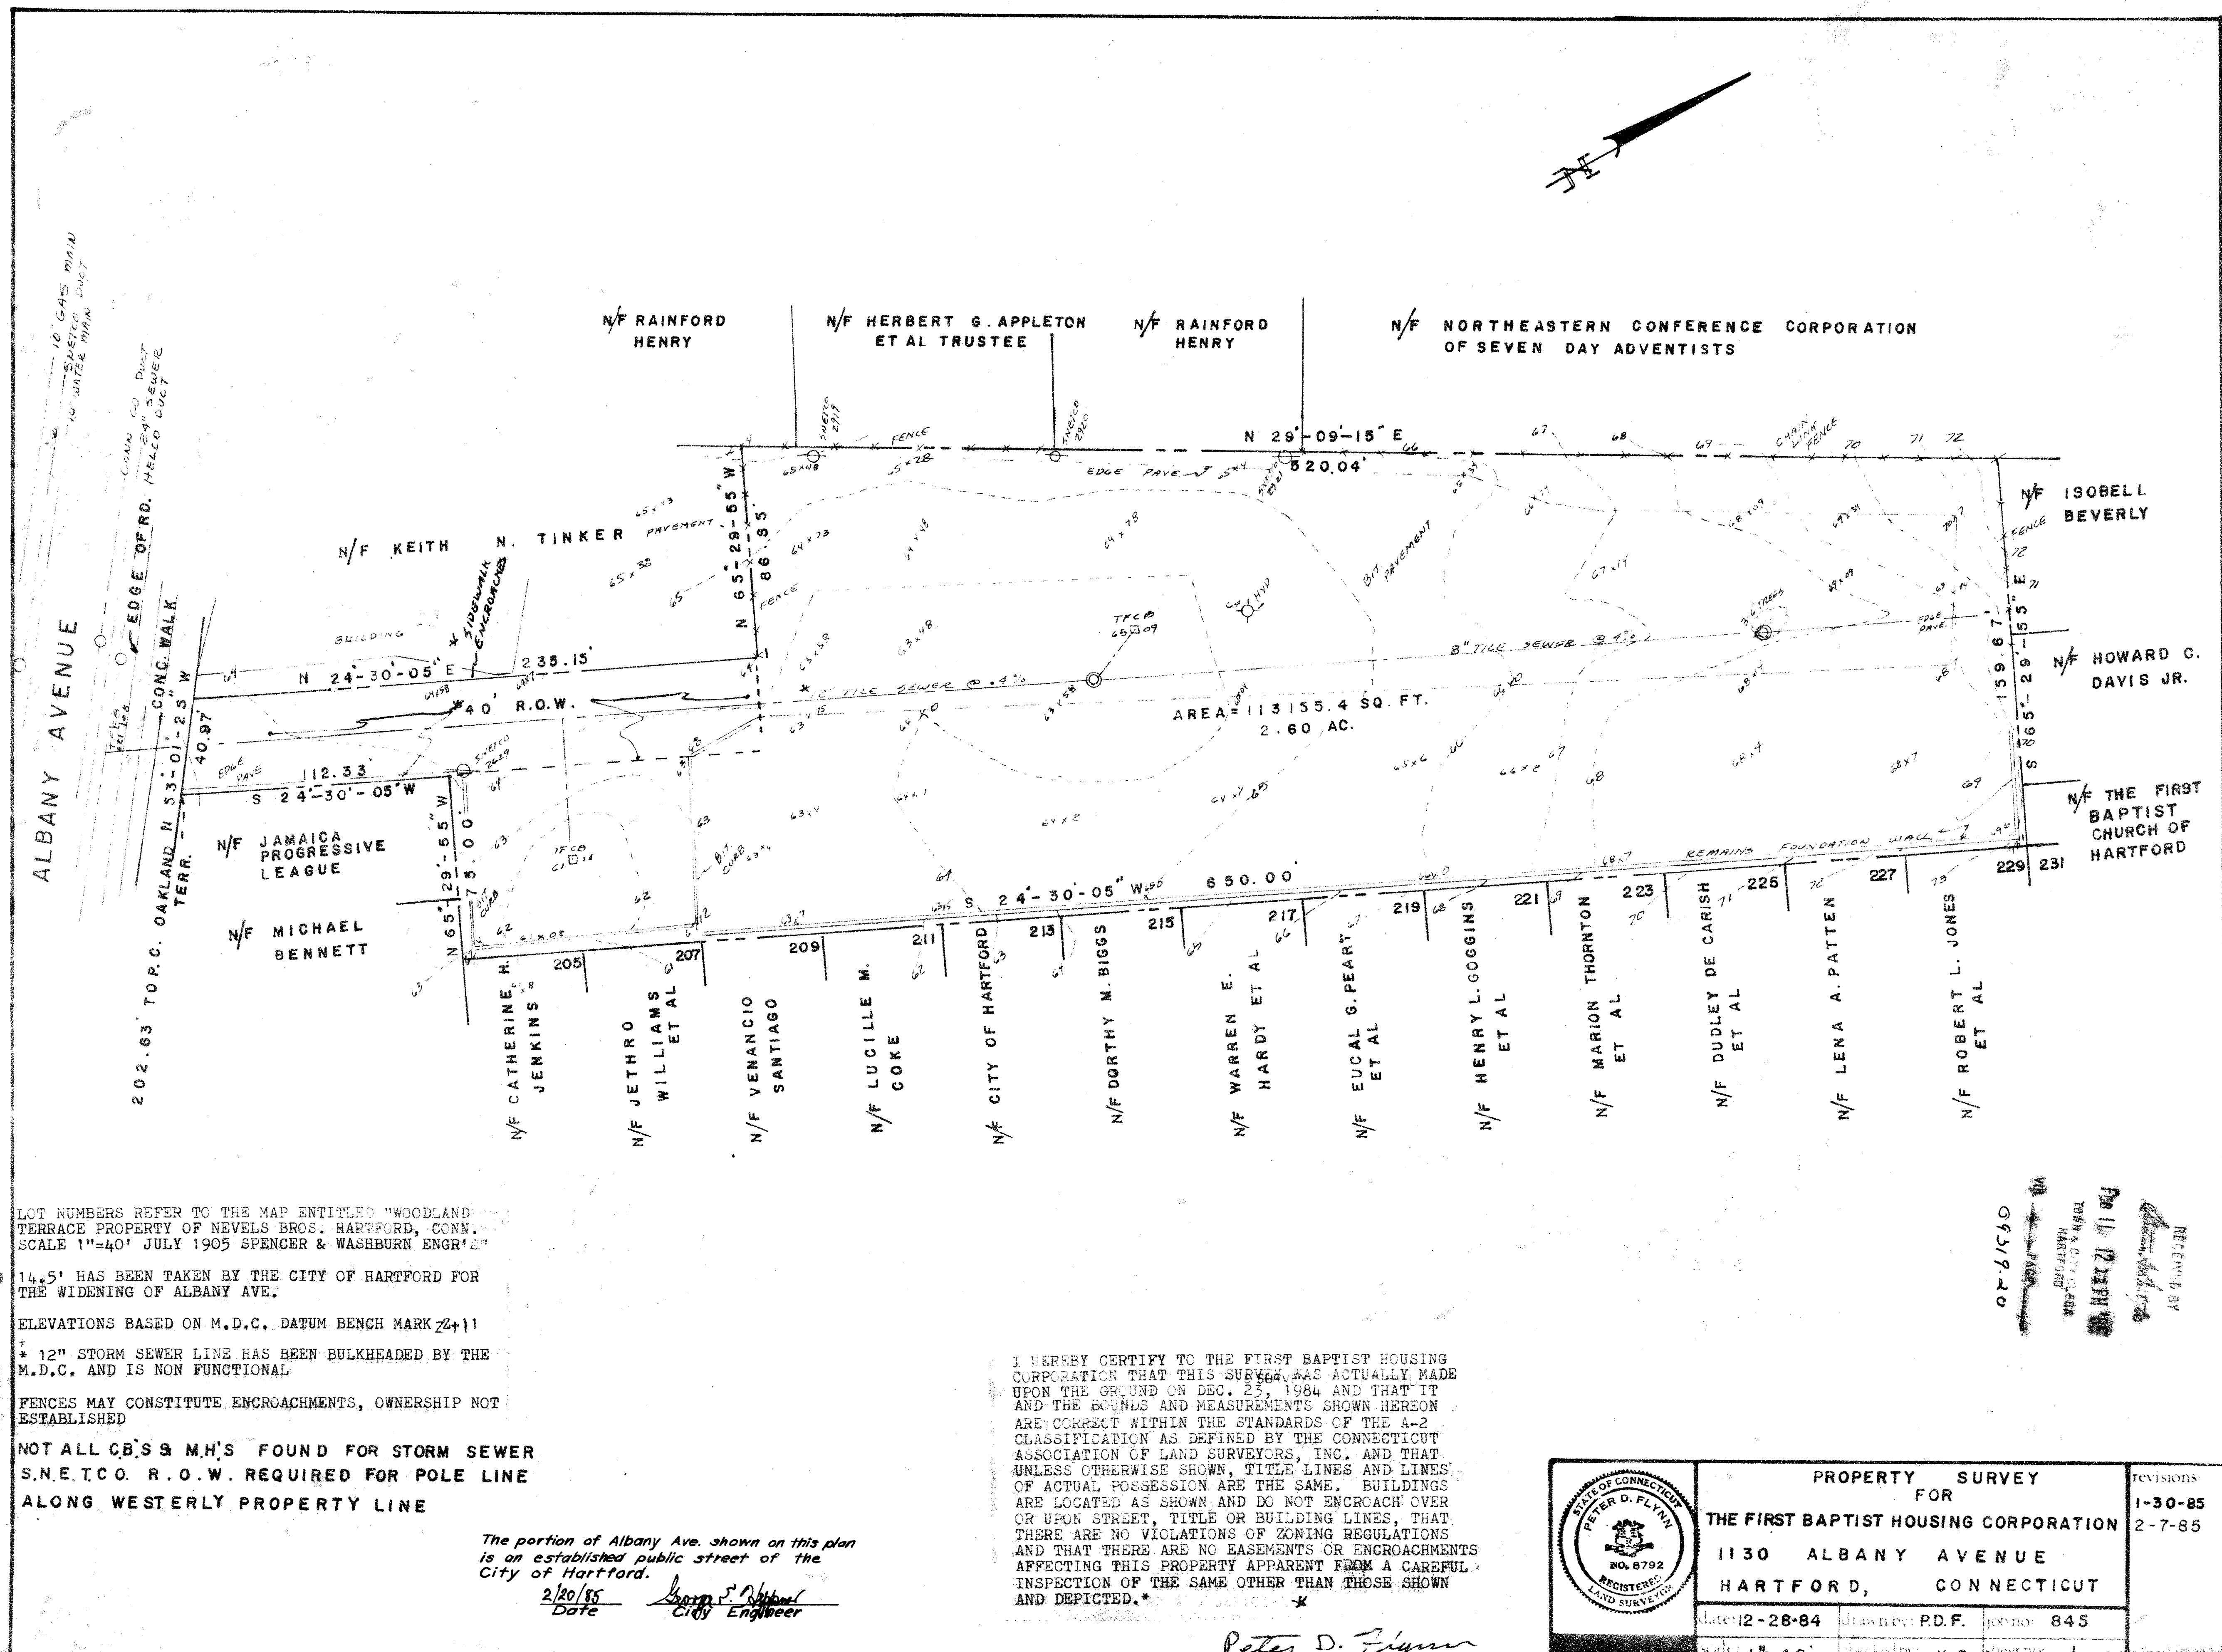

	PROPERTY SURVEY FOR		REVISIONS
	THE FIRST BAPTIST HOUSING CORPORATION		1-30-85
	1130 ALBANY AVENUE		2-7-85
	HARTFORD, CONNECTICUT		
DATE: 12-28-84	DRAWN BY: P.D.F.	PROJECT: 845	
SCALE: 1"=40'	CHECKED BY: K.C.	SHEET: 1	

