



08861
 RECEIVED BY
 JUN 30 1 46 PM '85
 TOWN ENGINEER
 HARTFORD
 VDL PAGE

THIS SKETCH WAS COMPILED FROM A PRINT ENTITLED
 "ALFORD ASSOCIATES CIVIL ENGINEERS WINDSOR, CONNECTICUT
 PREPARED FOR HENRY KARLINER SITE PLAN NORTHEAST
 CORNER PARK ST & PROSPECT AVE. HARTFORD, CONN.
 SHEET 1 OF 1 SCALE: 1 IN = 20 FT DATE: JULY 7, 1983"

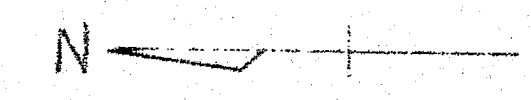

THE PORTIONS OF PROSPECT AVE.
 AND PARK ST. SHOWN ON THIS
 PLAN ARE ESTABLISHED PUBLIC
 STREETS OF THE CITY OF
 HARTFORD, CONNECTICUT.
 David W. Smith

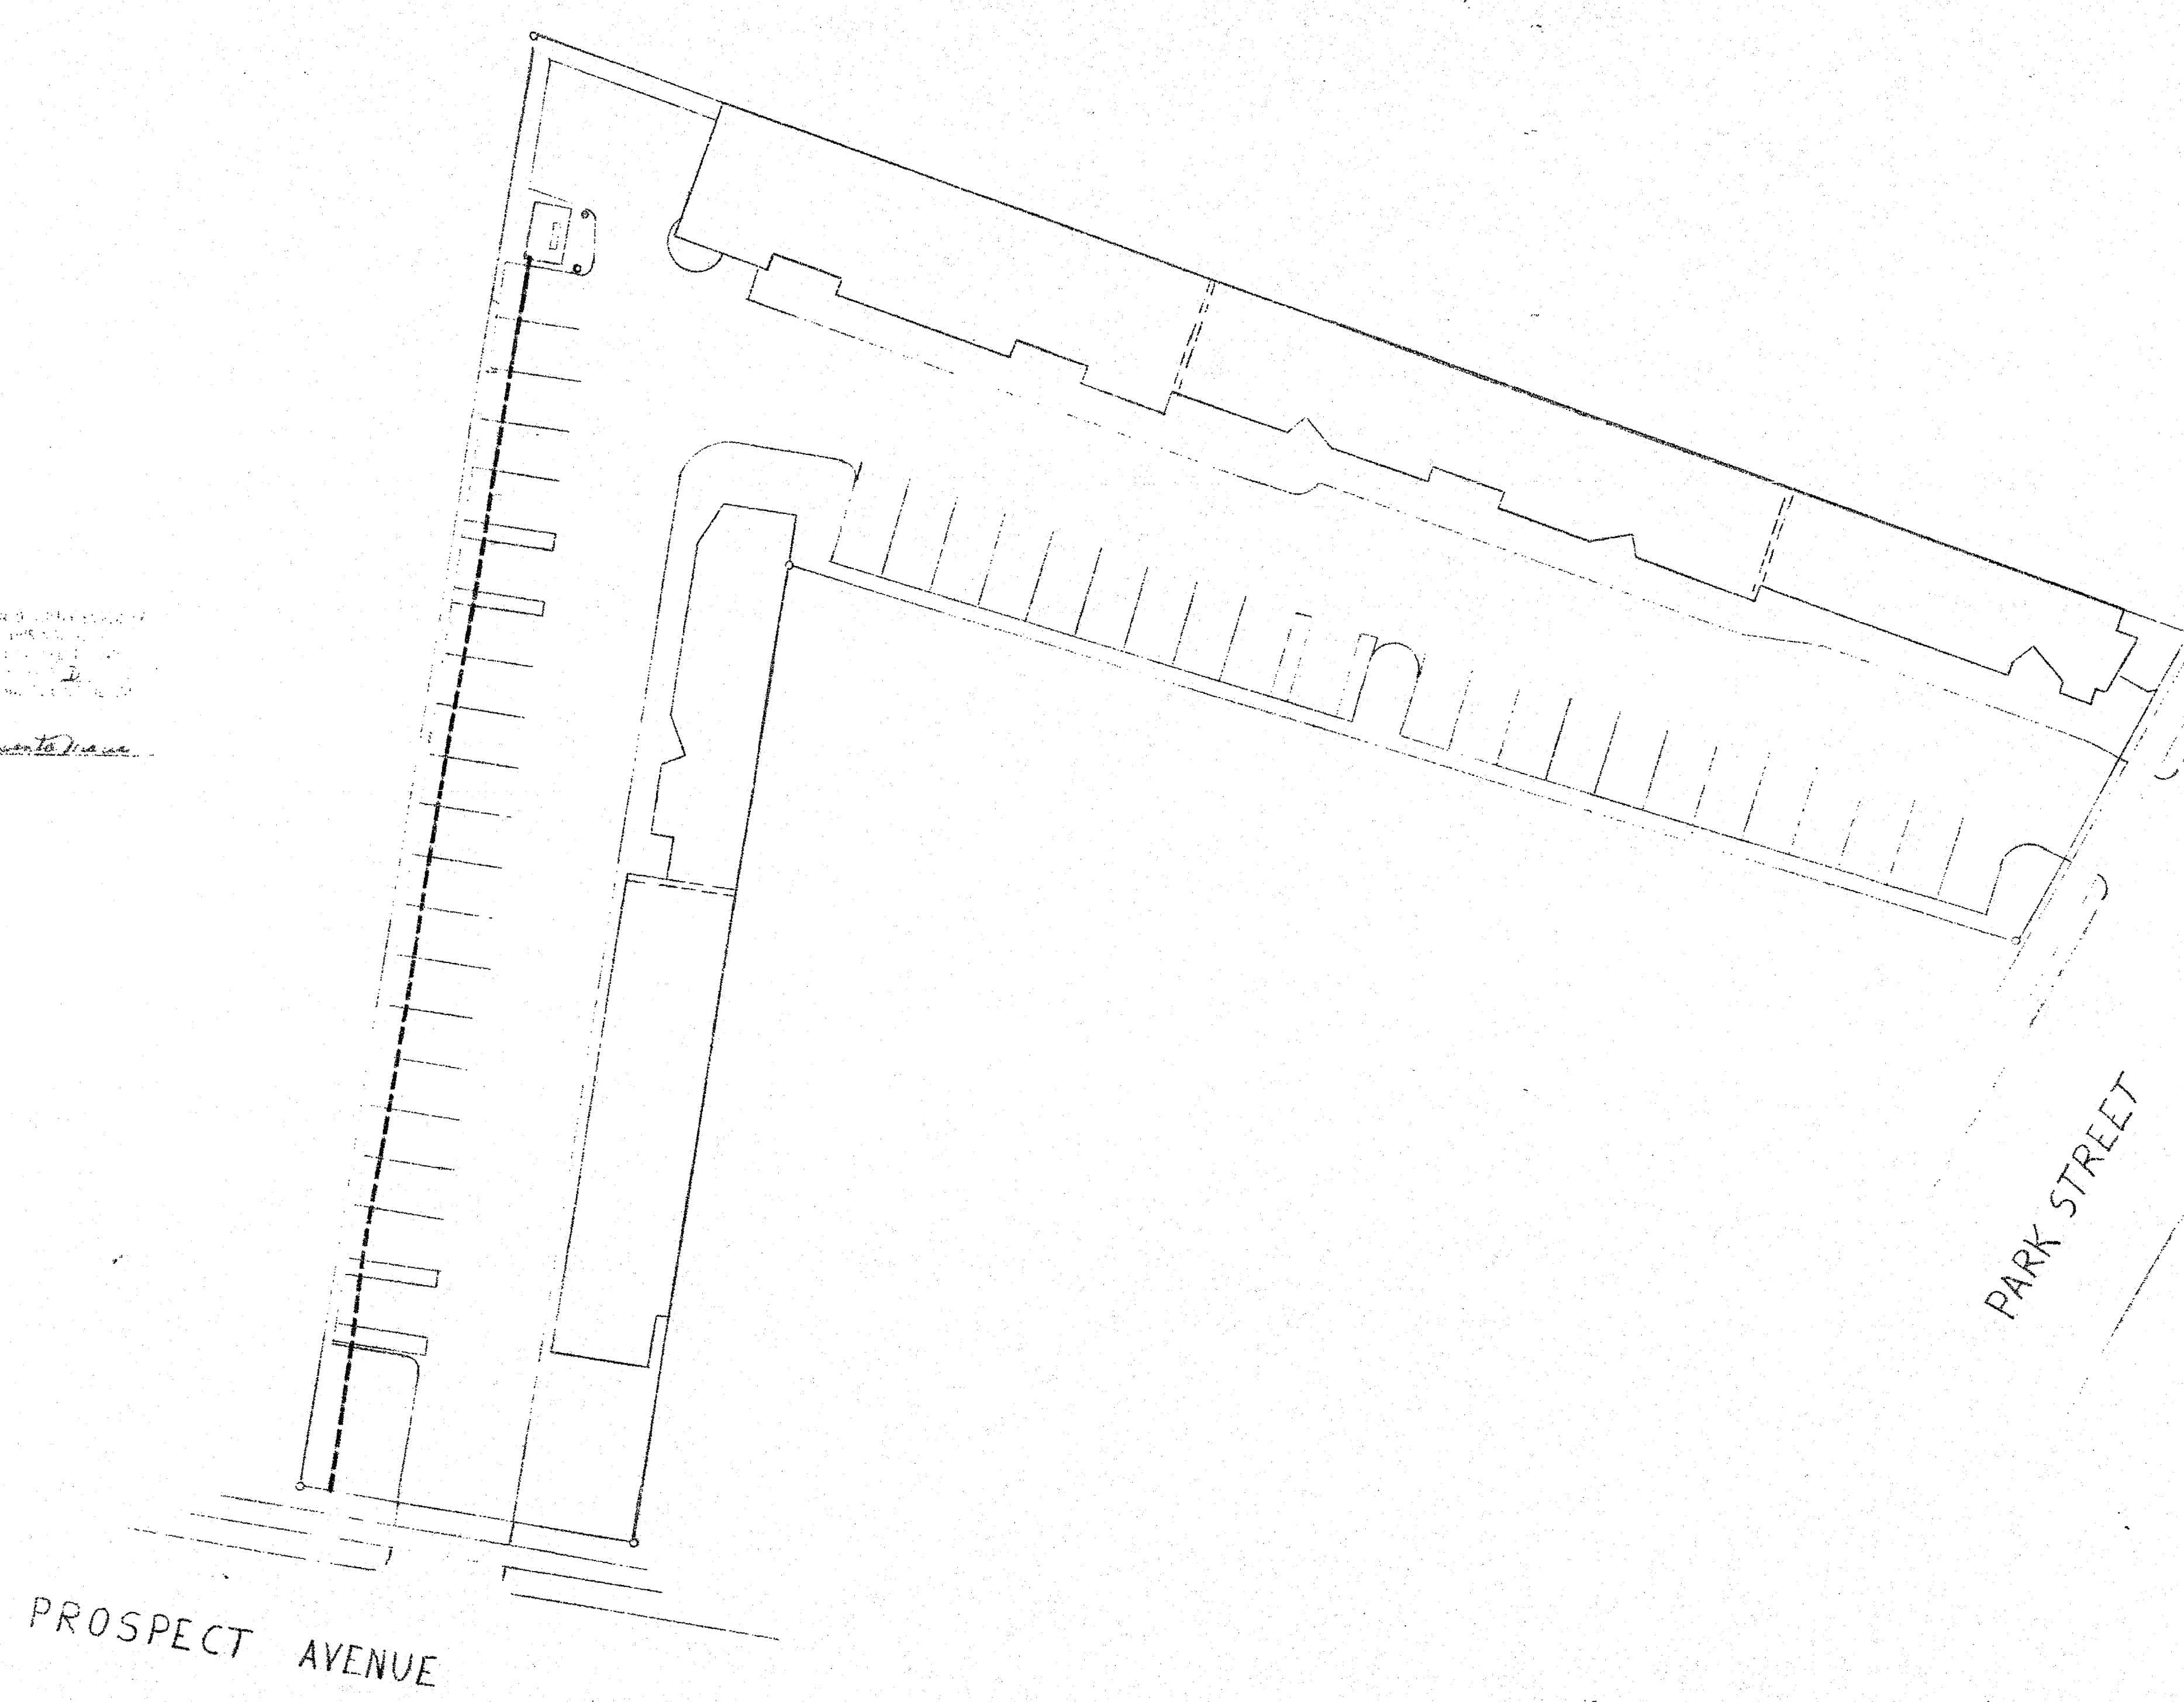

- LEGEND
- [] TRANSFORMER PAD
 - CENTER LINE TRENCH
 - o BUMPER GUARDS

The portions of Prospect Ave. and Park St. shown
 on this plan are established public streets of
 the City of Hartford.
 Date 2/1/85 City Engineer

THE CONNECTICUT LIGHT AND POWER COMPANY
 FACILITIES ON THE PROPERTY OF
 HENRY KARLINER, PROSPECT AVENUE
 HARTFORD, CONNECTICUT
 MAP NO. E-C-705E8-1391 SCALE 1 IN = 20 FT
 DATE 11-16-84

DRWN BY DSM
 CHKD BY SKR
 APPD BY PGO

1041
 1041
 1041

